COUNTY SURVEYORS FILE DATA
DO NOT REMOVE FROM OFFICE

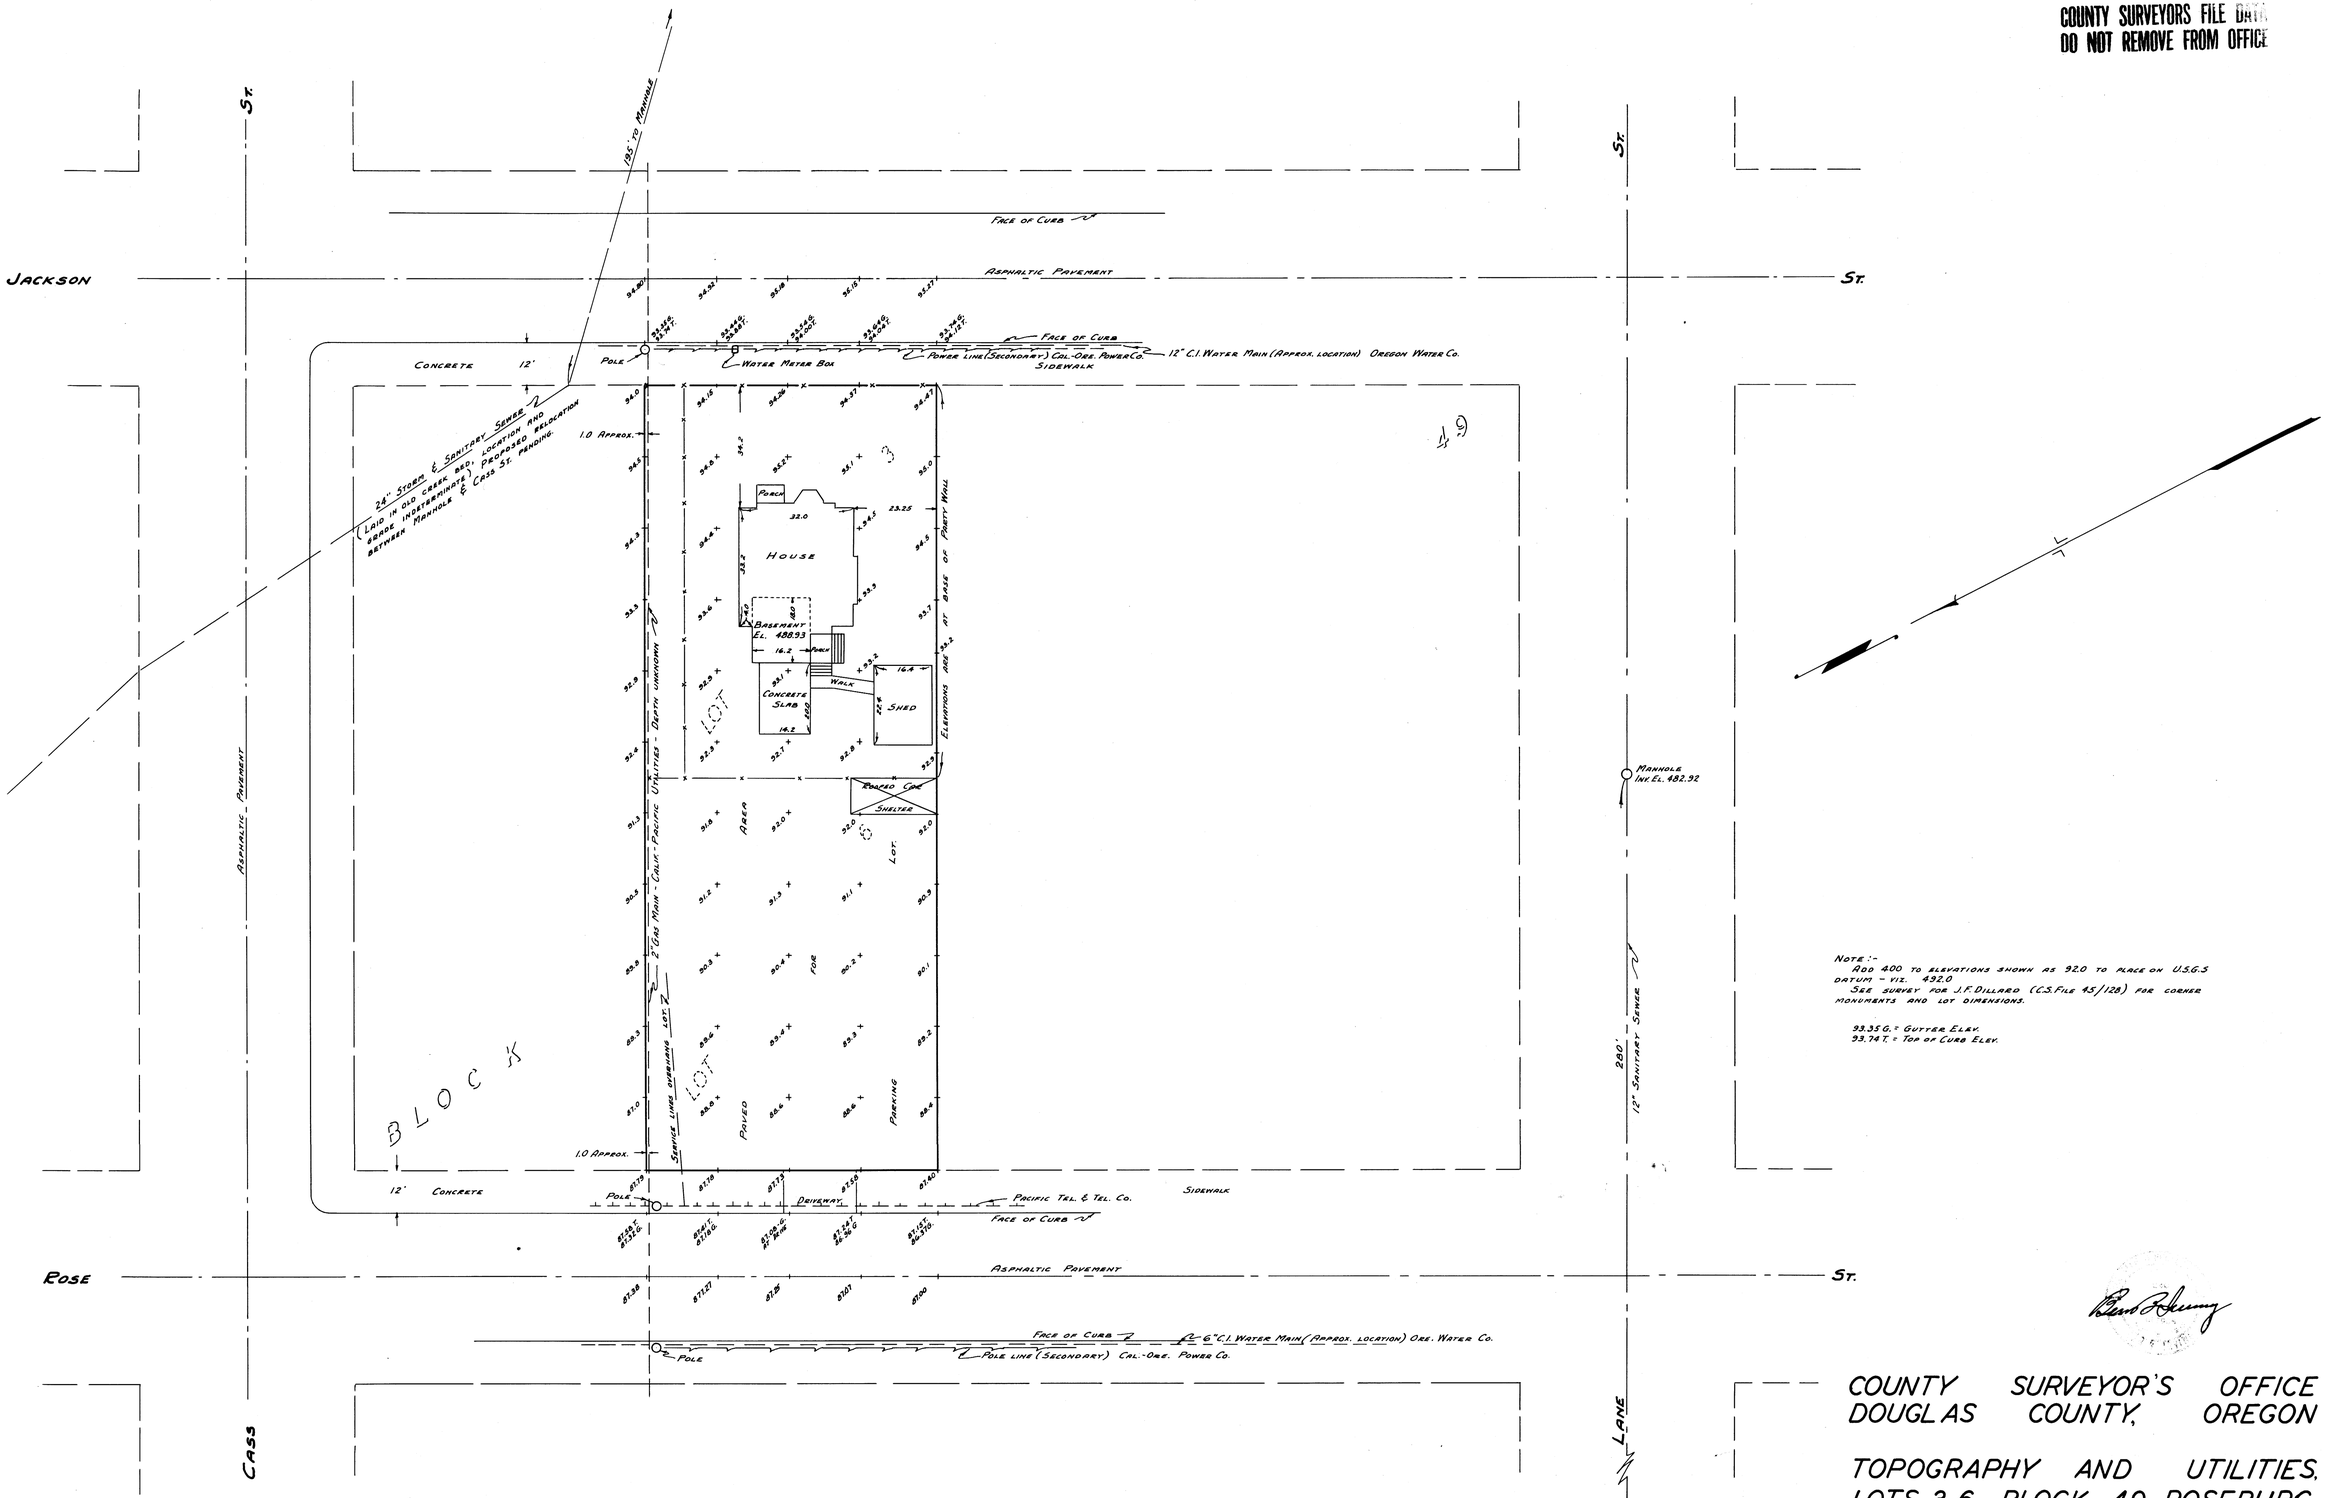

NOTE:-
ADD 400 TO ELEVATIONS SHOWN AS 92.0 TO PLACE ON U.S.G.S DATUM - VIZ. 492.0
SEE SURVEY FOR J.F. DILLARD (C.S. FILE 45/128) FOR CORNER MONUMENTS AND LOT DIMENSIONS.

93.35 G. = GUTTER ELEV.
93.74 T. = TOP OF CURB ELEV.

COUNTY SURVEYOR'S OFFICE
DOUGLAS COUNTY, OREGON

TOPOGRAPHY AND UTILITIES,
LOTS 3, 6, BLOCK 49, ROSEBURG,
OREGON.

BEN B. IRVING COUNTY SURVEYOR
SURVEYED MAY 15, 1953 SCALE 1" = 20'
SURVEYED FOR CHURCH, NEWBERRY, & ROEHR. ARCH.

C.S. FILE No. 45/128
C.S. FILE M8/-33 M8-38

COUNTY SURVEYORS FILE DATA
DO NOT REMOVE FROM OFFICE

MAP FILE M8-33

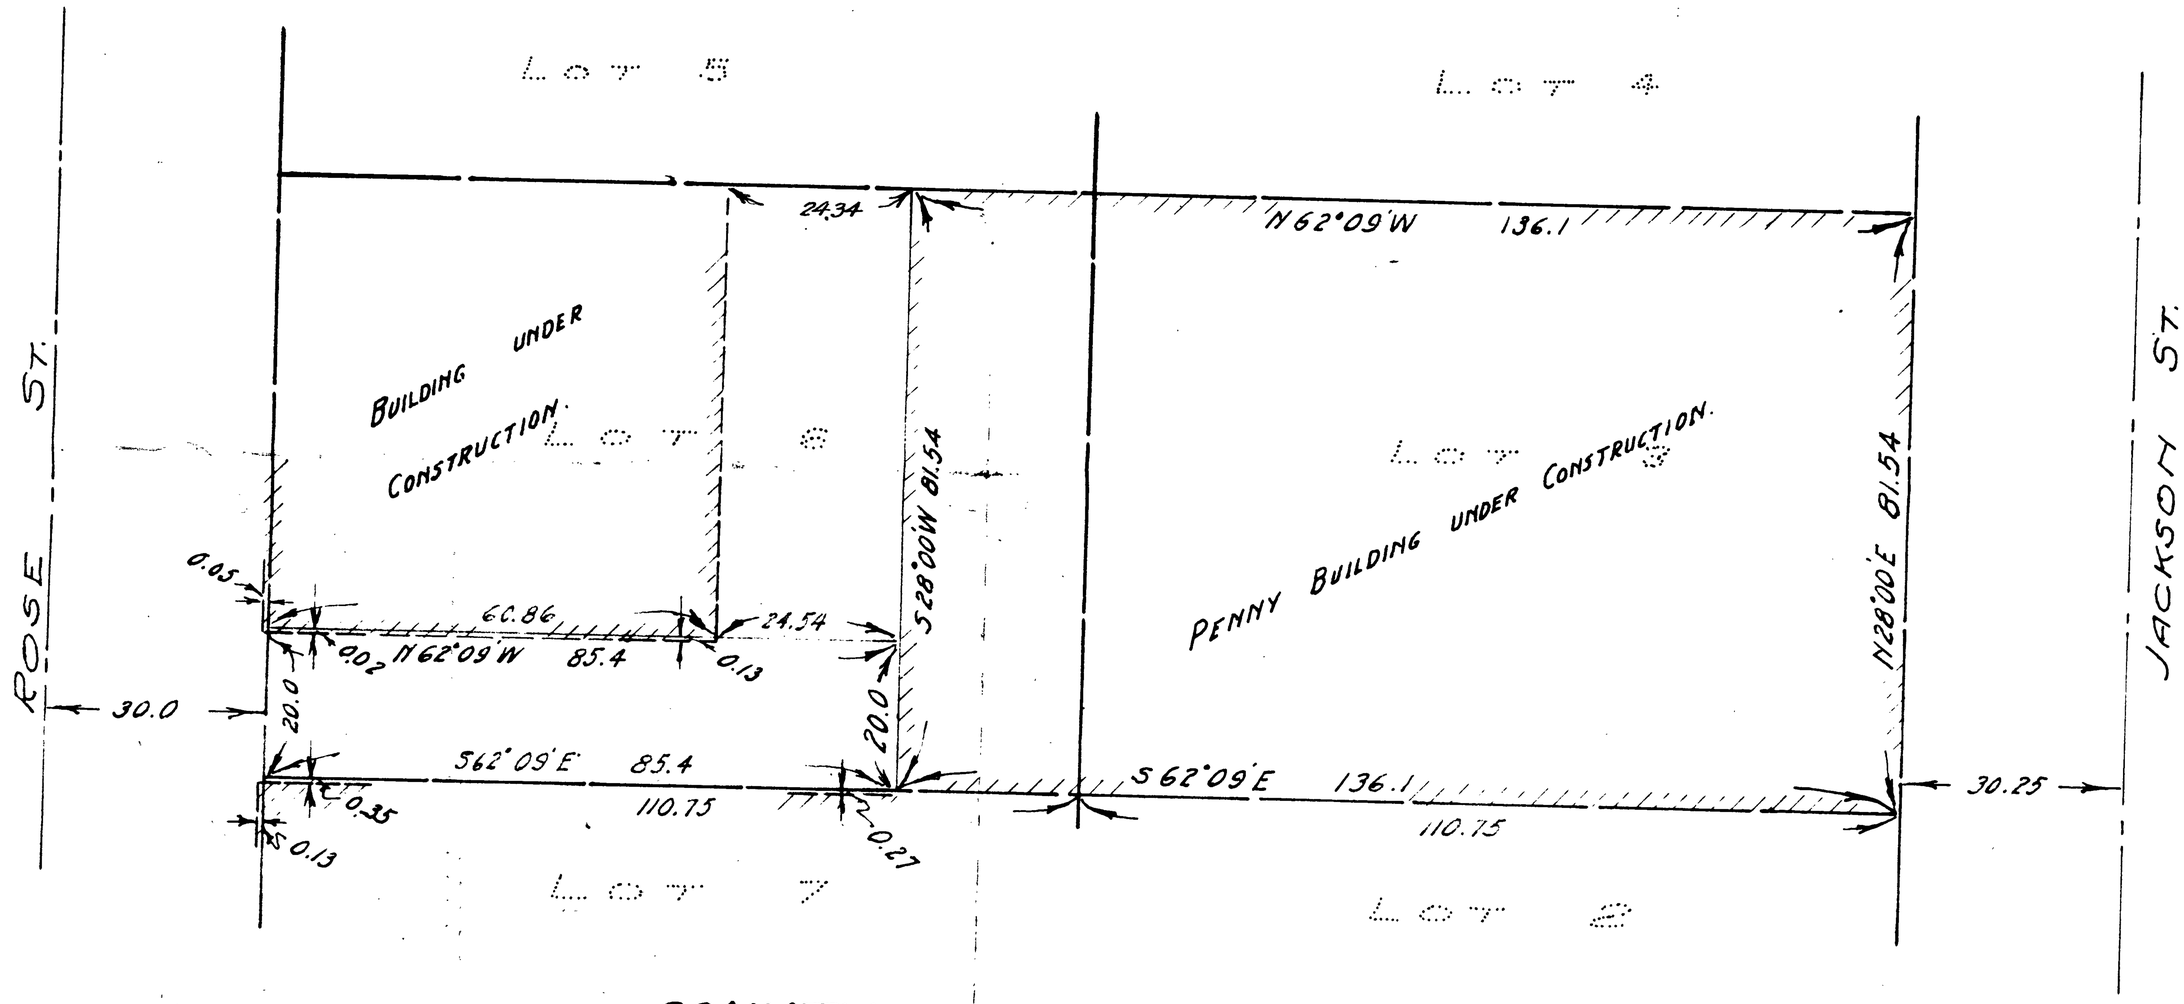

Certificate : I, Ben B. Irving, County Surveyor, Douglas County, Oregon, hereby certify that this map has been prepared from notes taken during a field survey made under my direction, April 17, 1954.

Ben B. Irving
County Surveyor

COUNTY SURVEYOR'S OFFICE
DOUGLAS COUNTY, OREGON

SURVEY FOR DEED DESCRIPTIONS
BLOCK 49, ROSEBURG, OREGON.

BEN B. IRVING COUNTY SURVEYOR
APRIL 17, 1954 SCALE 1" = 20'

CS FILE FOLDER

CONTAINS

MORE

INFORMATION