M8-37

COUNTY SURVEYORS FILE DATA
DO NOT REMOVE FROM OFFICE

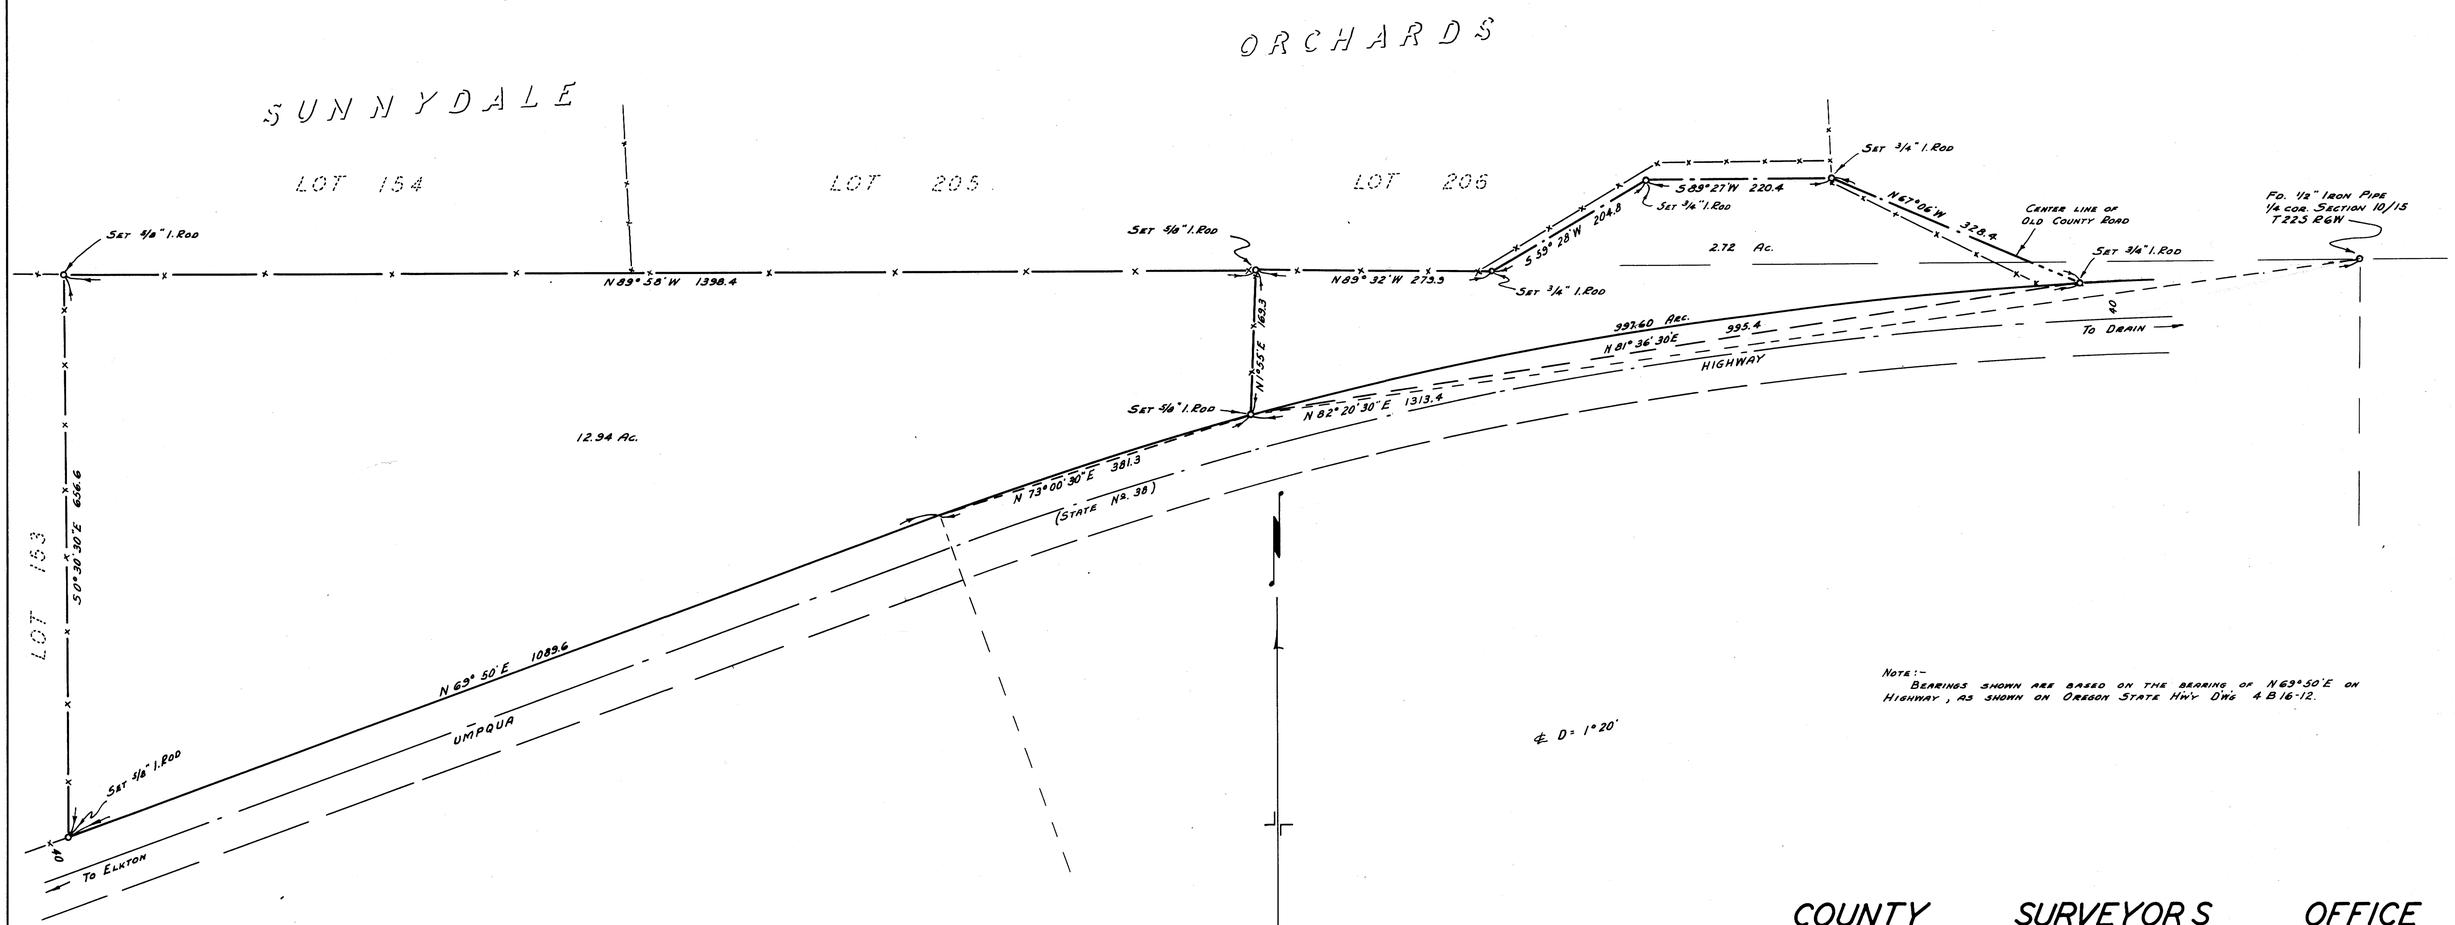

NOTE:- BEARINGS SHOWN ARE BASED ON THE BEARING OF N 69° 50' E ON HIGHWAY, AS SHOWN ON OREGON STATE HWY DWG 4B16-12.

COUNTY SURVEYOR'S OFFICE
DOUGLAS COUNTY OREGON

SURVEY FOR DEED DESCRIPTIONS
T22S.R6W.W.M.

BEN B. IRVING COUNTY SURVEYOR
SURVEYED FEB. MARCH 1954 SCALE 1" = 100'
SURVEYED FOR MAUD HEDRICK DEAVER

COUNTY SURVEYORS FILE DATA
DO NOT REMOVE FROM OFFICE

C.S. FILE 45/250
MAP FILE M8-37