COUNTY SURVEYORS FILE
DO NOT REMOVE FROM

MAP FILE M 8 - 69

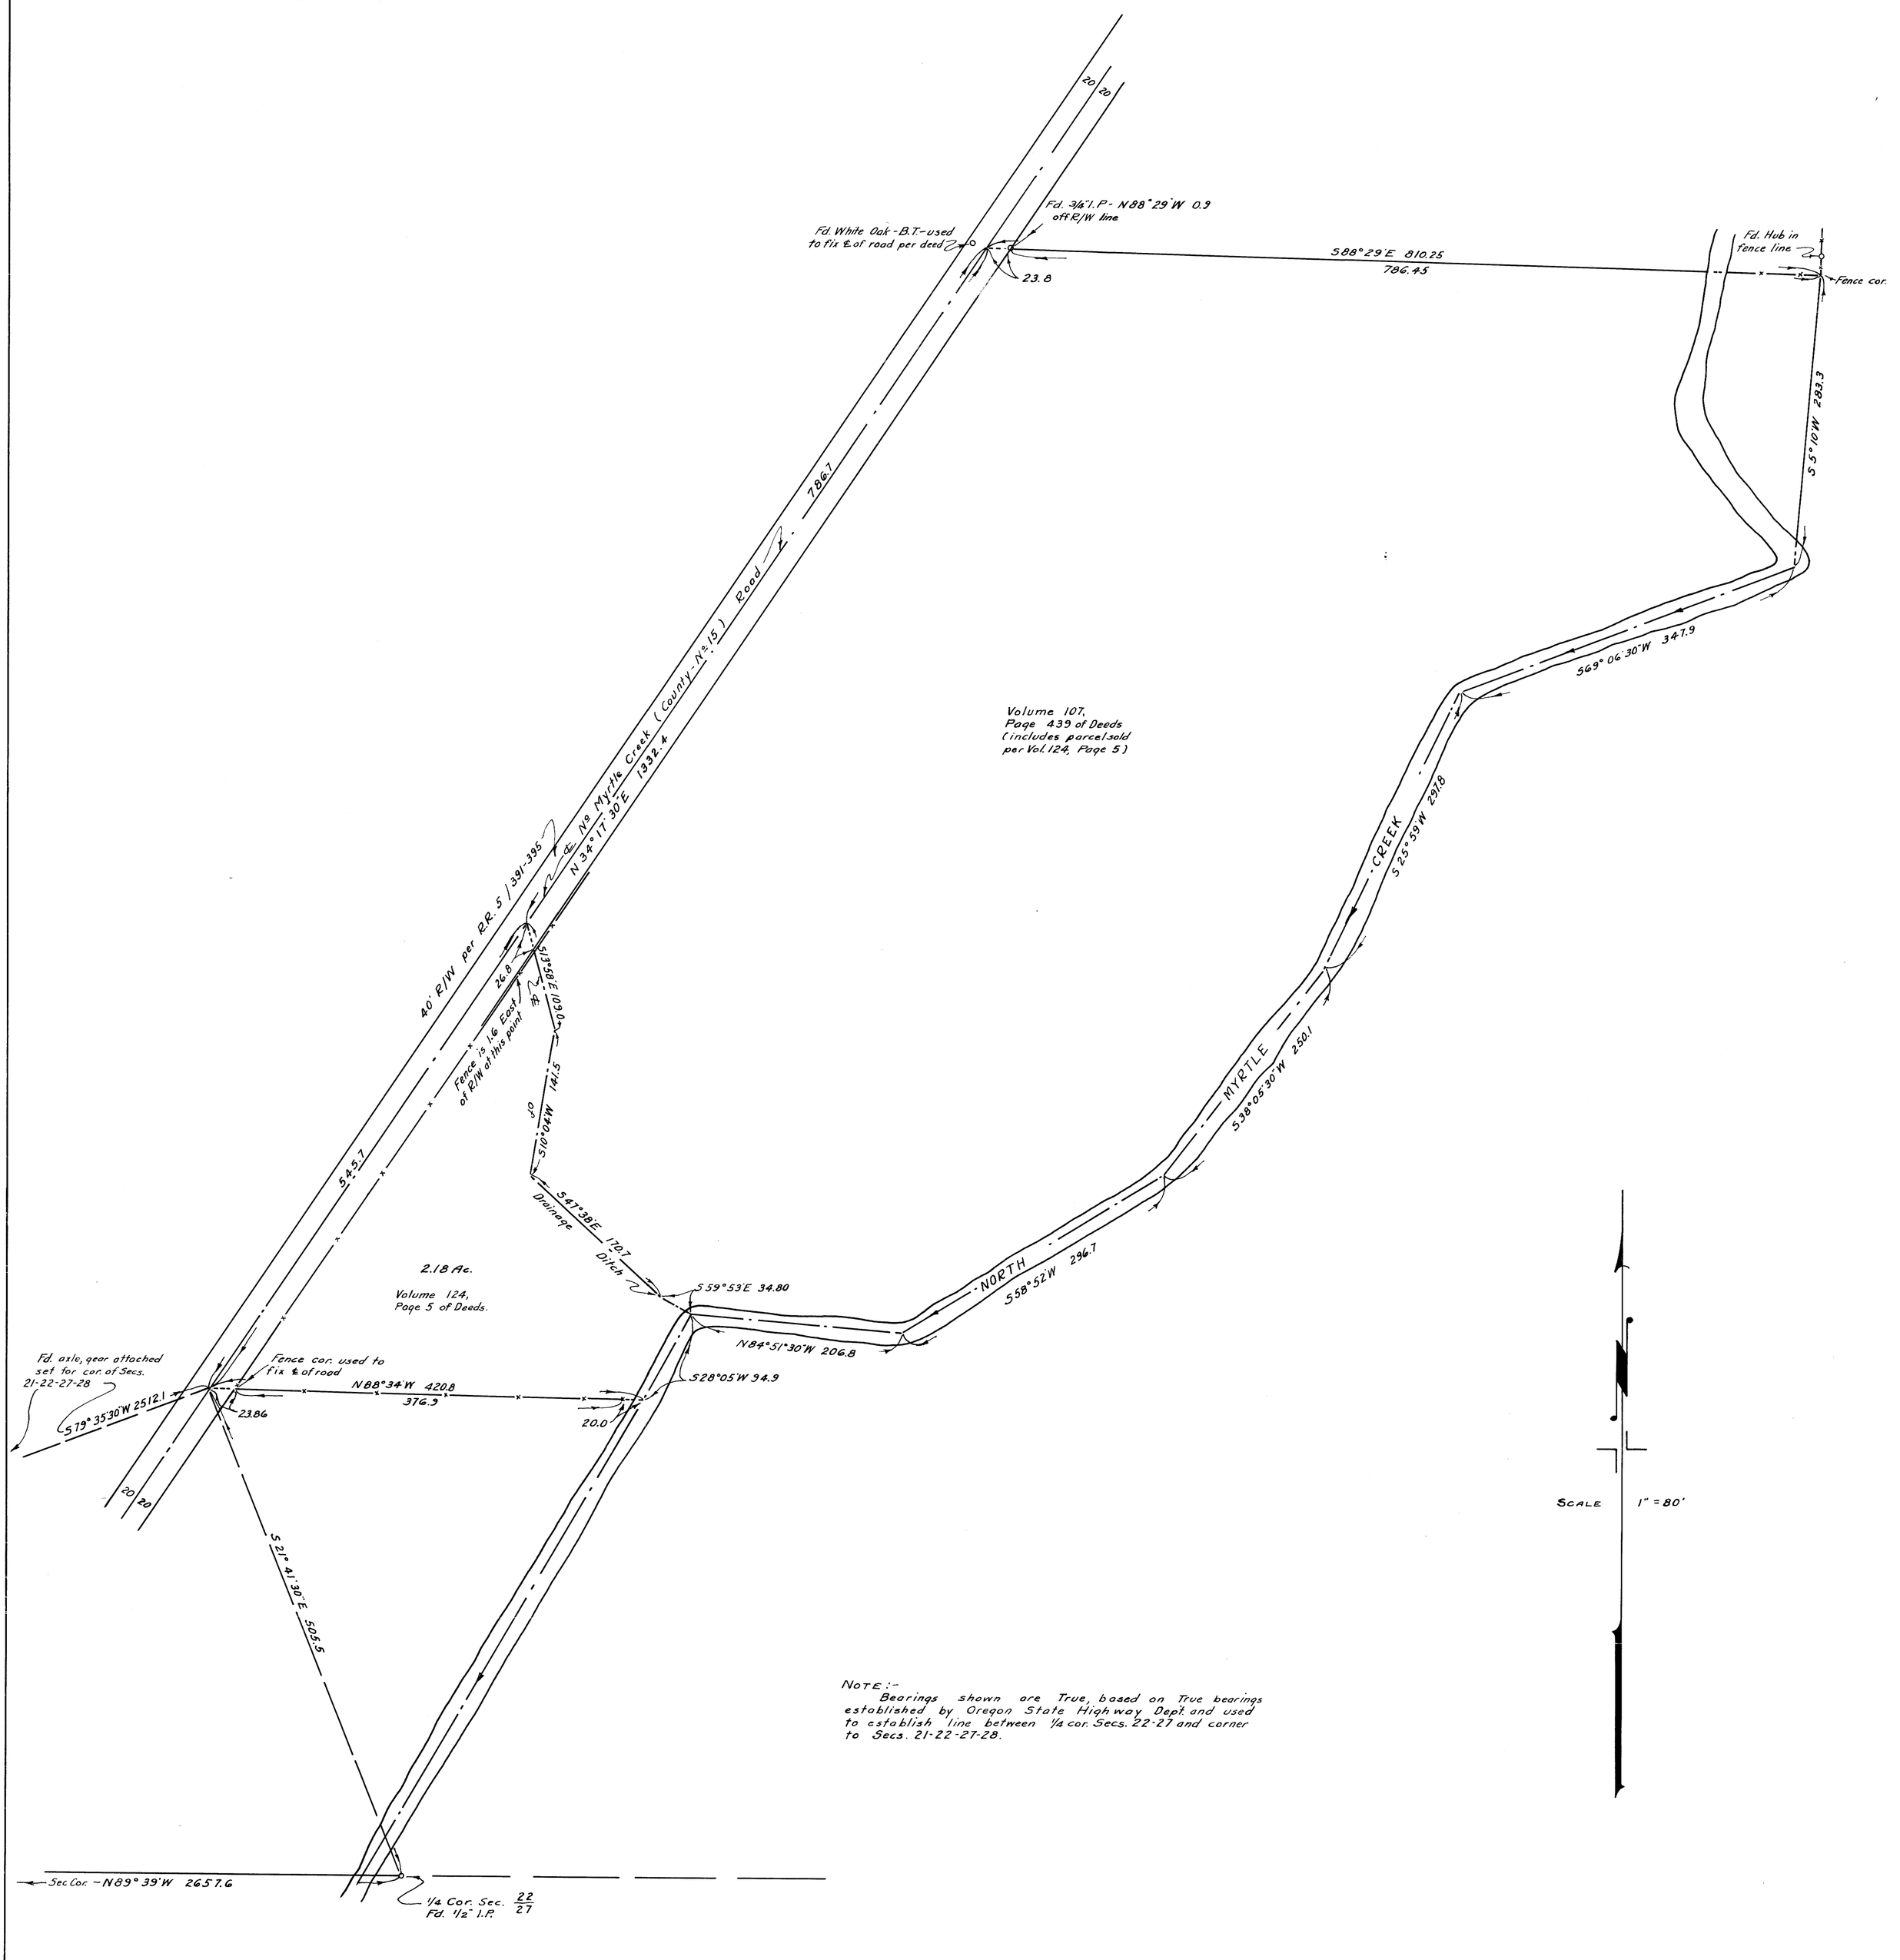

NOTE:-
Bearings shown are True, based on True bearings established by Oregon State Highway Dept. and used to establish line between 1/4 cor. Secs. 22-27 and corner to Secs. 21-22-27-28.

COUNTY SURVEYOR'S OFFICE
DOUGLAS COUNTY, OREGON

SURVEY TO CHECK DEED DESCRIPTIONS OF PARCELS IN SEC. 22, T29 S., R5 W., W.M.

BEN. B. IRVING — COUNTY SURVEYOR
SURVEYED DECEMBER 17-21 INCL., 1948 — BY
ARTHUR R. EVANS — DEPUTY

Arthur R. Evans

COUNTY SURVEYORS FILE
DO NOT REMOVE FROM

C.S. FILE No. 43/16
MAP FILE M 8-69