MAP FILE M 9 - 37
P

COUNTY SURVEYOR'S OFFICE
DO NOT REMOVE FROM FILE

# MAP

SHOWING LOCATION OF
RESIDENCE ON & BOUNDARIES OF
LOT 3 BLOCK 1 MULDER TRACTS
IN THE
COUNTY OF DOUGLAS
AND
STATE OF OREGON.

SURVEYED 4-23-54
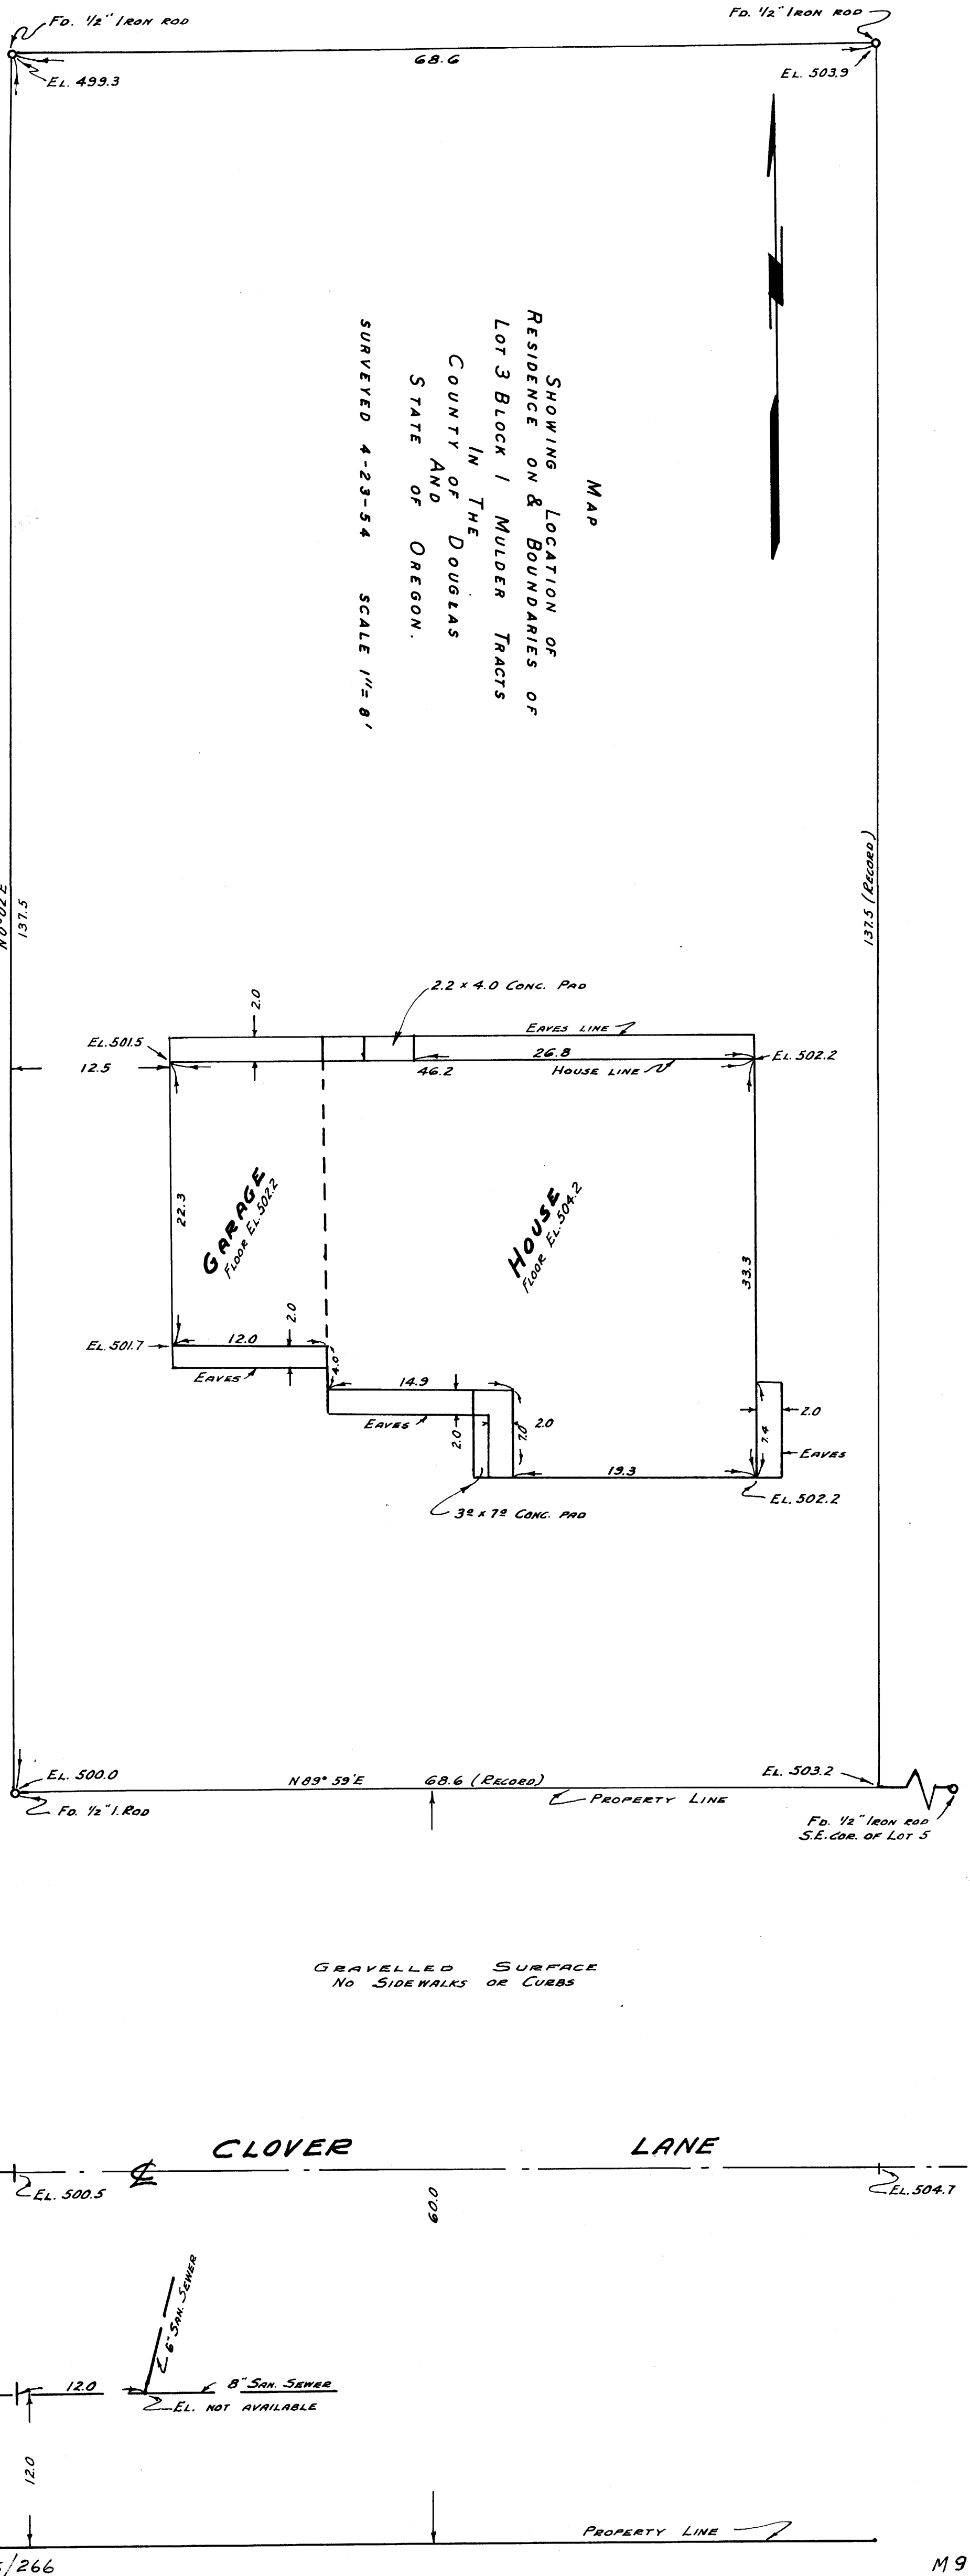
SCALE 1" = 8'