09-6W

FILED
RECEIVED
MAR 2 3 1958
COUNTY SURVEYOR
DOUGLAS COUNTY, ORE.

COUNTY SURVEYORS OFFICE
DO NOT REMOVE FROM OFFICE

L. H. BEAUDRIE
SUTHERLIN

OCTOBER 1952 FRED L. DOW

SCALE 1" = 100' C.E.

REGISTERED PROFESSIONAL ENGINEER 1362 Fred L. Dow OREGON MAR. 9 1928 FRED L. DOW

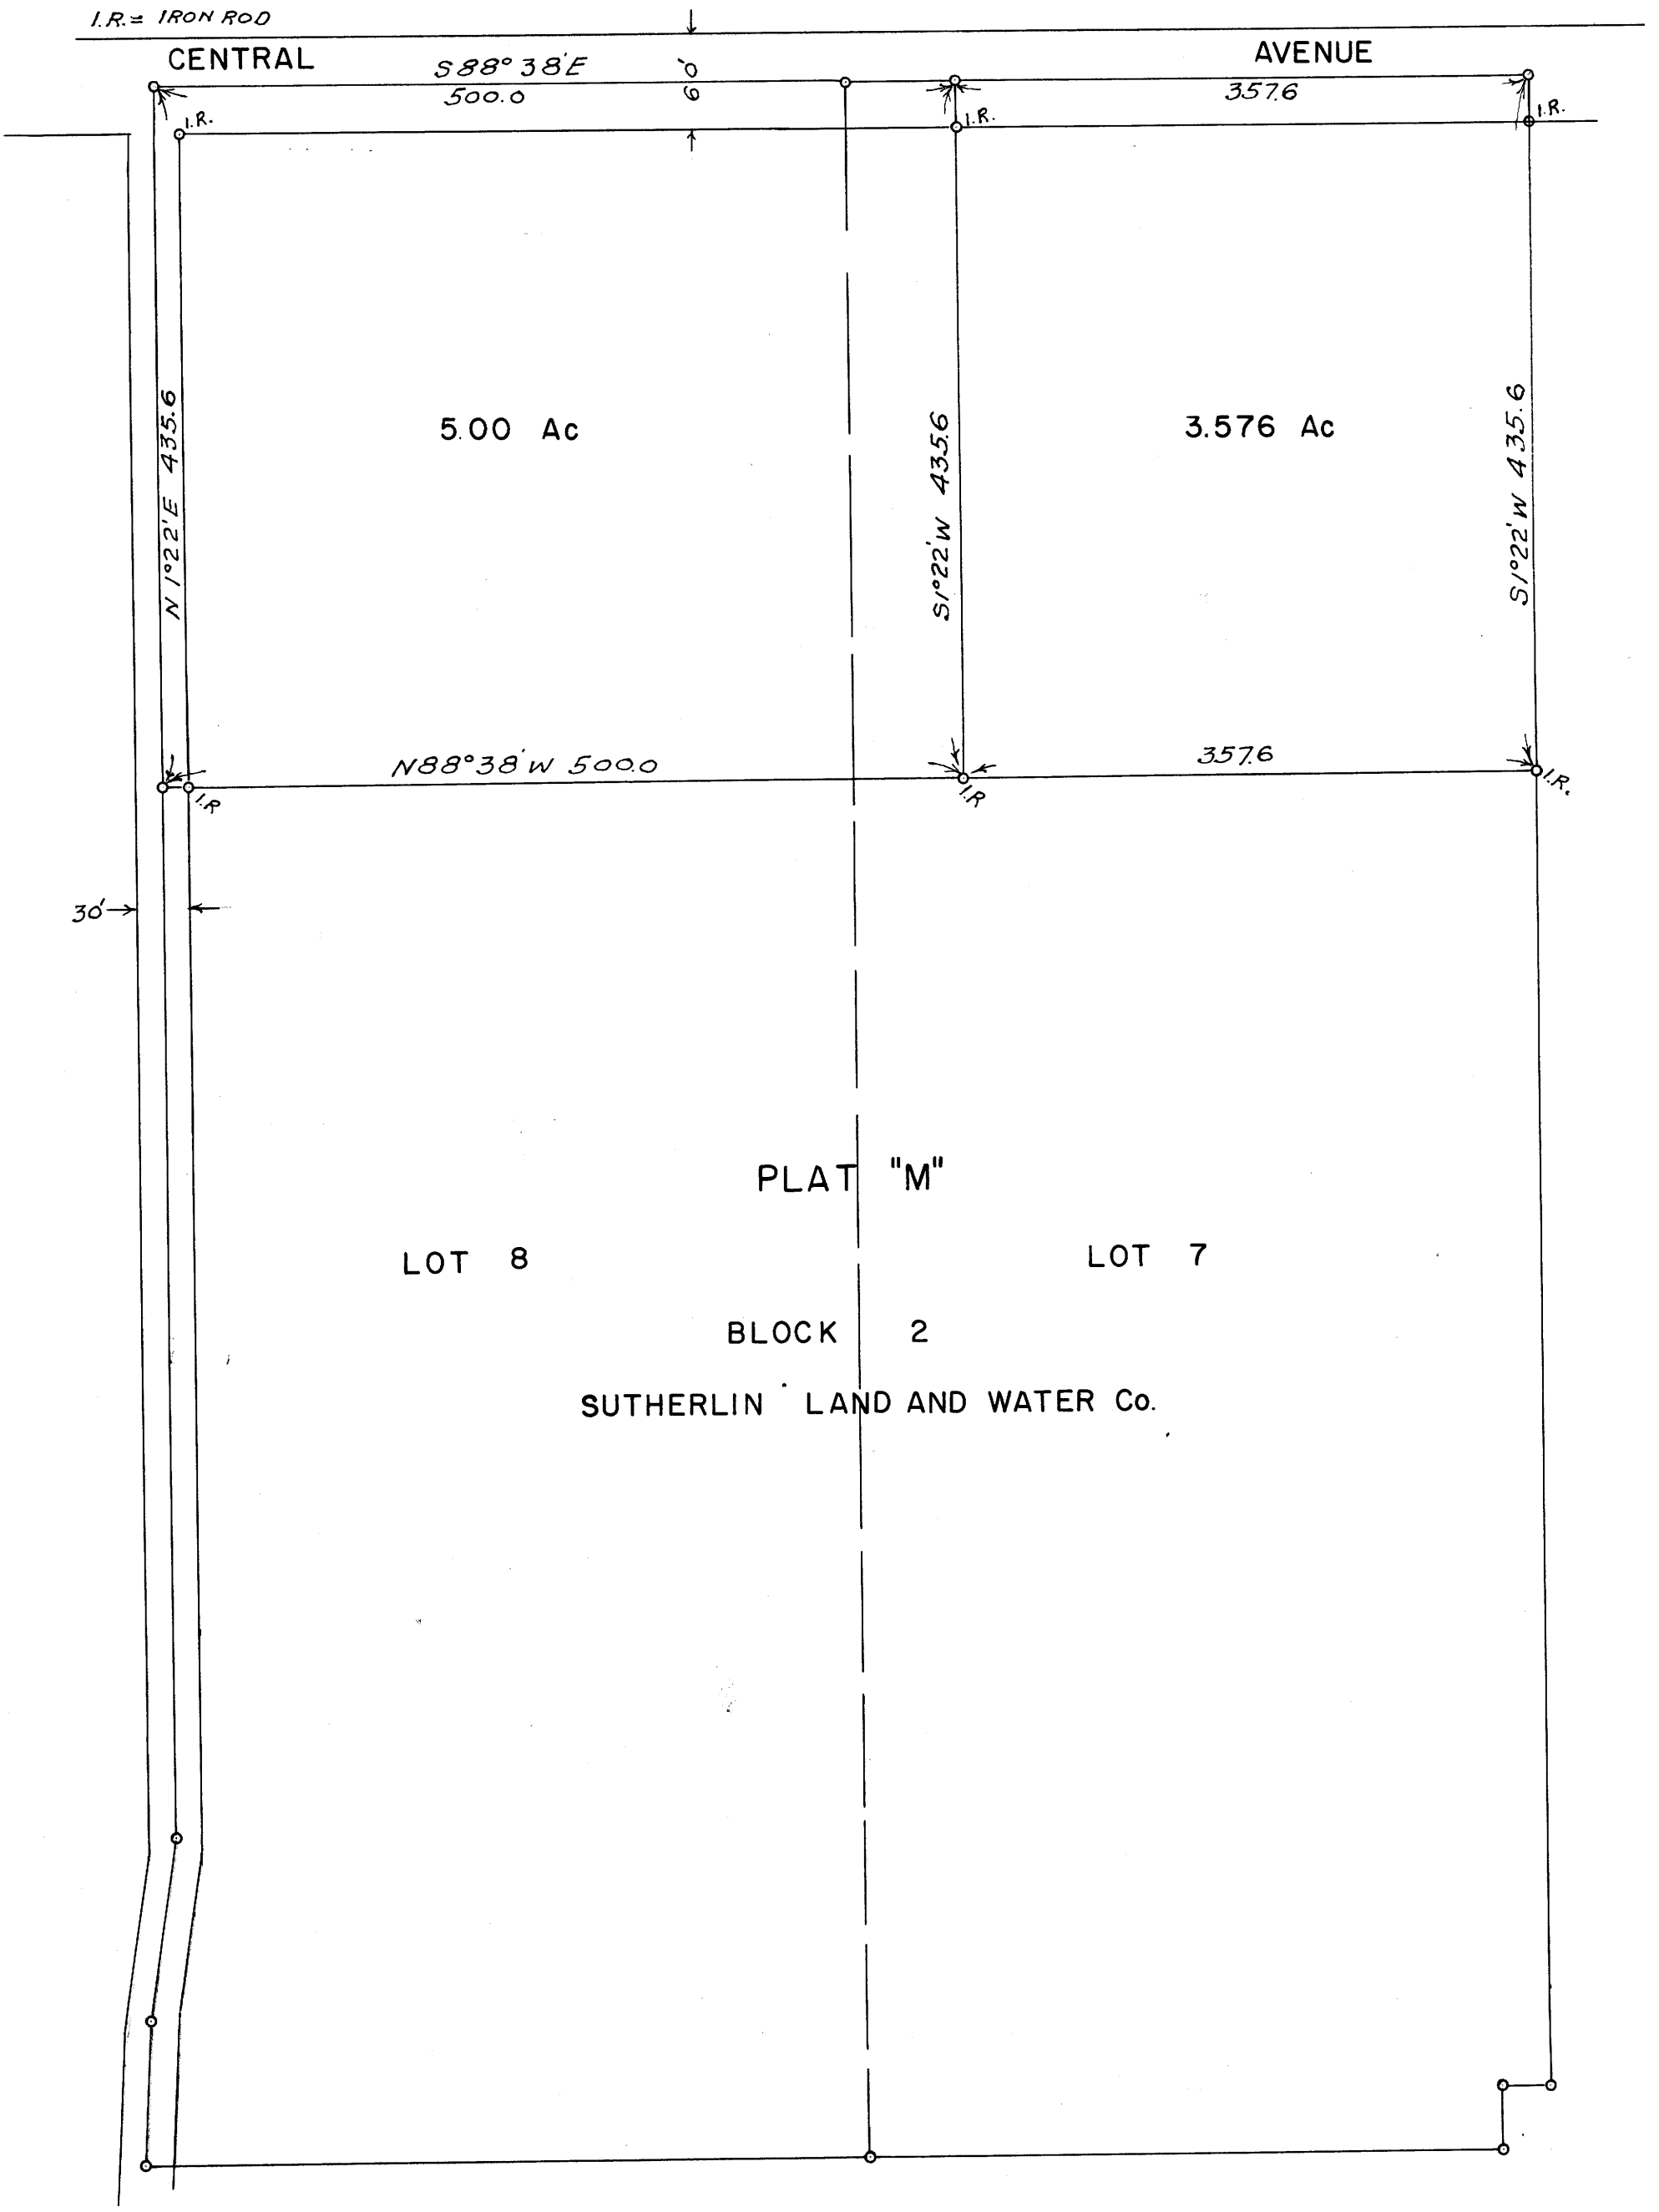

MAP FILE M9-60