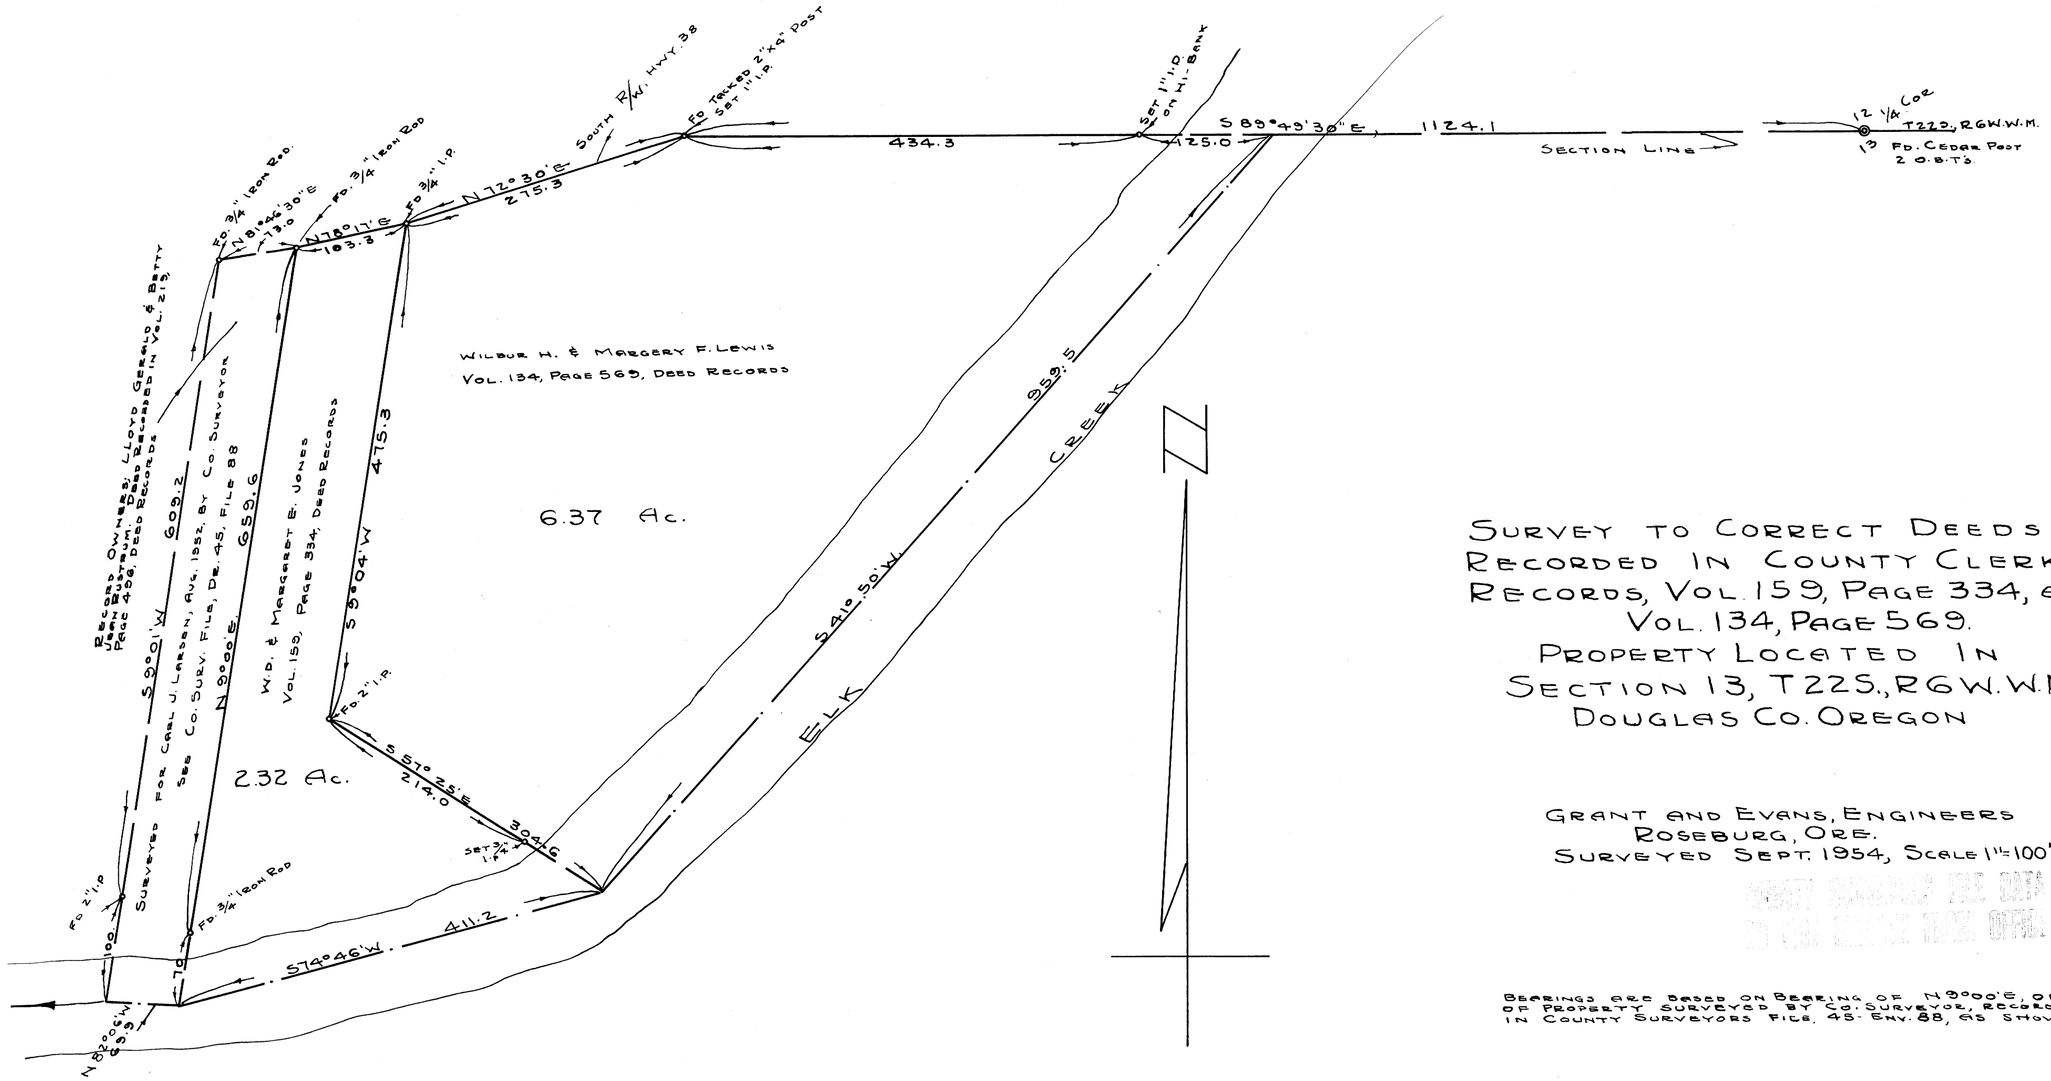

Survey to Correct Deeds As Recorded in County Clerk's Records, Vol. 159, Page 334, and Vol. 134, Page 569.

Property Located In
Section 13, T22S., R6W.W.M
Douglas Co. Oregon

Grant and Evans, Engineers
Roseburg, Ore.
Surveyed Sept. 1954, Scale 1"=100'

Bearings are based on bearing of N 9°00'E, of East Line of Property surveyed by Co. Surveyor, Record of which is in County Surveyors File, 45-Env. 88, as shown hereon

Arthur R. Evans

FILED
RECEIVED
NOV 3 1954
COUNTY SURVEYOR
DOUGLAS COUNTY, ORE.

M 10-42

M 10-42
C.S. File No. 41/311