COUNTY SURVEYORS FILE
DO NOT REMOVE FROM OFFICE

NOTE:- THIS TRACING IS A COPY OF A PRINT OF A MAP DRAWN BY E.L. ROBINSON IN 1909, AND DOES NOT CONSTITUTE ANY FIELD WORK DONE BY THIS OFFICE.

AMENDED MAP OF THE TOWN OF Gardiner

DOUGLAS COUNTY, OREGON

~1909~

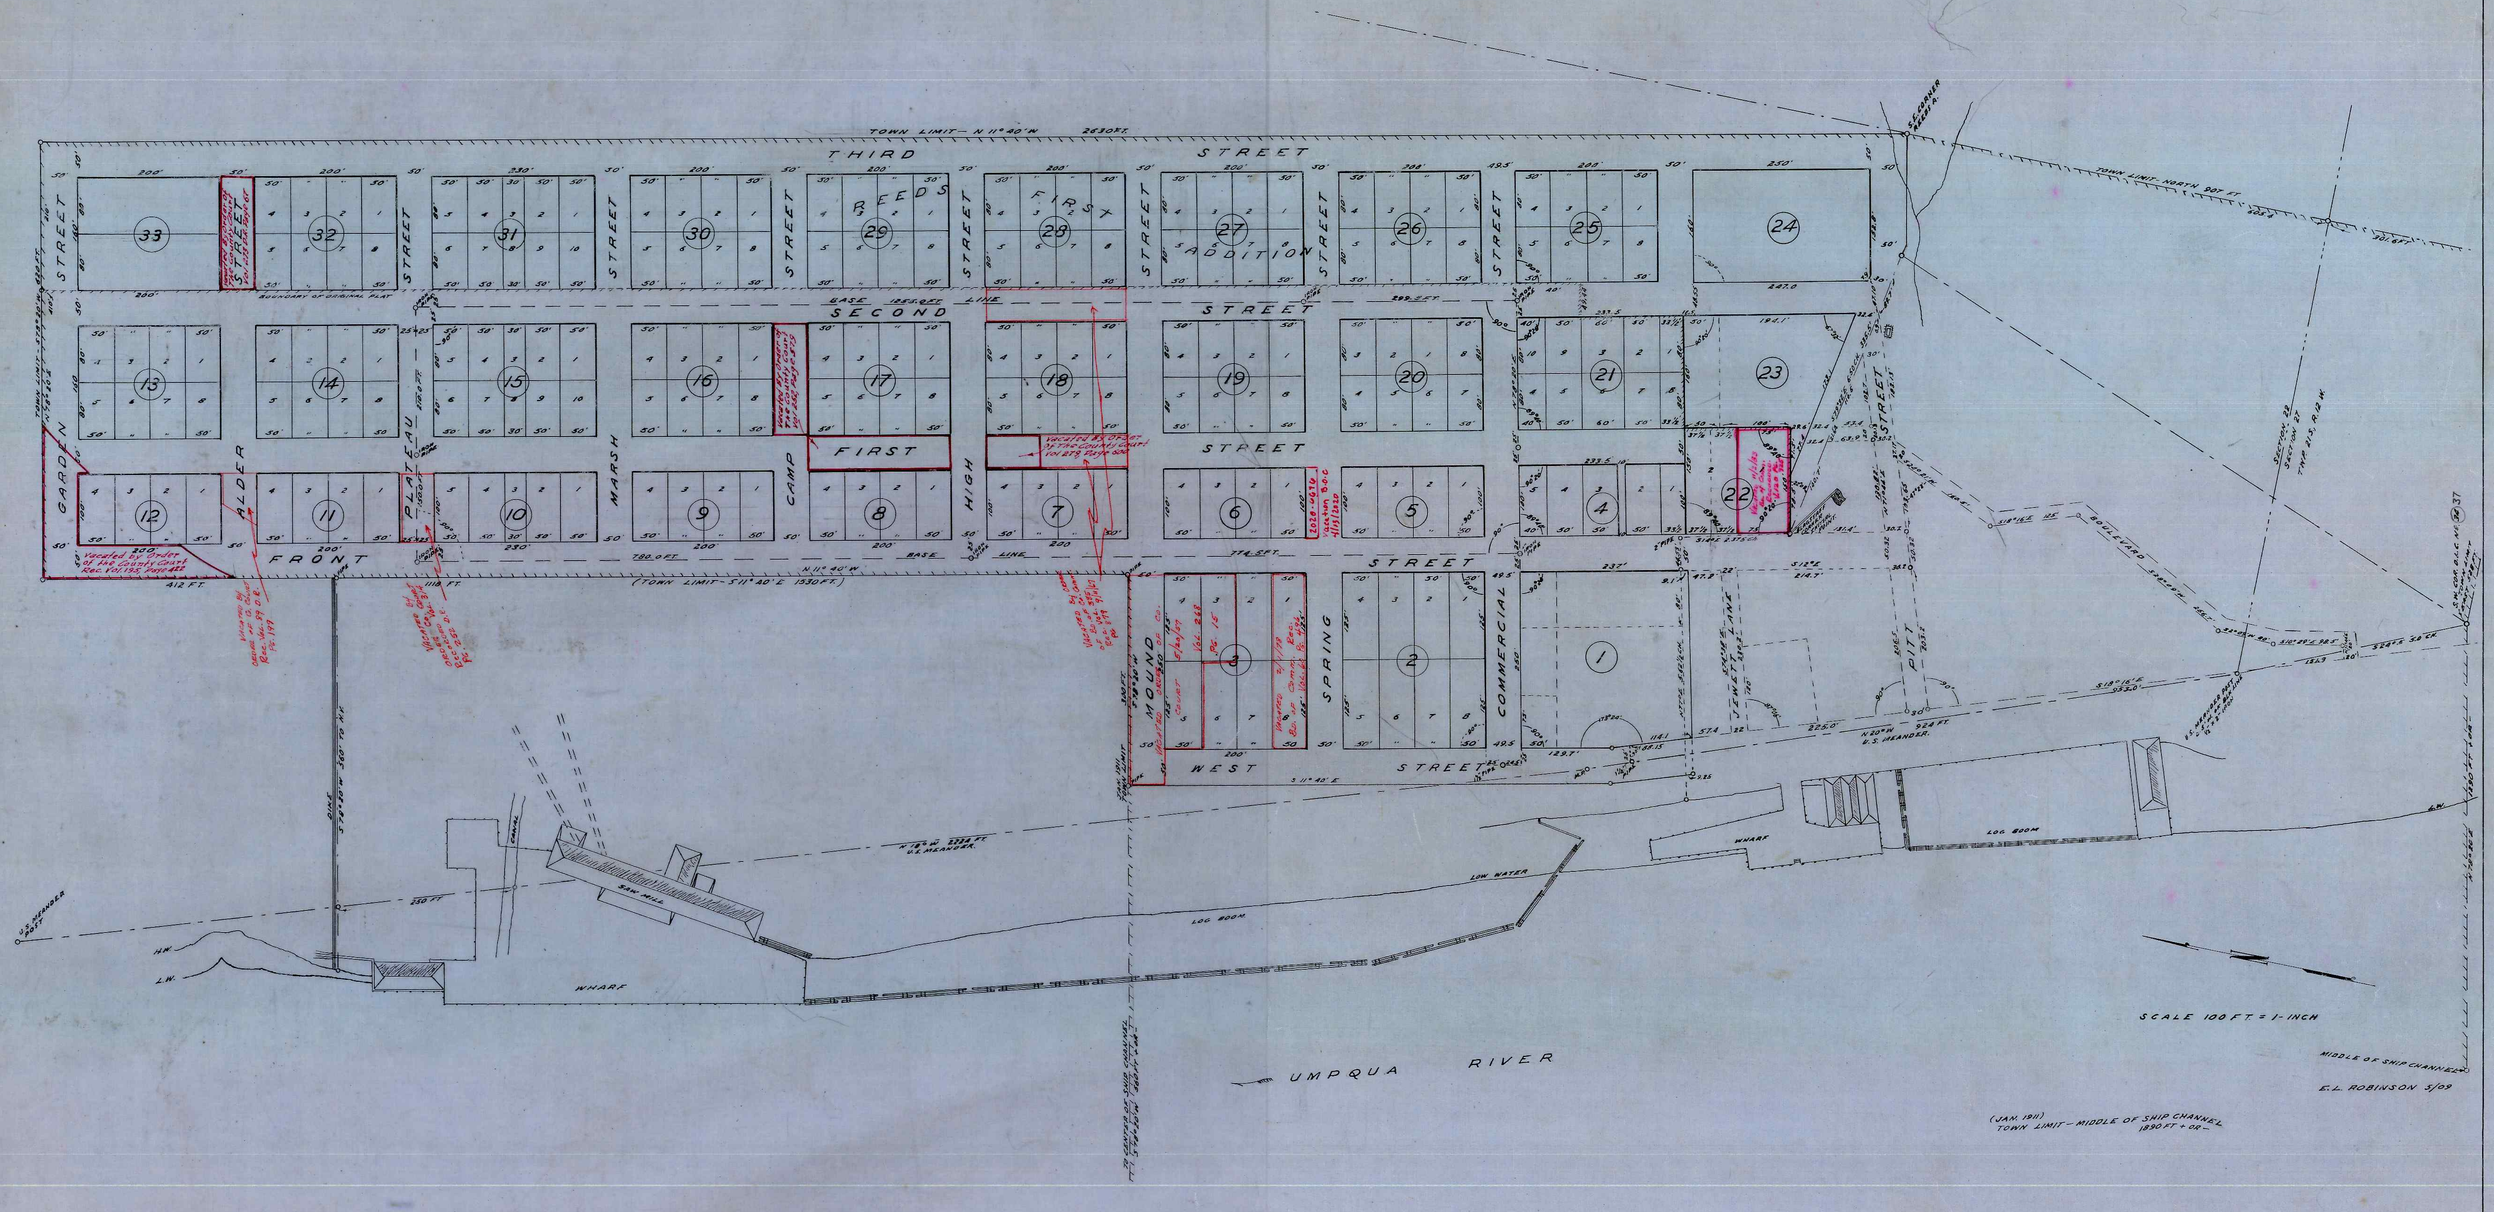

COUNTY SURVEYORS FILE
DO NOT REMOVE FROM OFFICE

M 11-24