COUNTY SURVEYORS FILE DATA
DO NOT REMOVE FROM OFFICE

MAP FILE M 11-38

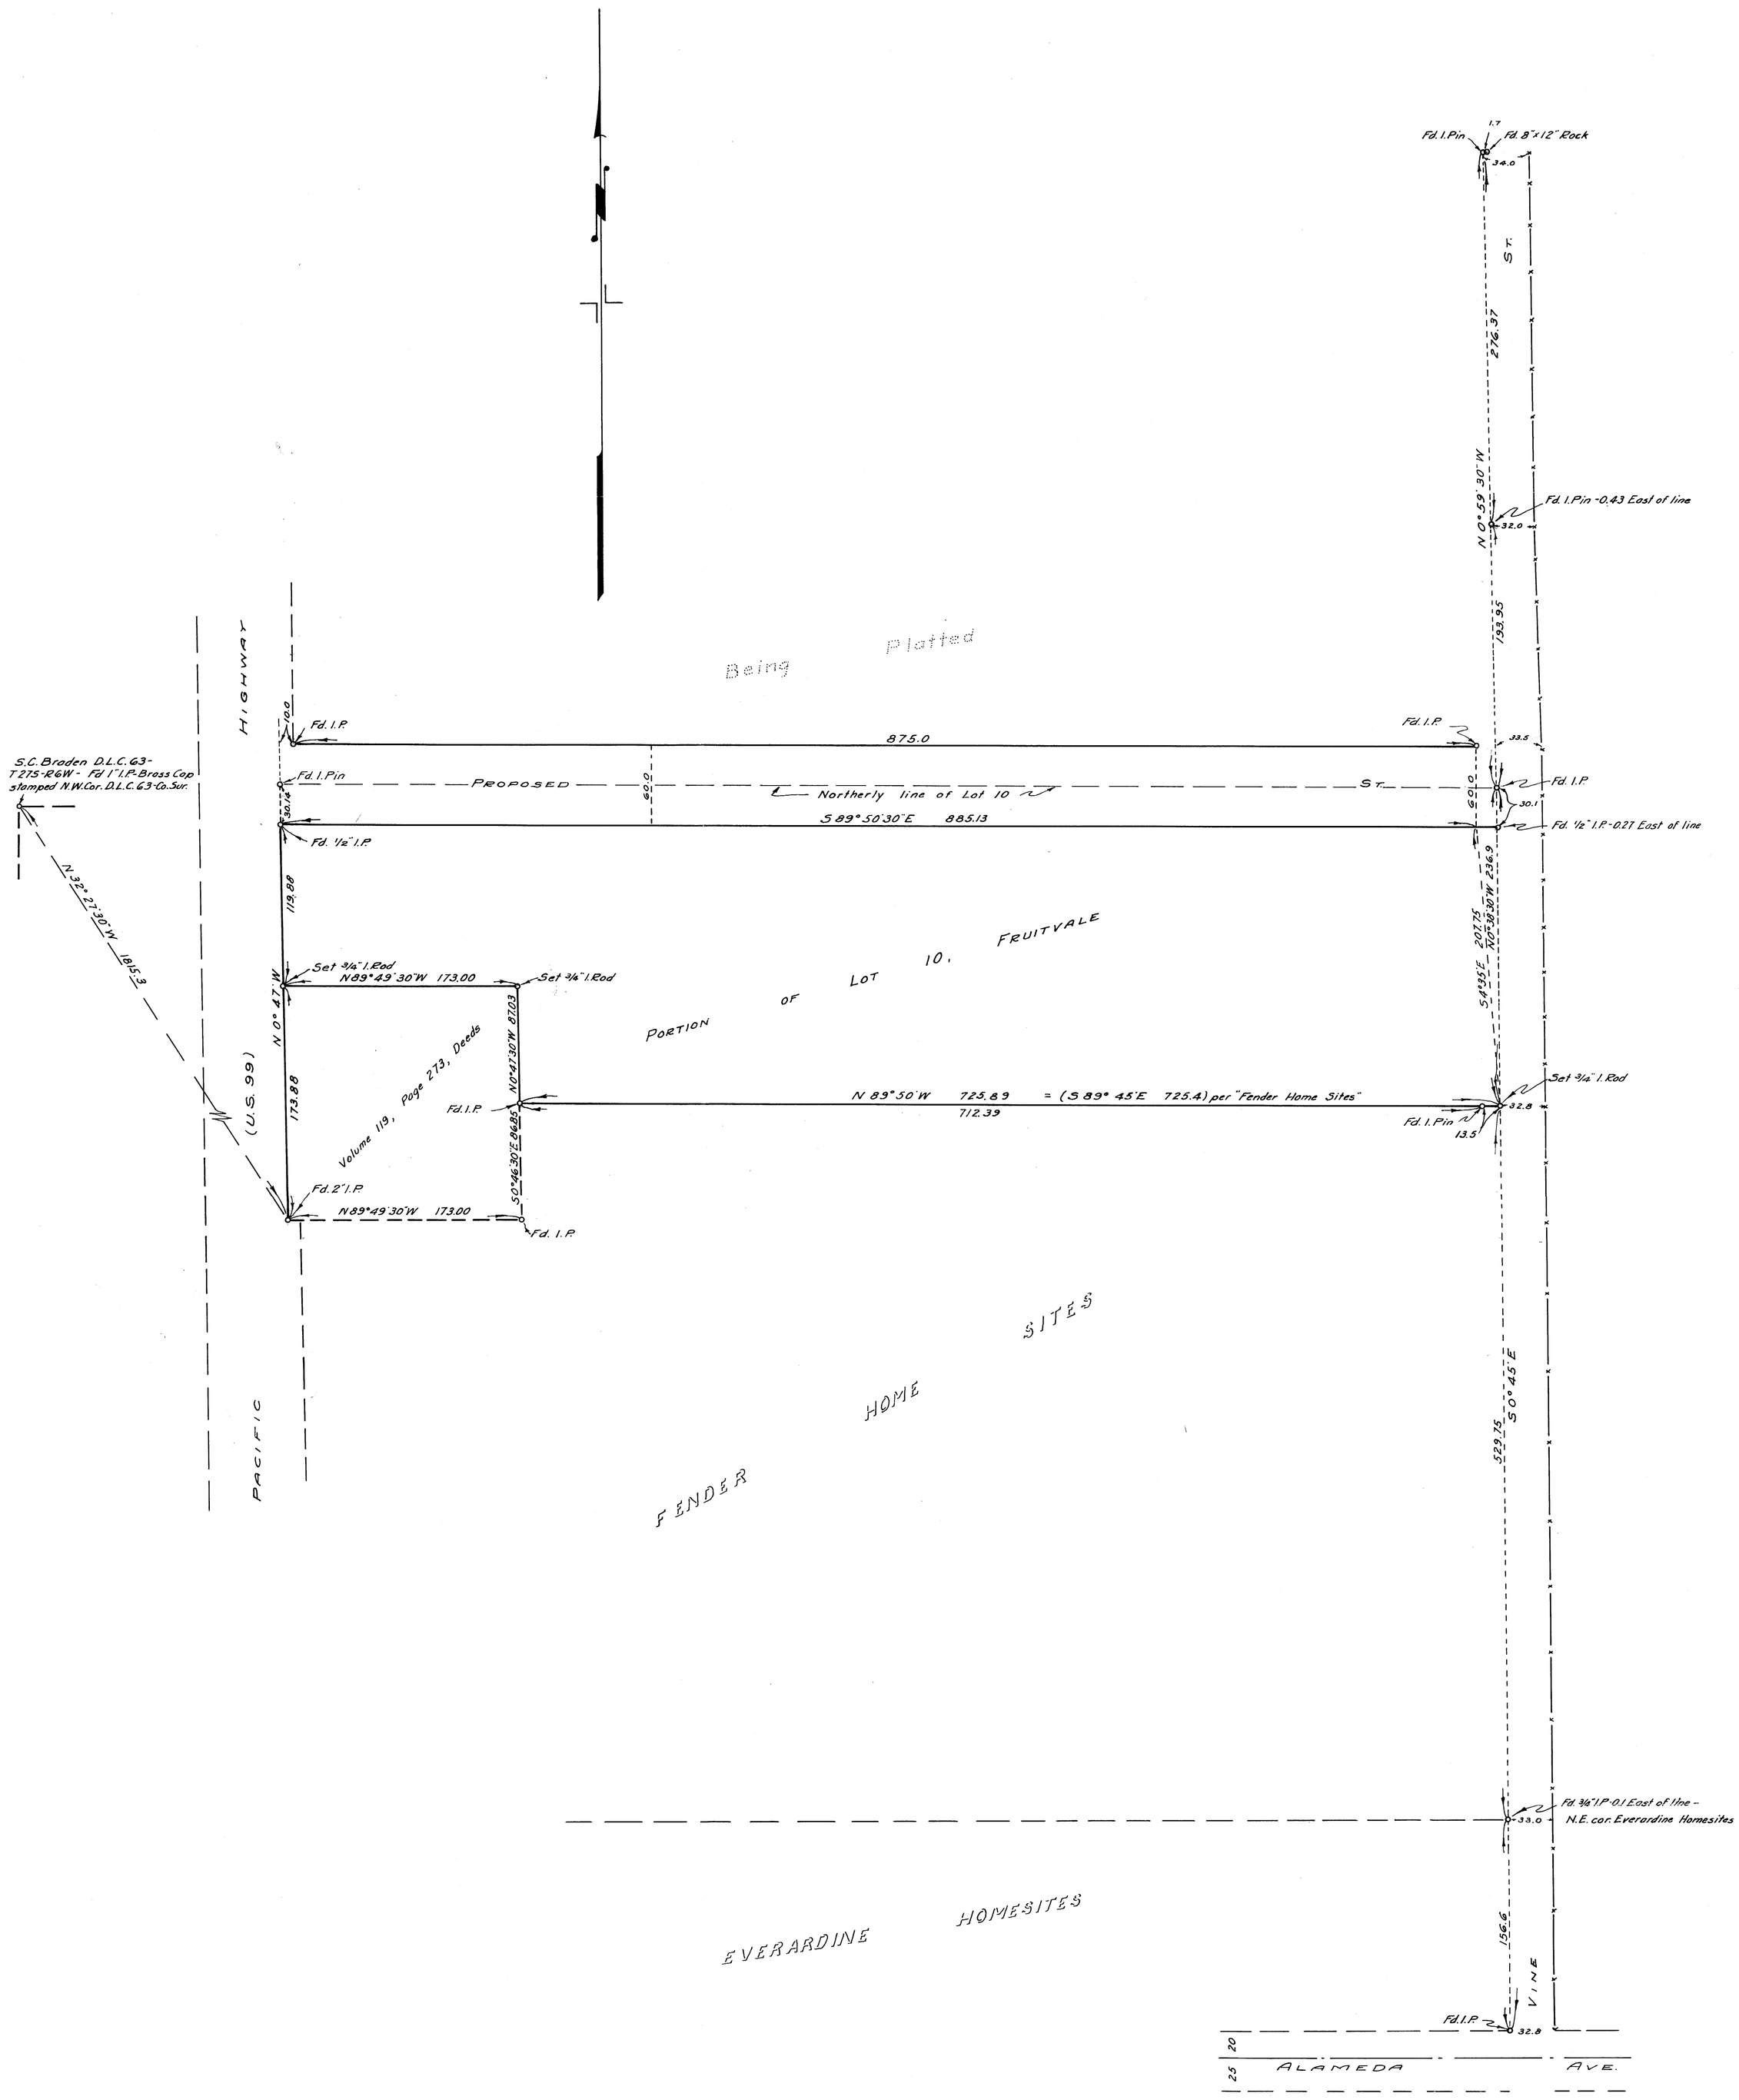

NOTE:-
Bearings shown are based on the bearing of N 0° 47' W on the east side of the Pacific Highway, as shown on the record plat of Fenders Home Sites, and also, the map of said Highway as prepared by the Oregon State Highway Dep't.

N.E. Richardson

COUNTY SURVEYOR'S OFFICE
DOUGLAS COUNTY. OREGON

SURVEY OF THE NORTH ONE-HALF OF LOT 10, FRUITVALE.

BEN. B. IRVING — COUNTY SURVEYOR
SURVEYED OCTOBER 3. 4. 1949 — BY
N.E. RICHARDSON — DEPUTY

SCALE 1" = 60'

COUNTY SURVEYORS FILE DATA
DO NOT REMOVE FROM OFFICE

C.S. File 22162
MAP FILE M 11-38