COUNTY SURVEYORS FILE DR
DO NOT REMOVE FROM OFFI

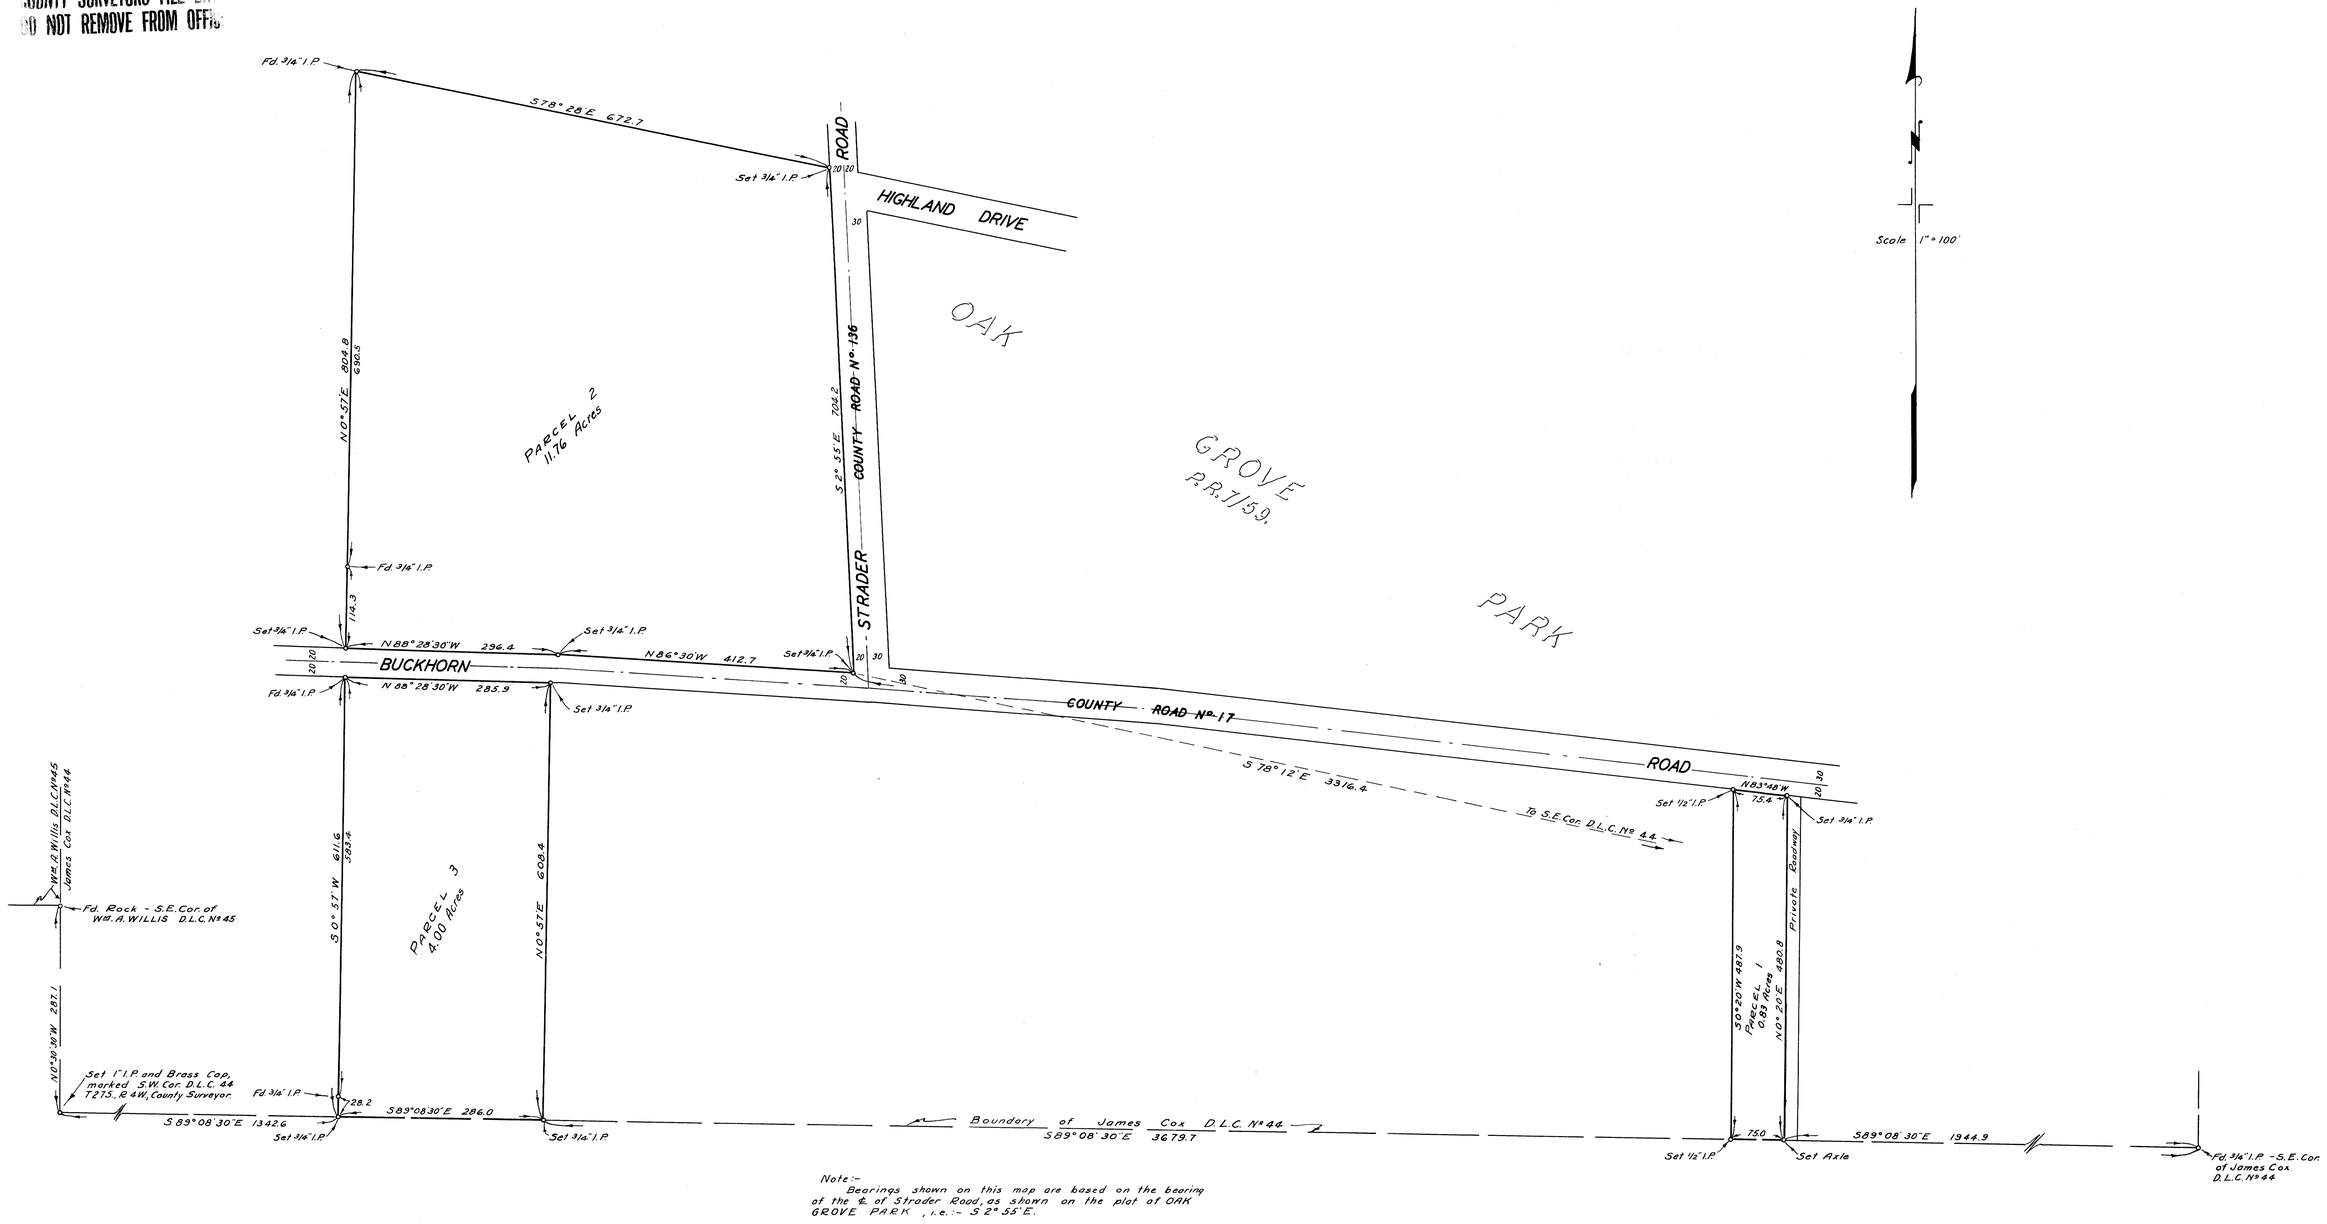


Note:-
Bearings shown on this map are based on the bearing of the ℄ of Strader Road, as shown on the plat of OAK GROVE PARK, i.e.:- S 2° 55' E.

OFFICE OF THE COUNTY SURVEYOR
DOUGLAS COUNTY, OREGON

SURVEY FOR DEED DESCRIPTIONS OF
PARCELS IN JAMES COX D.L.C. Nº 44.
SECTIONS 20 & 21, T 27 S, R 4 W, W.M.

BEN. B. IRVING COUNTY SURVEYOR
SURVEY COMPLETED APRIL 2, 1948.

REGISTERED PROFESSIONAL ENGINEER 240 OREGON NOV. 8 1949 BEN B. IRVING

COUNTY SURVEYORS FILE
DO NOT REMOVE FROM OFFI

F.M.D. 4/14/48

C.S. 43/53
M 11-55

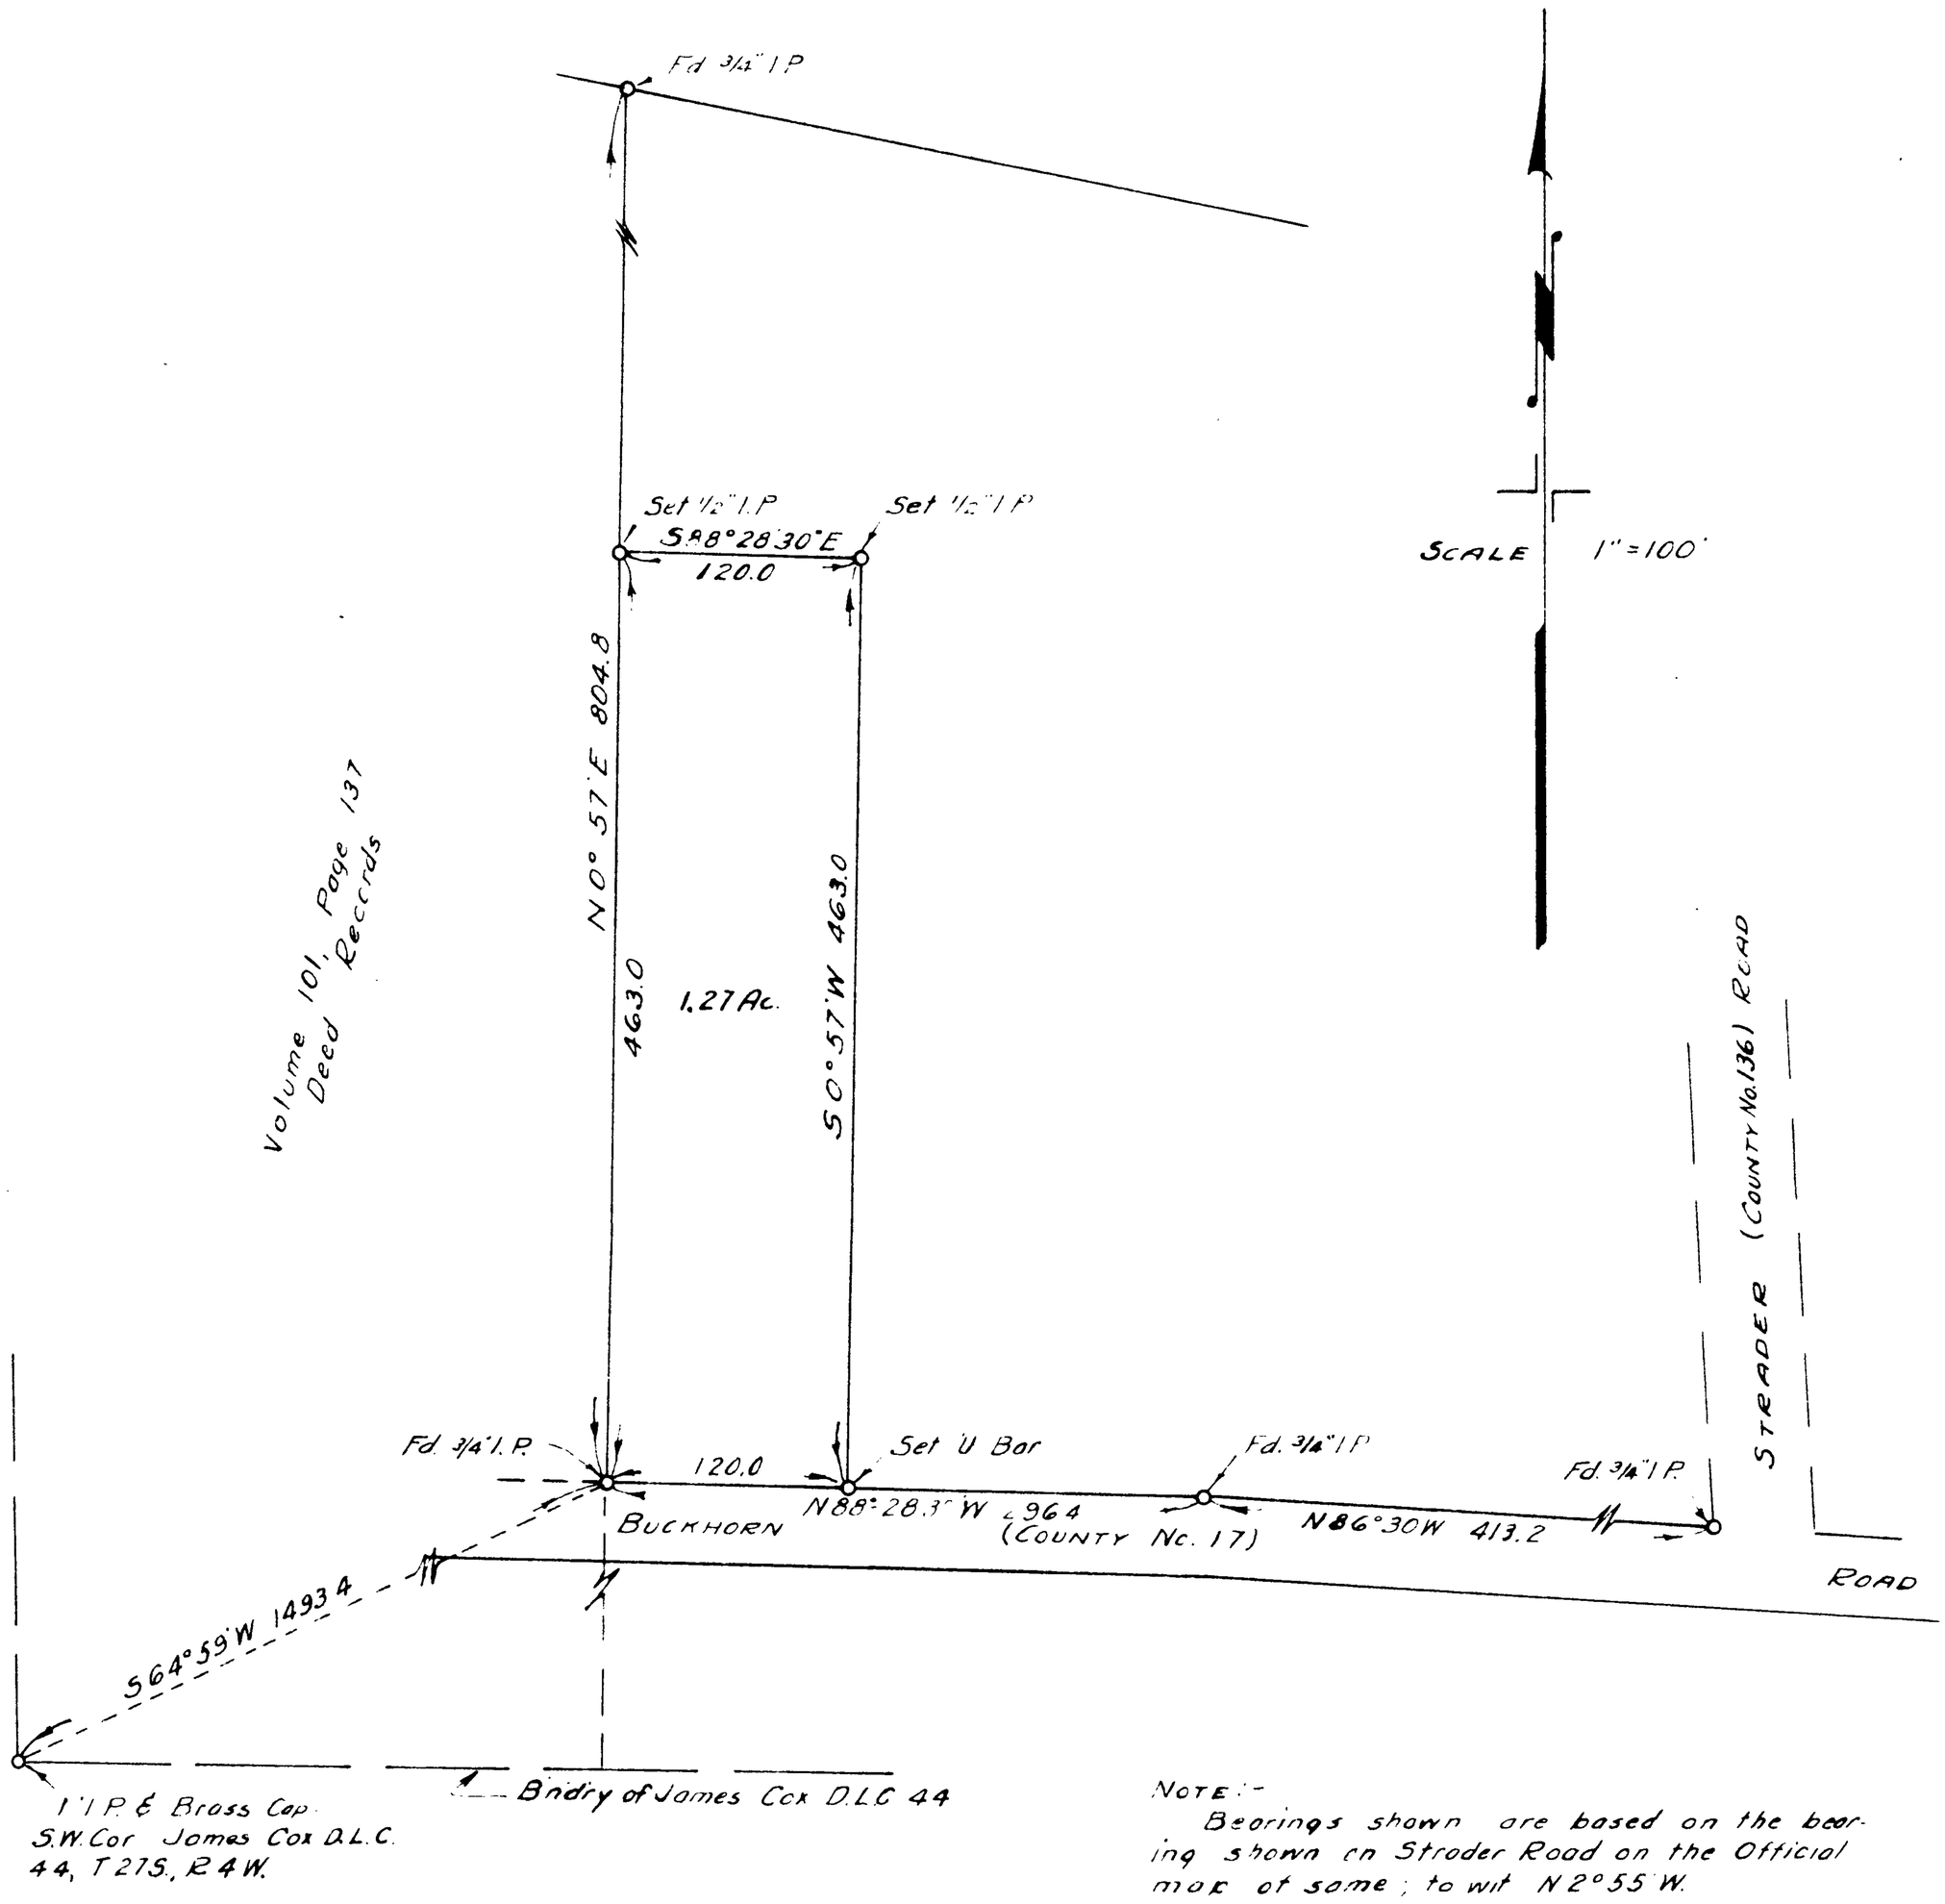


NOTE:-
Bearings shown are based on the bearing shown on Strader Road on the Official map of same; to wit N2°55'W.

# COUNTY SURVEYOR'S OFFICE
# DOUGLAS COUNTY, OREGON

## SURVEY FOR DEED DESCRIPTION, PORTION OF JAMES COX D.L.C. 44, SECTION 20, T27S., R4W., W.M.

BEN. B. IRVING COUNTY SURVEYOR
SURVEYED OCT. 28, 1949 BY
N.E. RICHARDSON DEPUTY

N E Richardson
RICH

C. S. File No. 43/53