COUNTY SURVEYORS FILE DATA
DO NOT REMOVE FROM OFFICE

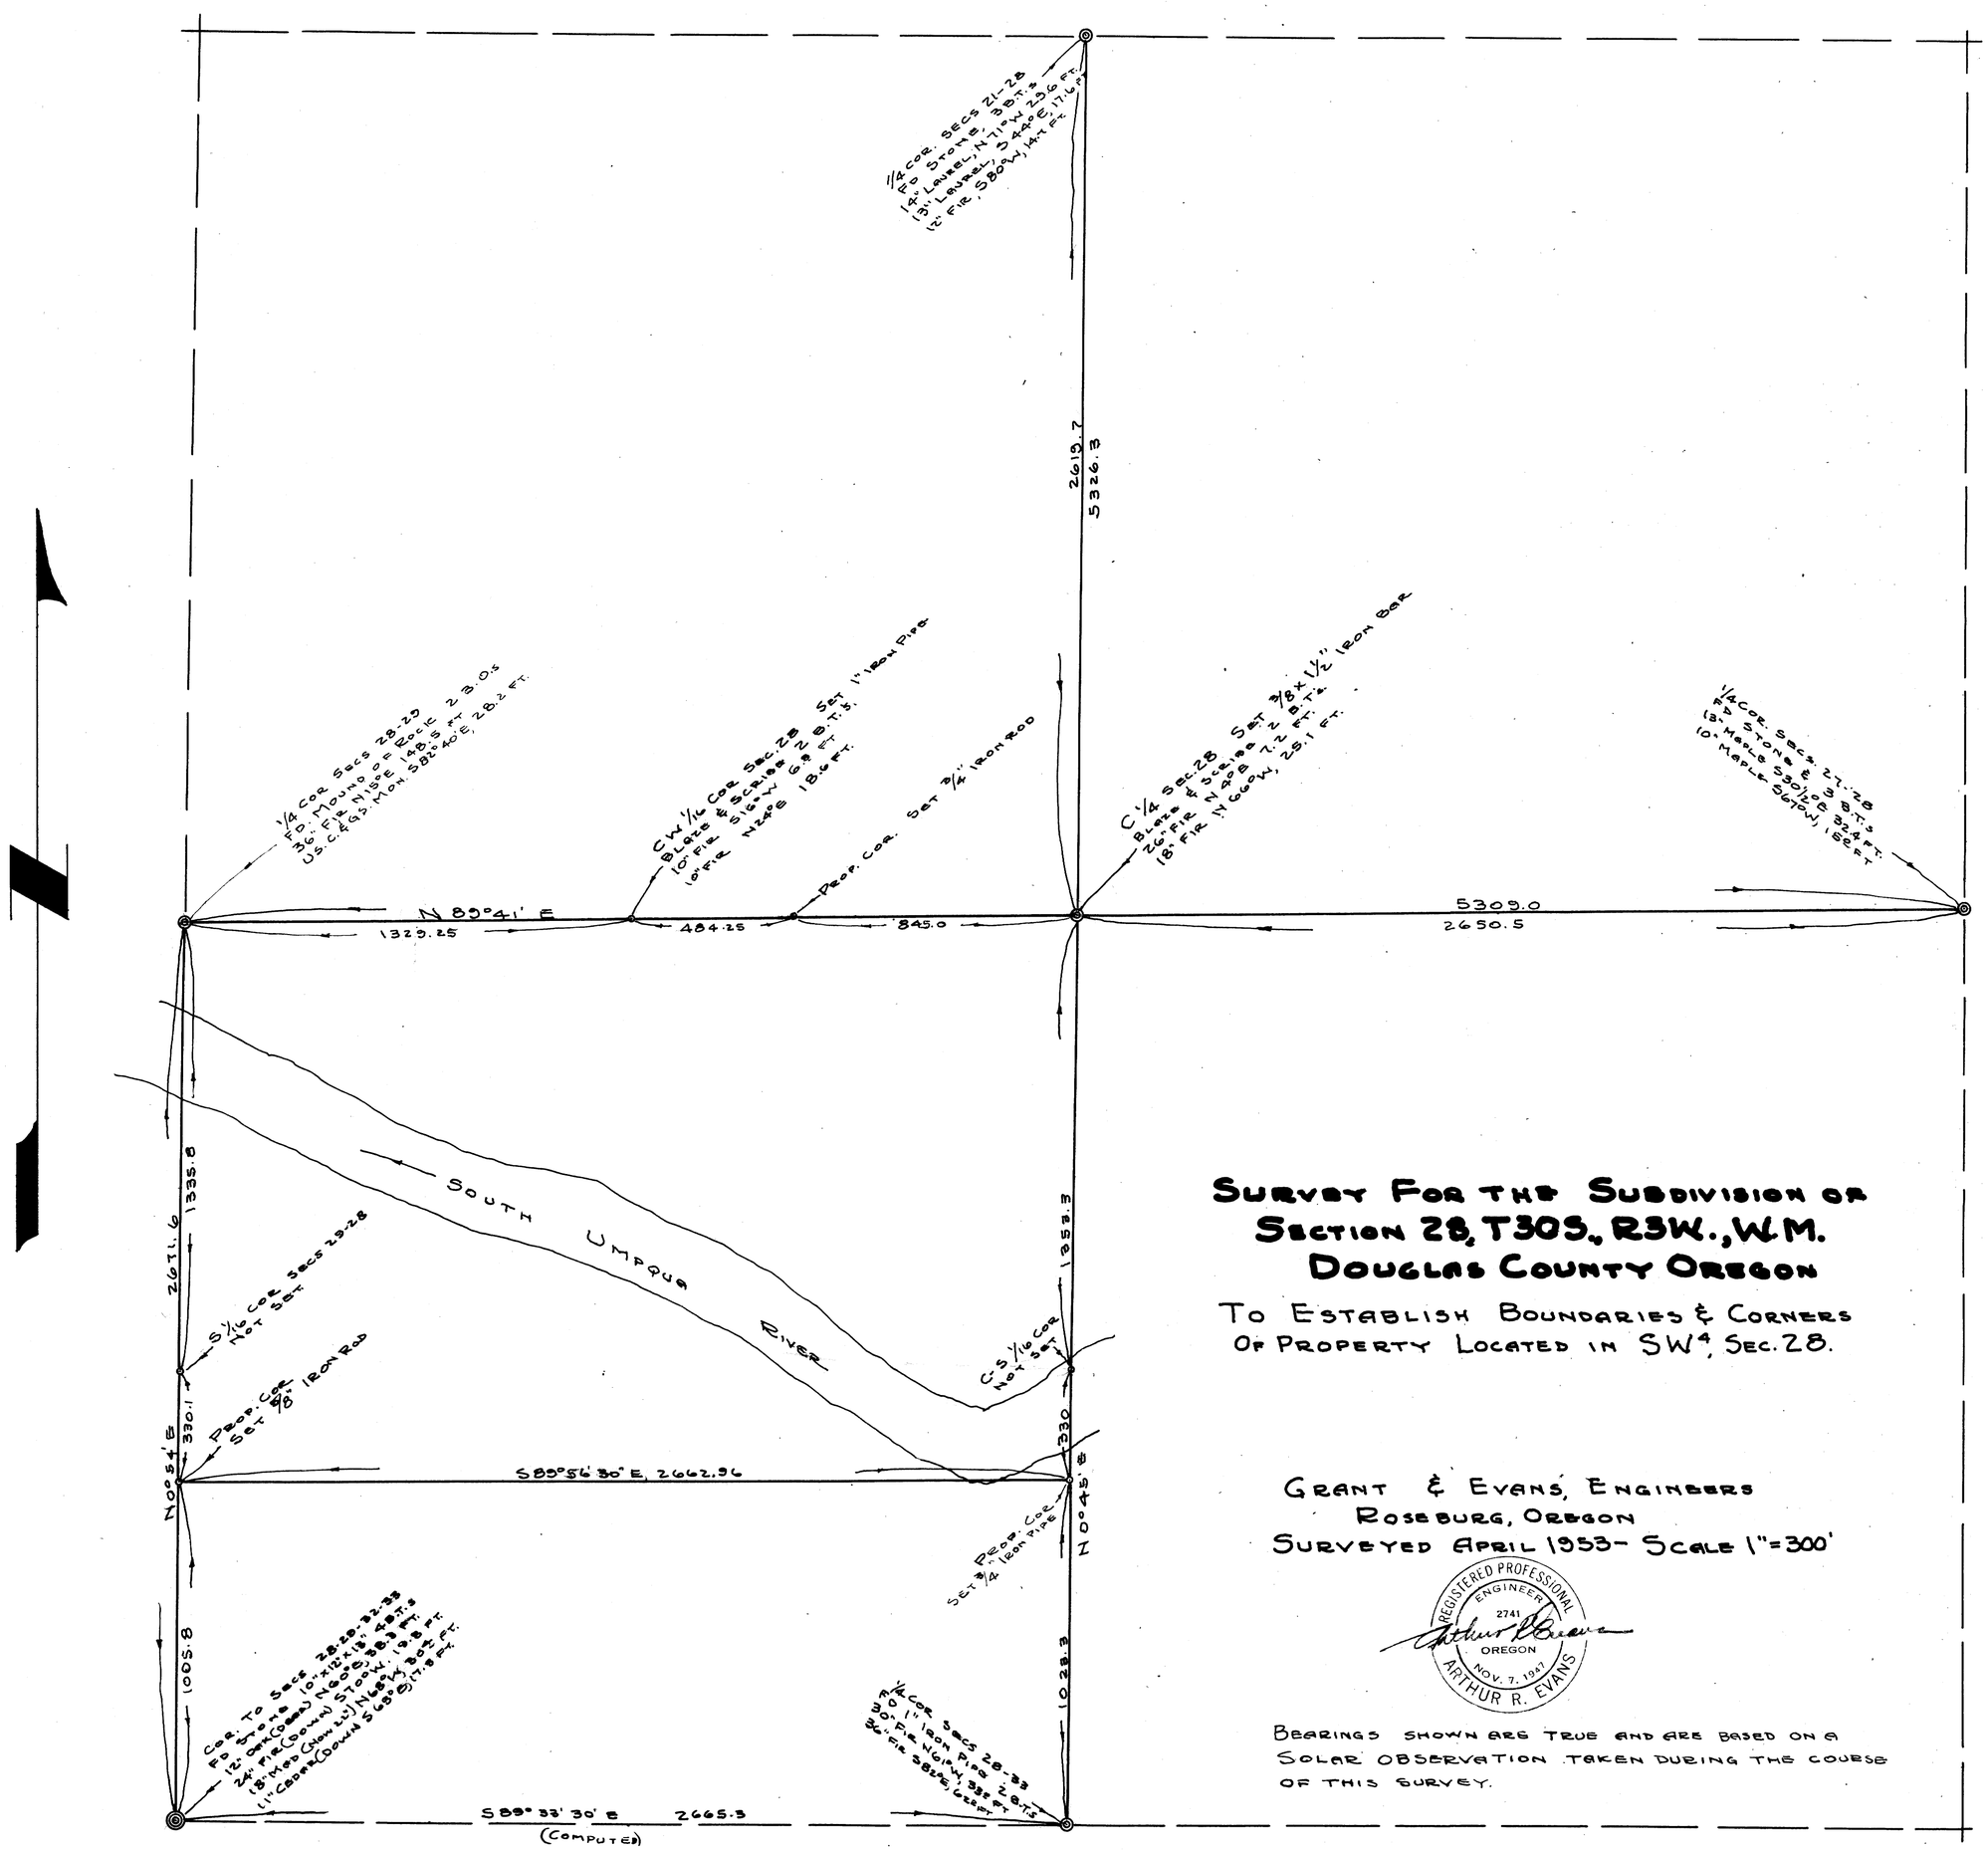

SURVEY FOR THE SUBDIVISION OF SECTION 28, T30S., R3W., W.M. DOUGLAS COUNTY OREGON

TO ESTABLISH BOUNDARIES & CORNERS OF PROPERTY LOCATED IN SW¼, SEC. 28.

GRANT & EVANS, ENGINEERS
ROSEBURG, OREGON
SURVEYED APRIL 1953 - SCALE 1" = 300'

REGISTERED PROFESSIONAL ENGINEER 2741 OREGON NOV. 7, 1947 ARTHUR R. EVANS

BEARINGS SHOWN ARE TRUE AND ARE BASED ON A SOLAR OBSERVATION TAKEN DURING THE COURSE OF THIS SURVEY.

COUNTY SURVEYORS FILE DATA
DO NOT REMOVE FROM OFFICE

FILED
RECEIVED
JUN 29 1953
COUNTY SURVEYOR
DOUGLAS COUNTY, ORE.

SURVEYED FOR CLAUDE HOWARD

C.S. File No. 41/172

C.S. File 41/172
Map File M 11 + 59