C S File 41-/259
Map File M 11-60

COUNTY SURVEYORS FILE ONLY
DO NOT REMOVE FROM OFFICE

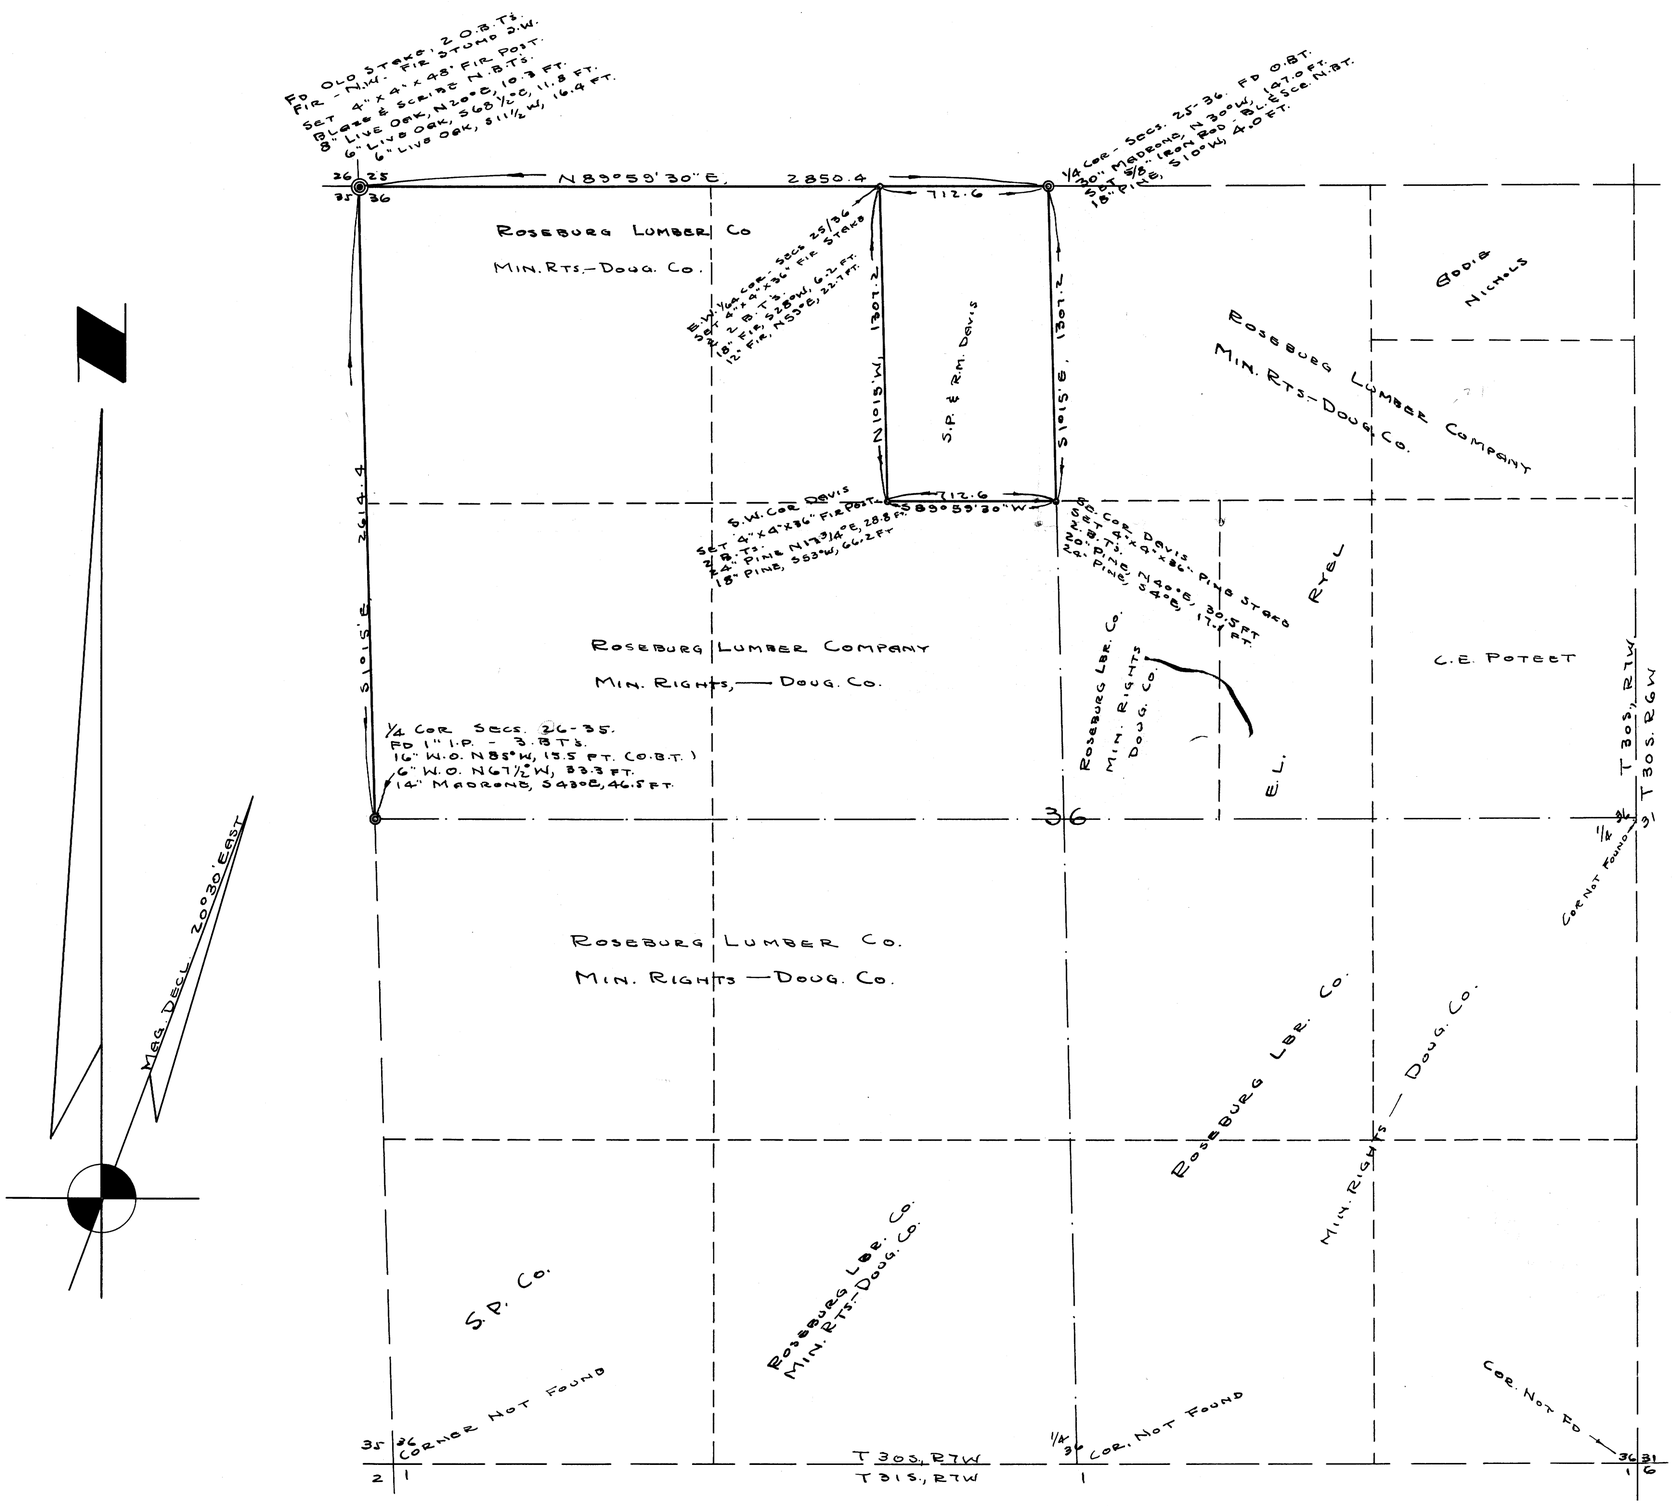

NOTE: The establishment of the boundaries of the E½NE¼NW¼ — The purpose of this survey — could not be accomplished by the standard legal method; i.e., subdivision of the section and its NW¼, because the E 1/4 cor. and the S 1/4 cor. could not be found after a diligent search and their re-establishment by the method of proportionate measurement would have entailed a cost far out of proportion to the value of the land involved.

In lieu of this method, the interested property owners agreed to accept the boundaries as determined by this survey, to wit: The east and west lines were made parallel to the established west section line, and the south line was made parallel to the established north section line.

Arthur R. Evans
Arthur R. Evans
Reg. Prof. Engineer

Survey to Establish Boundary Lines
E½ NE¼ NW¼, Sec. 36, T30S, R7W., W.M.
Douglas County Ore

Grant and Evans Engineers
Roseburg Oregon
Surveyed Dec. 1953 Scale 1" = 400'

FILED
RECEIVED
JAN 26 1954
COUNTY SURVEYOR
DOUGLAS COUNTY, ORE.

COUNTY SURVEYORS FILE ONLY
DO NOT REMOVE FROM OFFICE

A R Evans

Surveyed for S.P. Davis

C S File 41-/259
Map File M 11-60