C.S. FILE 18/36
M11-64

COUNTY SURVEYORS FILE
DO NOT REMOVE FROM OFF

NATHAN FULLERTON'S MT. NEBO TRACT

ROSEBURG, DOUGLAS COUNTY, OREGON

COUNTY SURVEYOR'S OFFICE

MAY 20, 1935 SCALE 1" = 100'

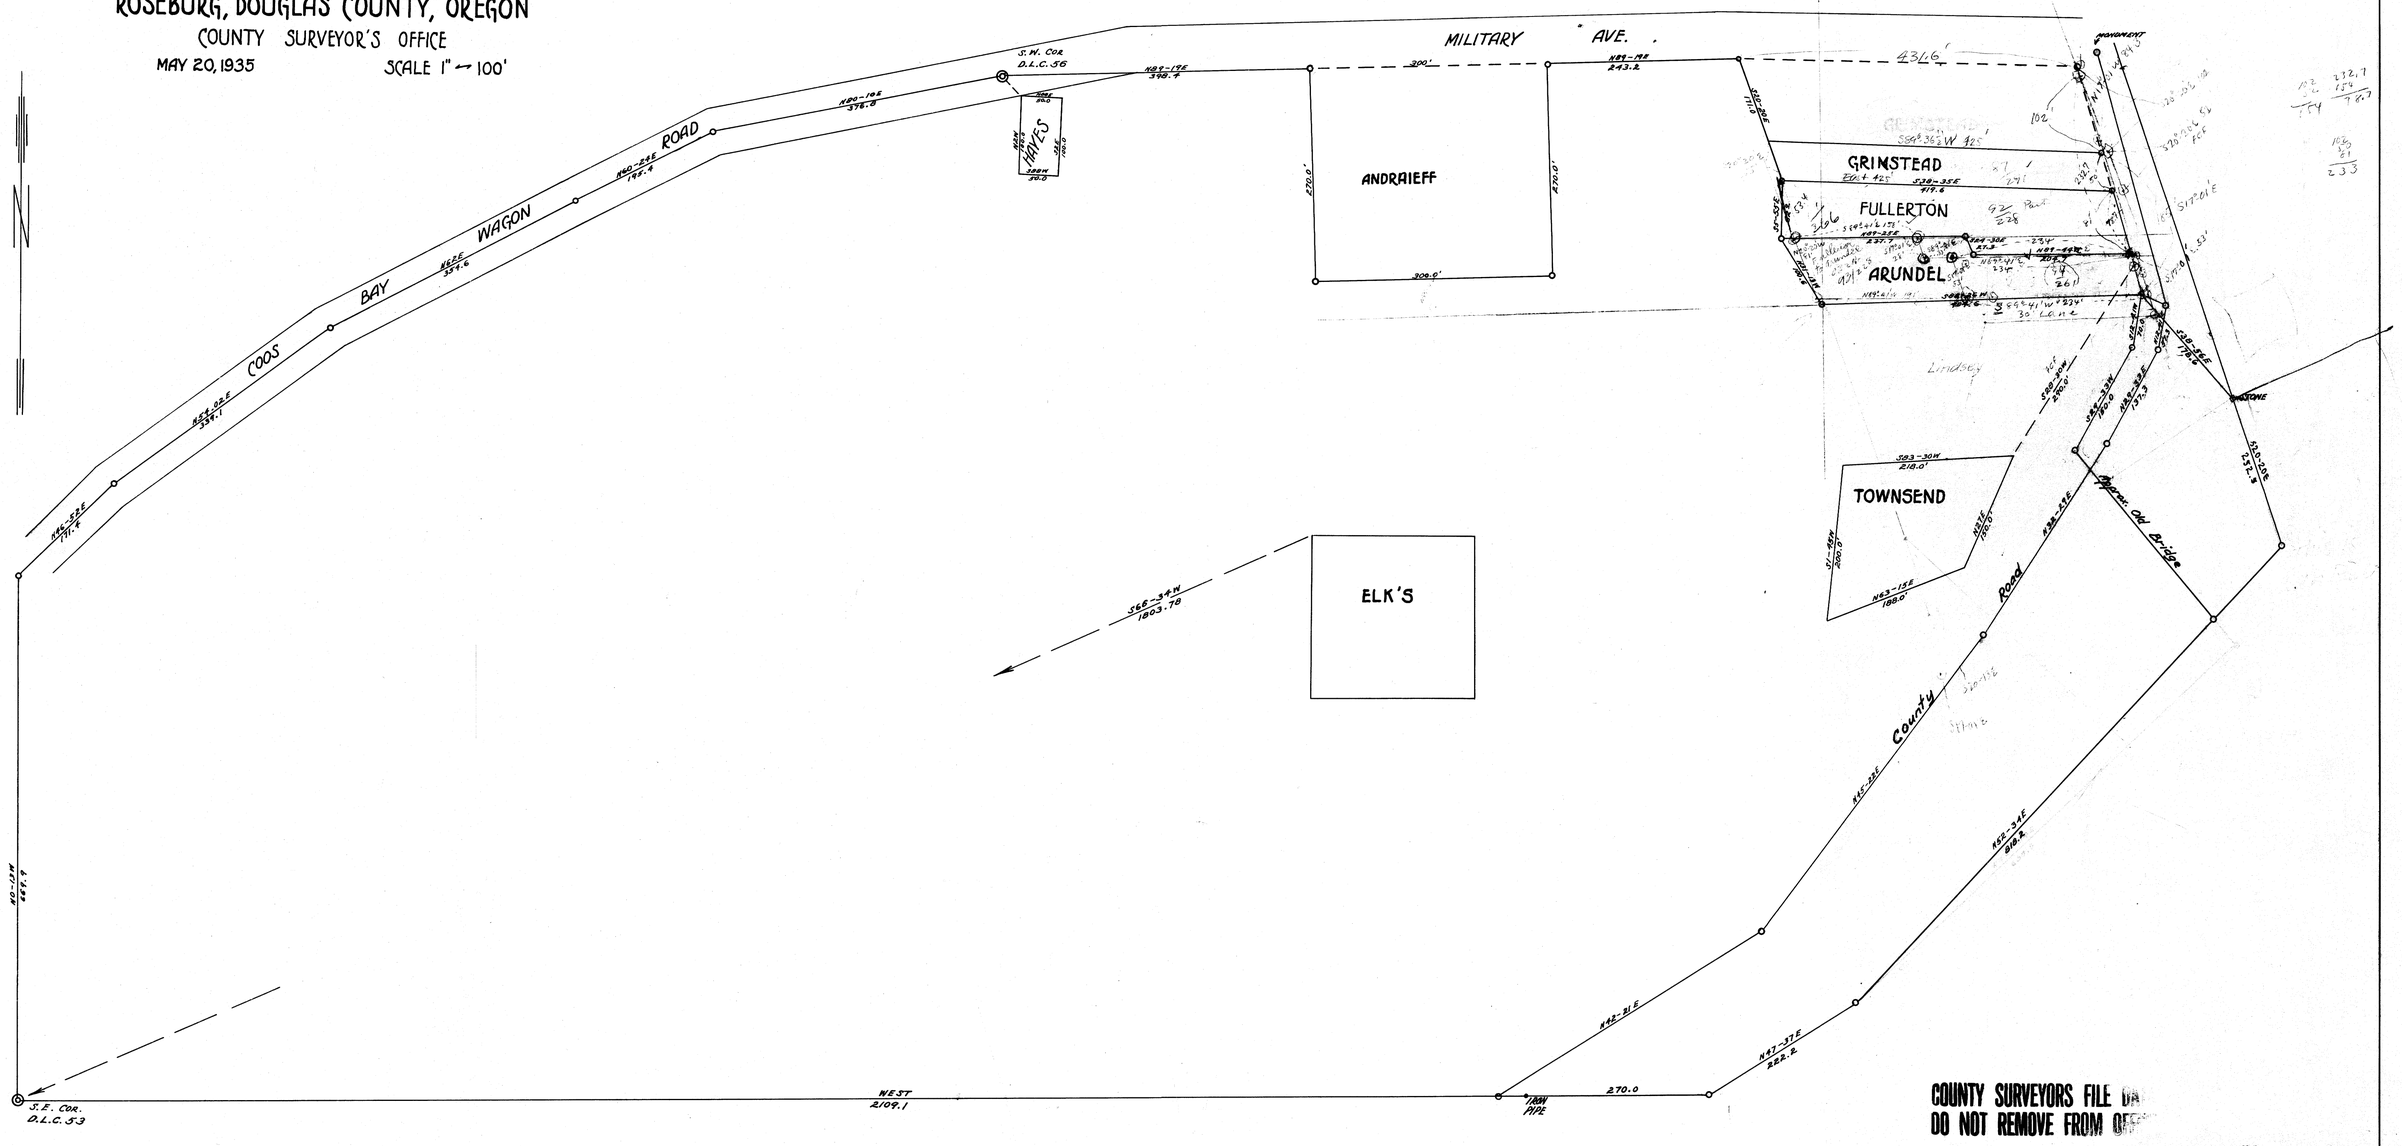

COUNTY SURVEYORS FILE
DO NOT REMOVE FROM OFF

DRAWER 58

C.S. FILE 18/36
M11-64

24/5216 SP.4