


CITY COUNCIL OF DRAIN, OREGON.
APPROVED April 6, 1948
BY Shirley Evans MAYOR
Ruby B. Holloway CITY RECORDER

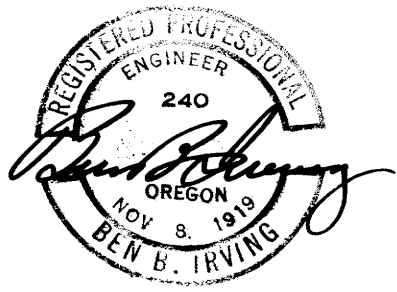

COUNTY SURVEYOR'S OFFICE
DOUGLAS COUNTY, OREGON.
SURVEY OF BLOCKS 5, 8, & 17,
DRAIN, OREGON.

BEN. B. IRVING COUNTY SURVEYOR
SURVEYED MARCH 11-23, 1948.

COUNTY SURVEYORS FILE DATA
DO NOT REMOVE FROM OFFICE

C.S. FILE 32 1/224
MAP FILE M.L.I. 69