COUNTY SURVEYORS FILE
DO NOT REMOVE FROM OFFICE

MAP FILE M-11-78

SURVEY OF
SECTION 12, T 27 S R 3 W, W.M.

SURVEYED FOR: U.S. PLYWOOD CORP. JANUARY, 1961

SURVEYED BY: T.E. SHRUM, JR. SCALE 1" = 500'

NOTE: All bearings based on solar observation

FILED
RECEIVED
FEB 7 1961
COUNTY SURVEYOR
DOUGLAS COUNTY, ORE.

REGISTERED PROFESSIONAL ENGINEER 4287 OREGON MAY 2, 1958 THOMAS E. SHRUM, JR.

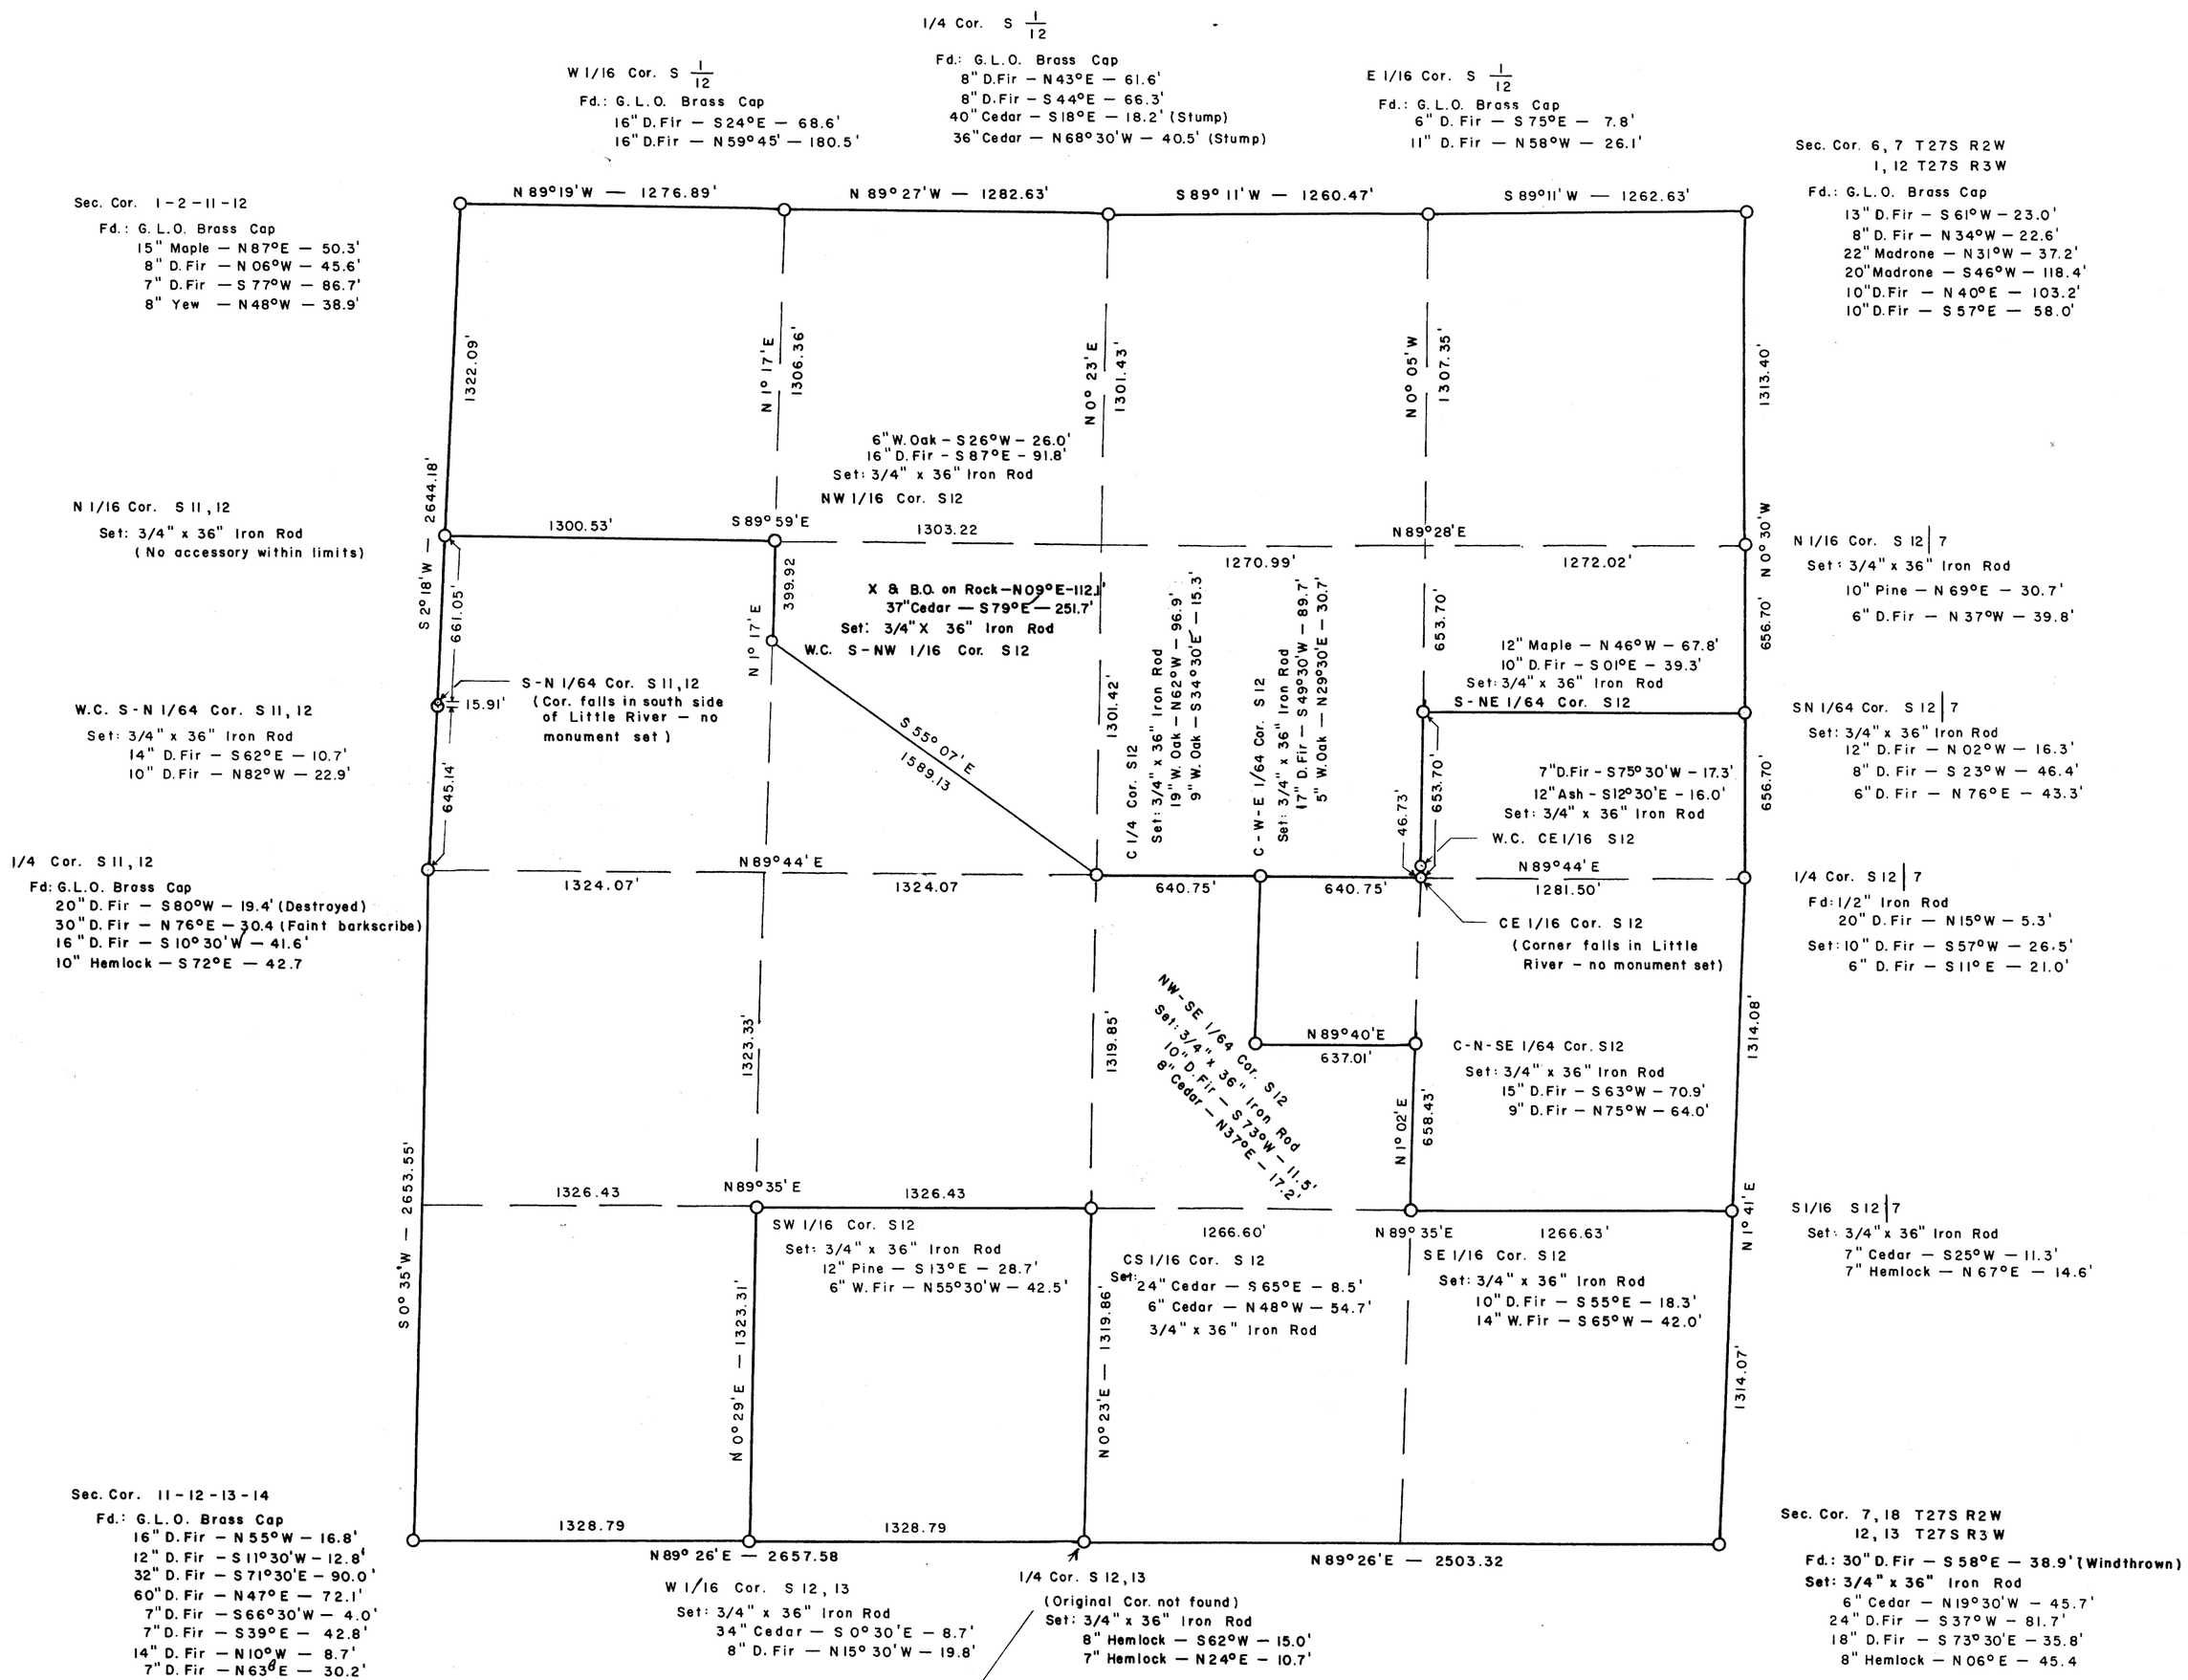

For restoration of 1/4 Cor — See attached narrative

COUNTY SURVEYORS FILE
DO NOT REMOVE FROM OFFICE

MAP FILE M-11-78