COUNTY SURVEYORS FILE DATA
DO NOT REMOVE FROM OFFICE

M 12-

SURVEY FOR DEED DESCRIPTION IN W 1/2 NW 1/4, SECTION 2, T 27 S, R 3 W

SURVEYED FOR: HANSEN LUMBER COMPANY
SURVEYED BY: G. R. LECKLIDER — ENGINEER
SEPTEMBER, 1957 **SCALE: 1" = 50'**

REGISTERED PROFESSIONAL ENGINEER 4079 OREGON OCT. 15, 1956 G. ROBERT LECKLIDER

G. Robert Lecklider

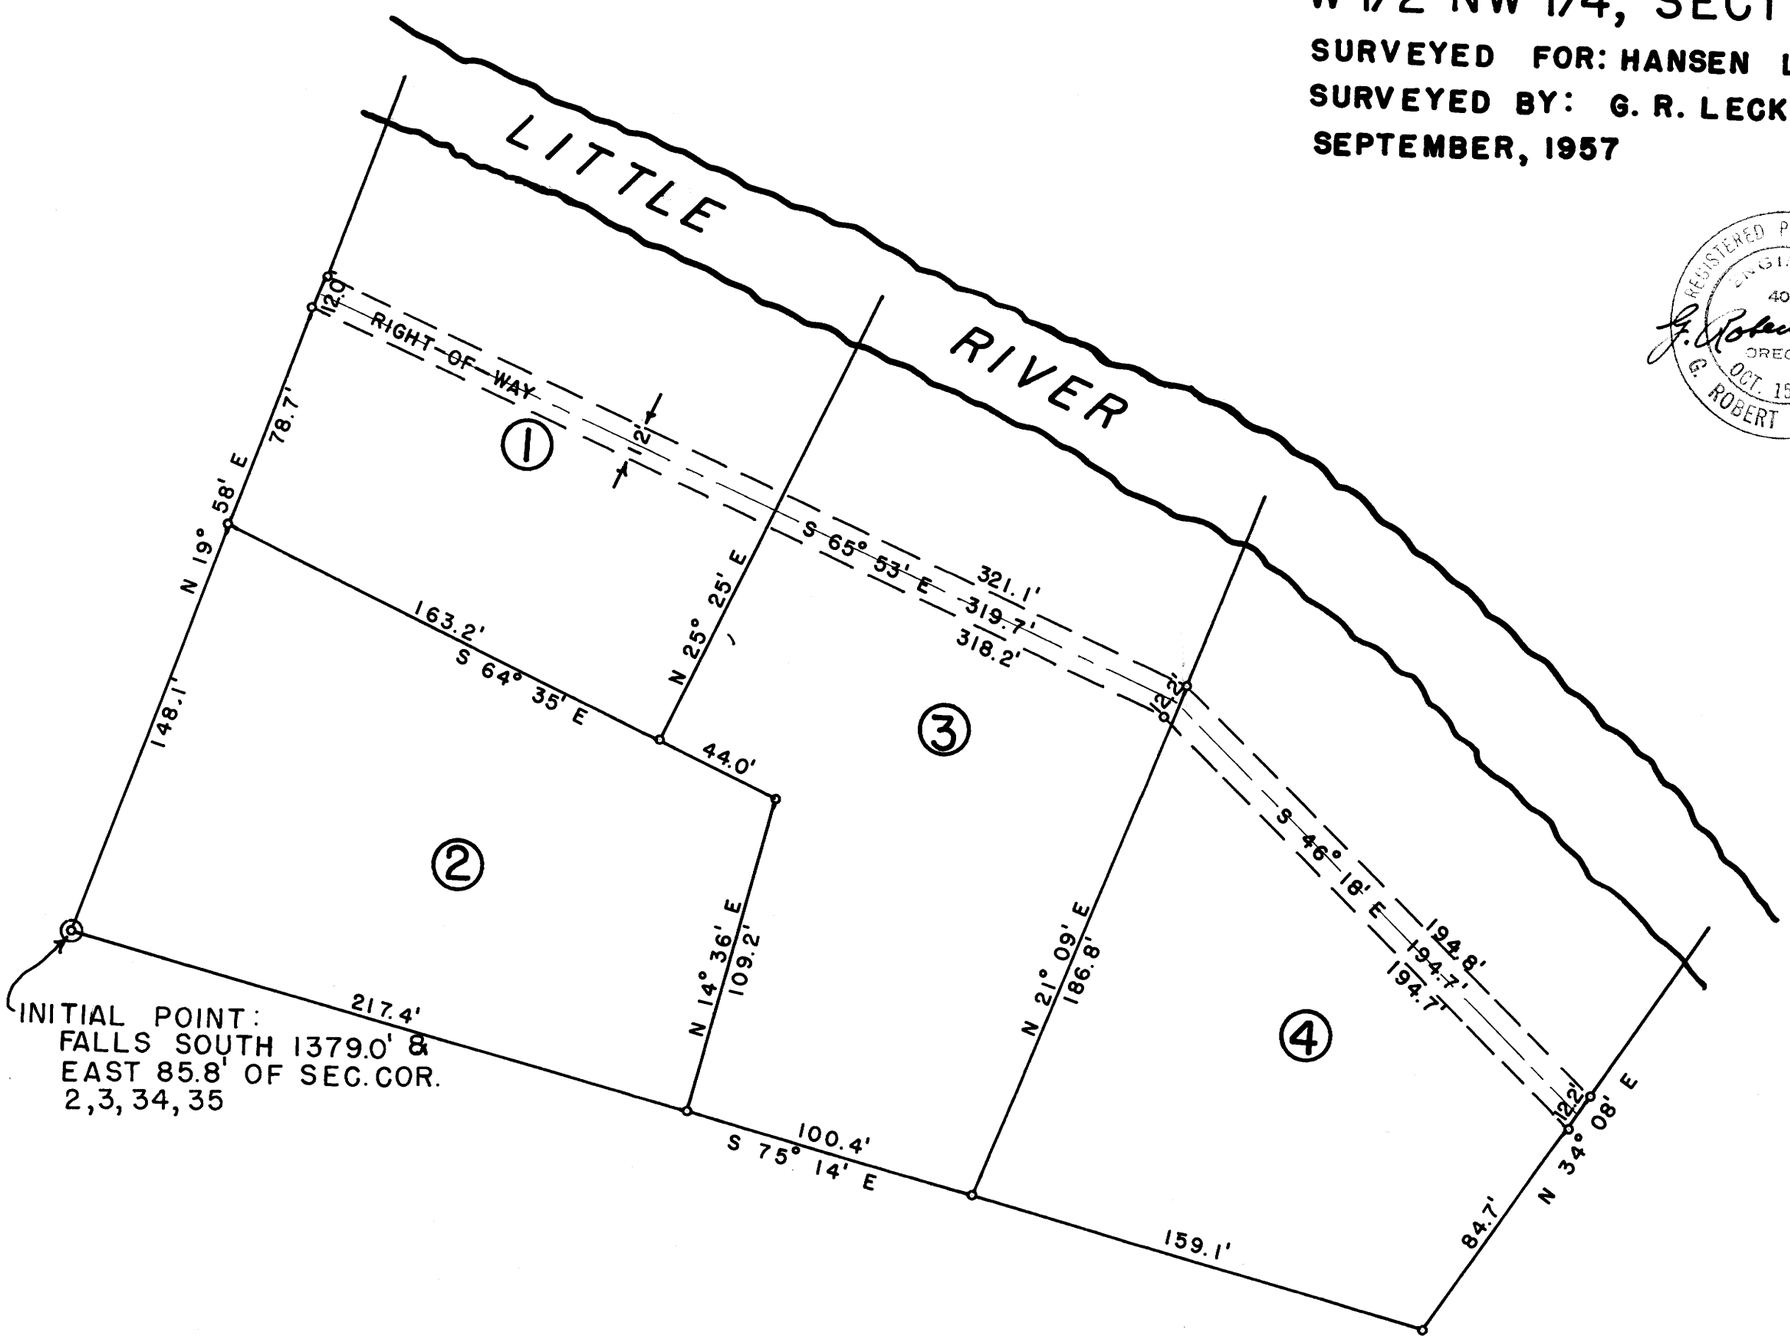

FILED
RECEIVED
OCT 9 1957
COUNTY SURVEYOR
DOUGLAS COUNTY, ORE.

MAP FILE M12-18

C.S. File No. 42/307