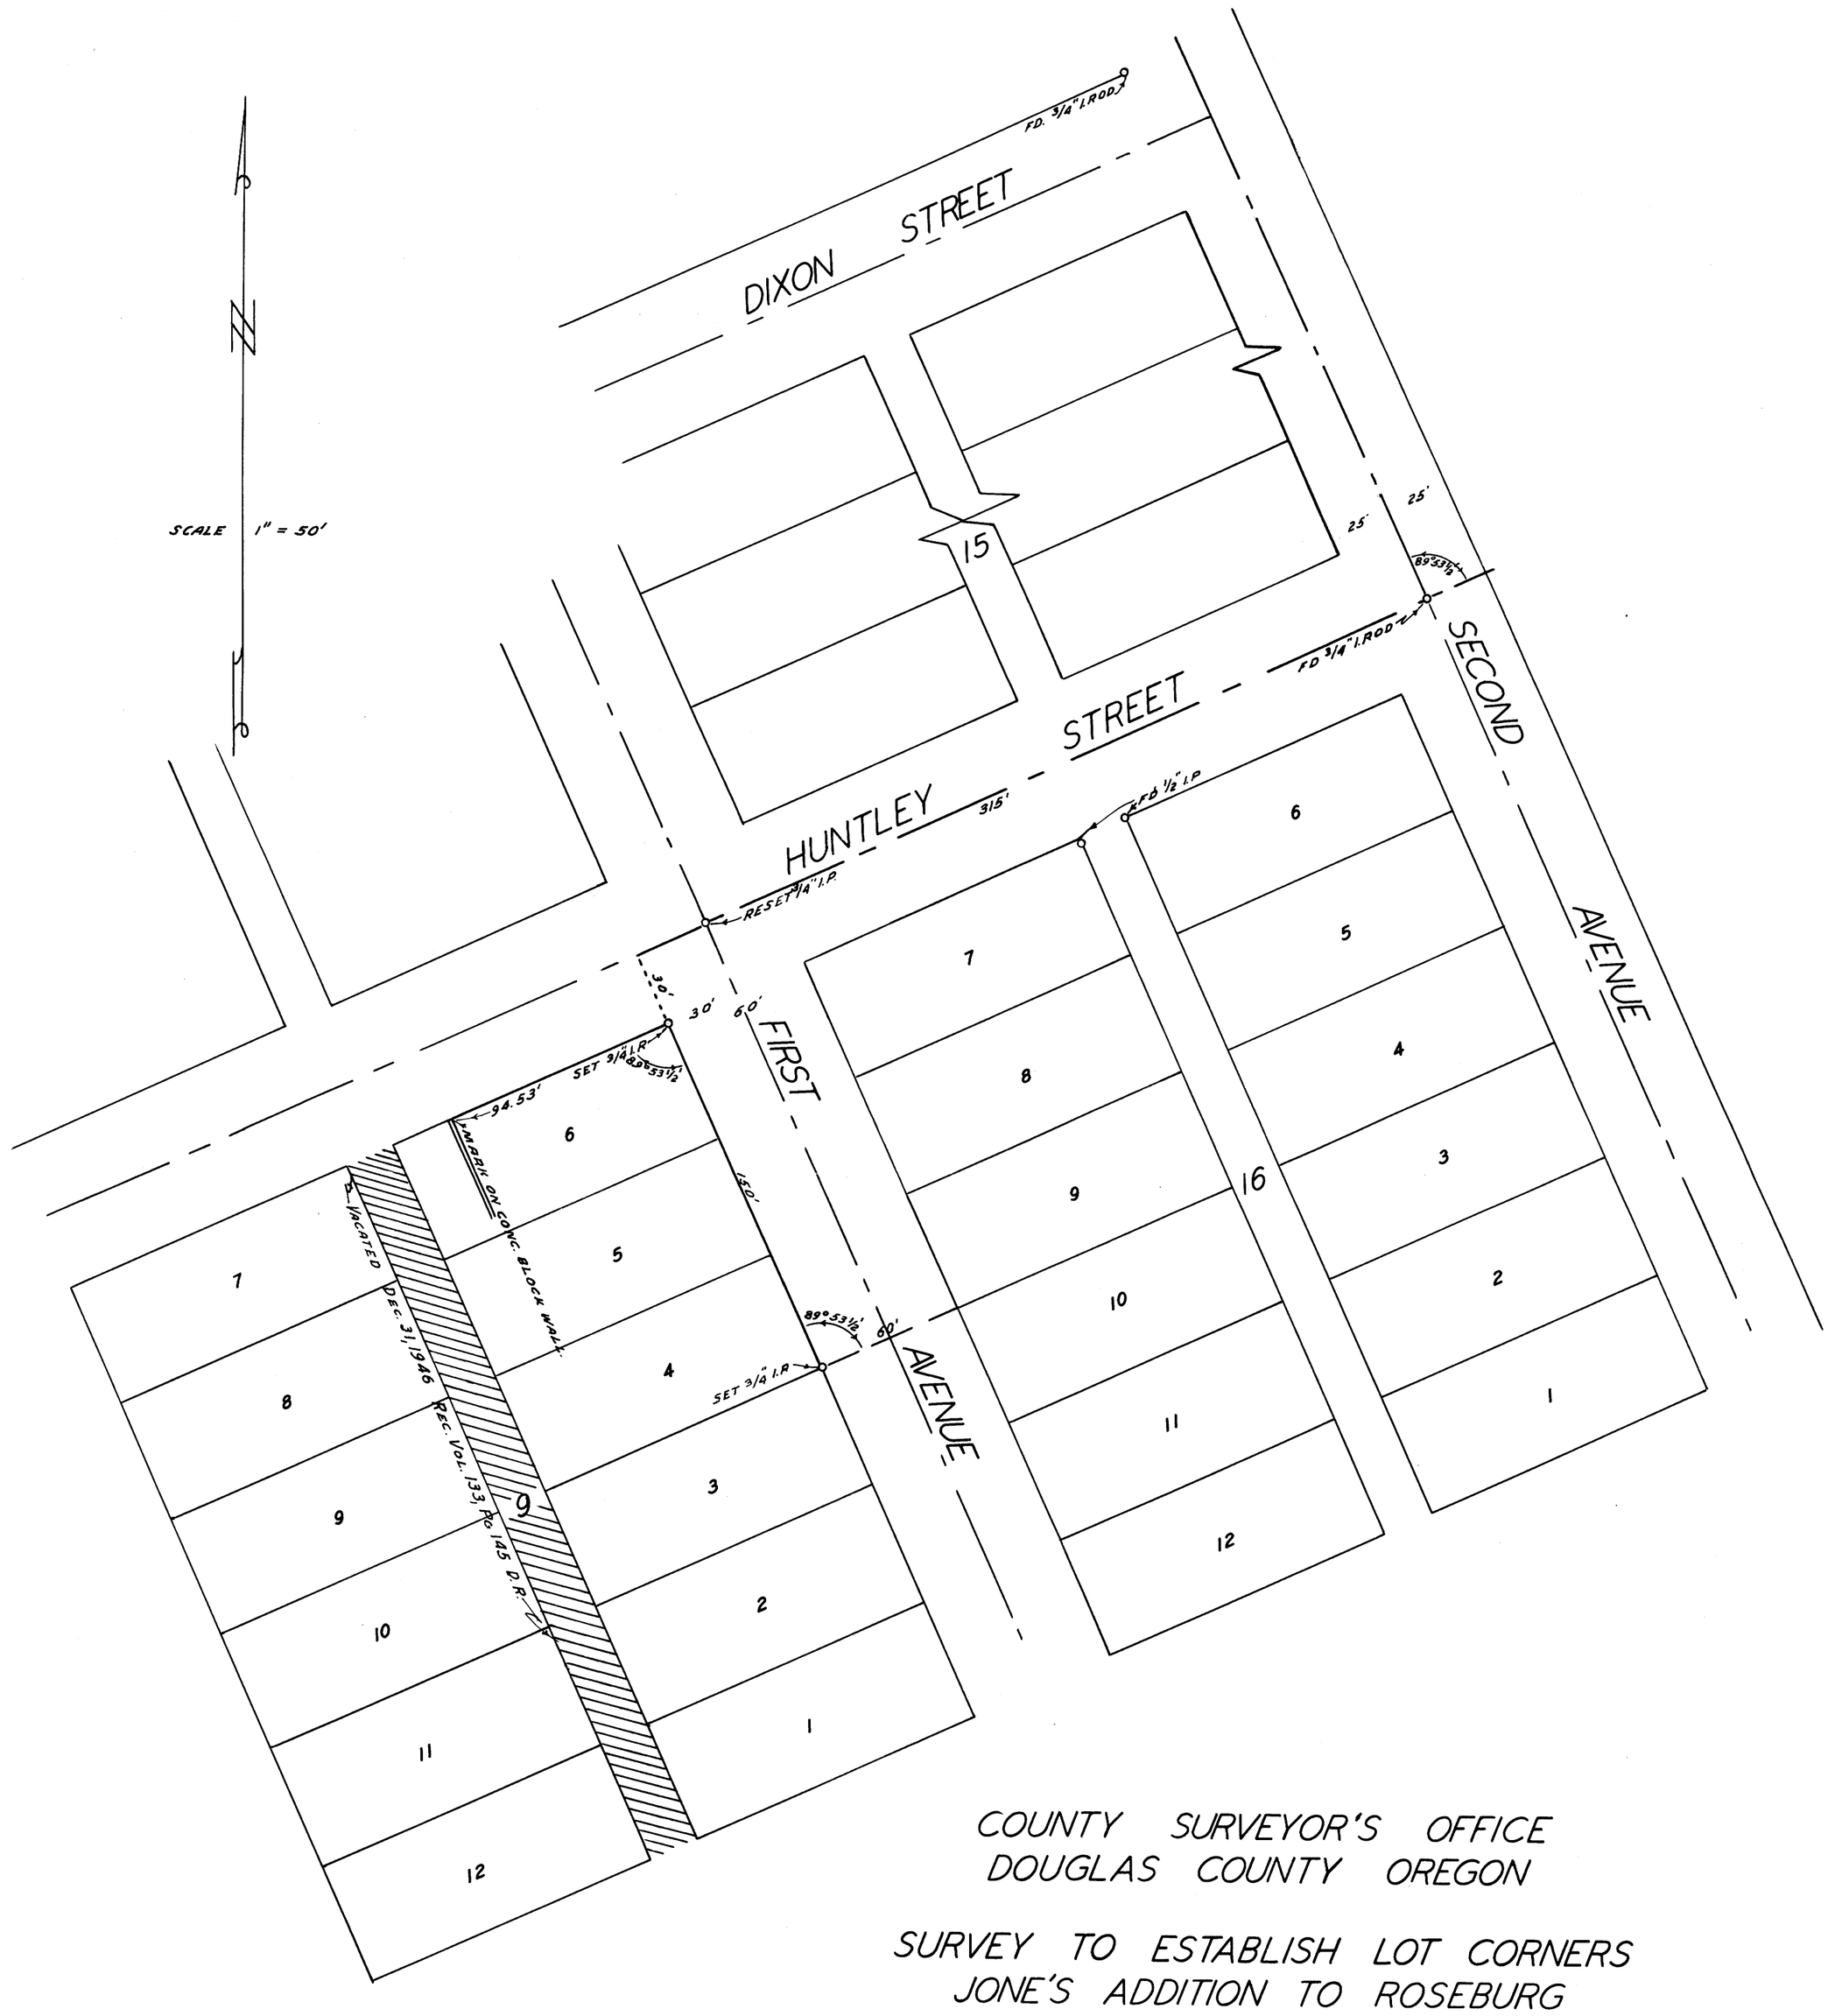

COUNTY SURVEYOR'S OFFICE
DOUGLAS COUNTY OREGON

SURVEY TO ESTABLISH LOT CORNERS
JONE'S ADDITION TO ROSEBURG
FOR ROSETTA LODGE

BEN B. IRVING COUNTY SURVEYOR
SURVEYED APRIL 13, 1954

COUNTY SURVEYORS FILE DATA
DO NOT REMOVE FROM OFFICE

C.S. FILE 44/146
MAP FILE M 12-3
14/27/5
MAP FILE M 12 - 3

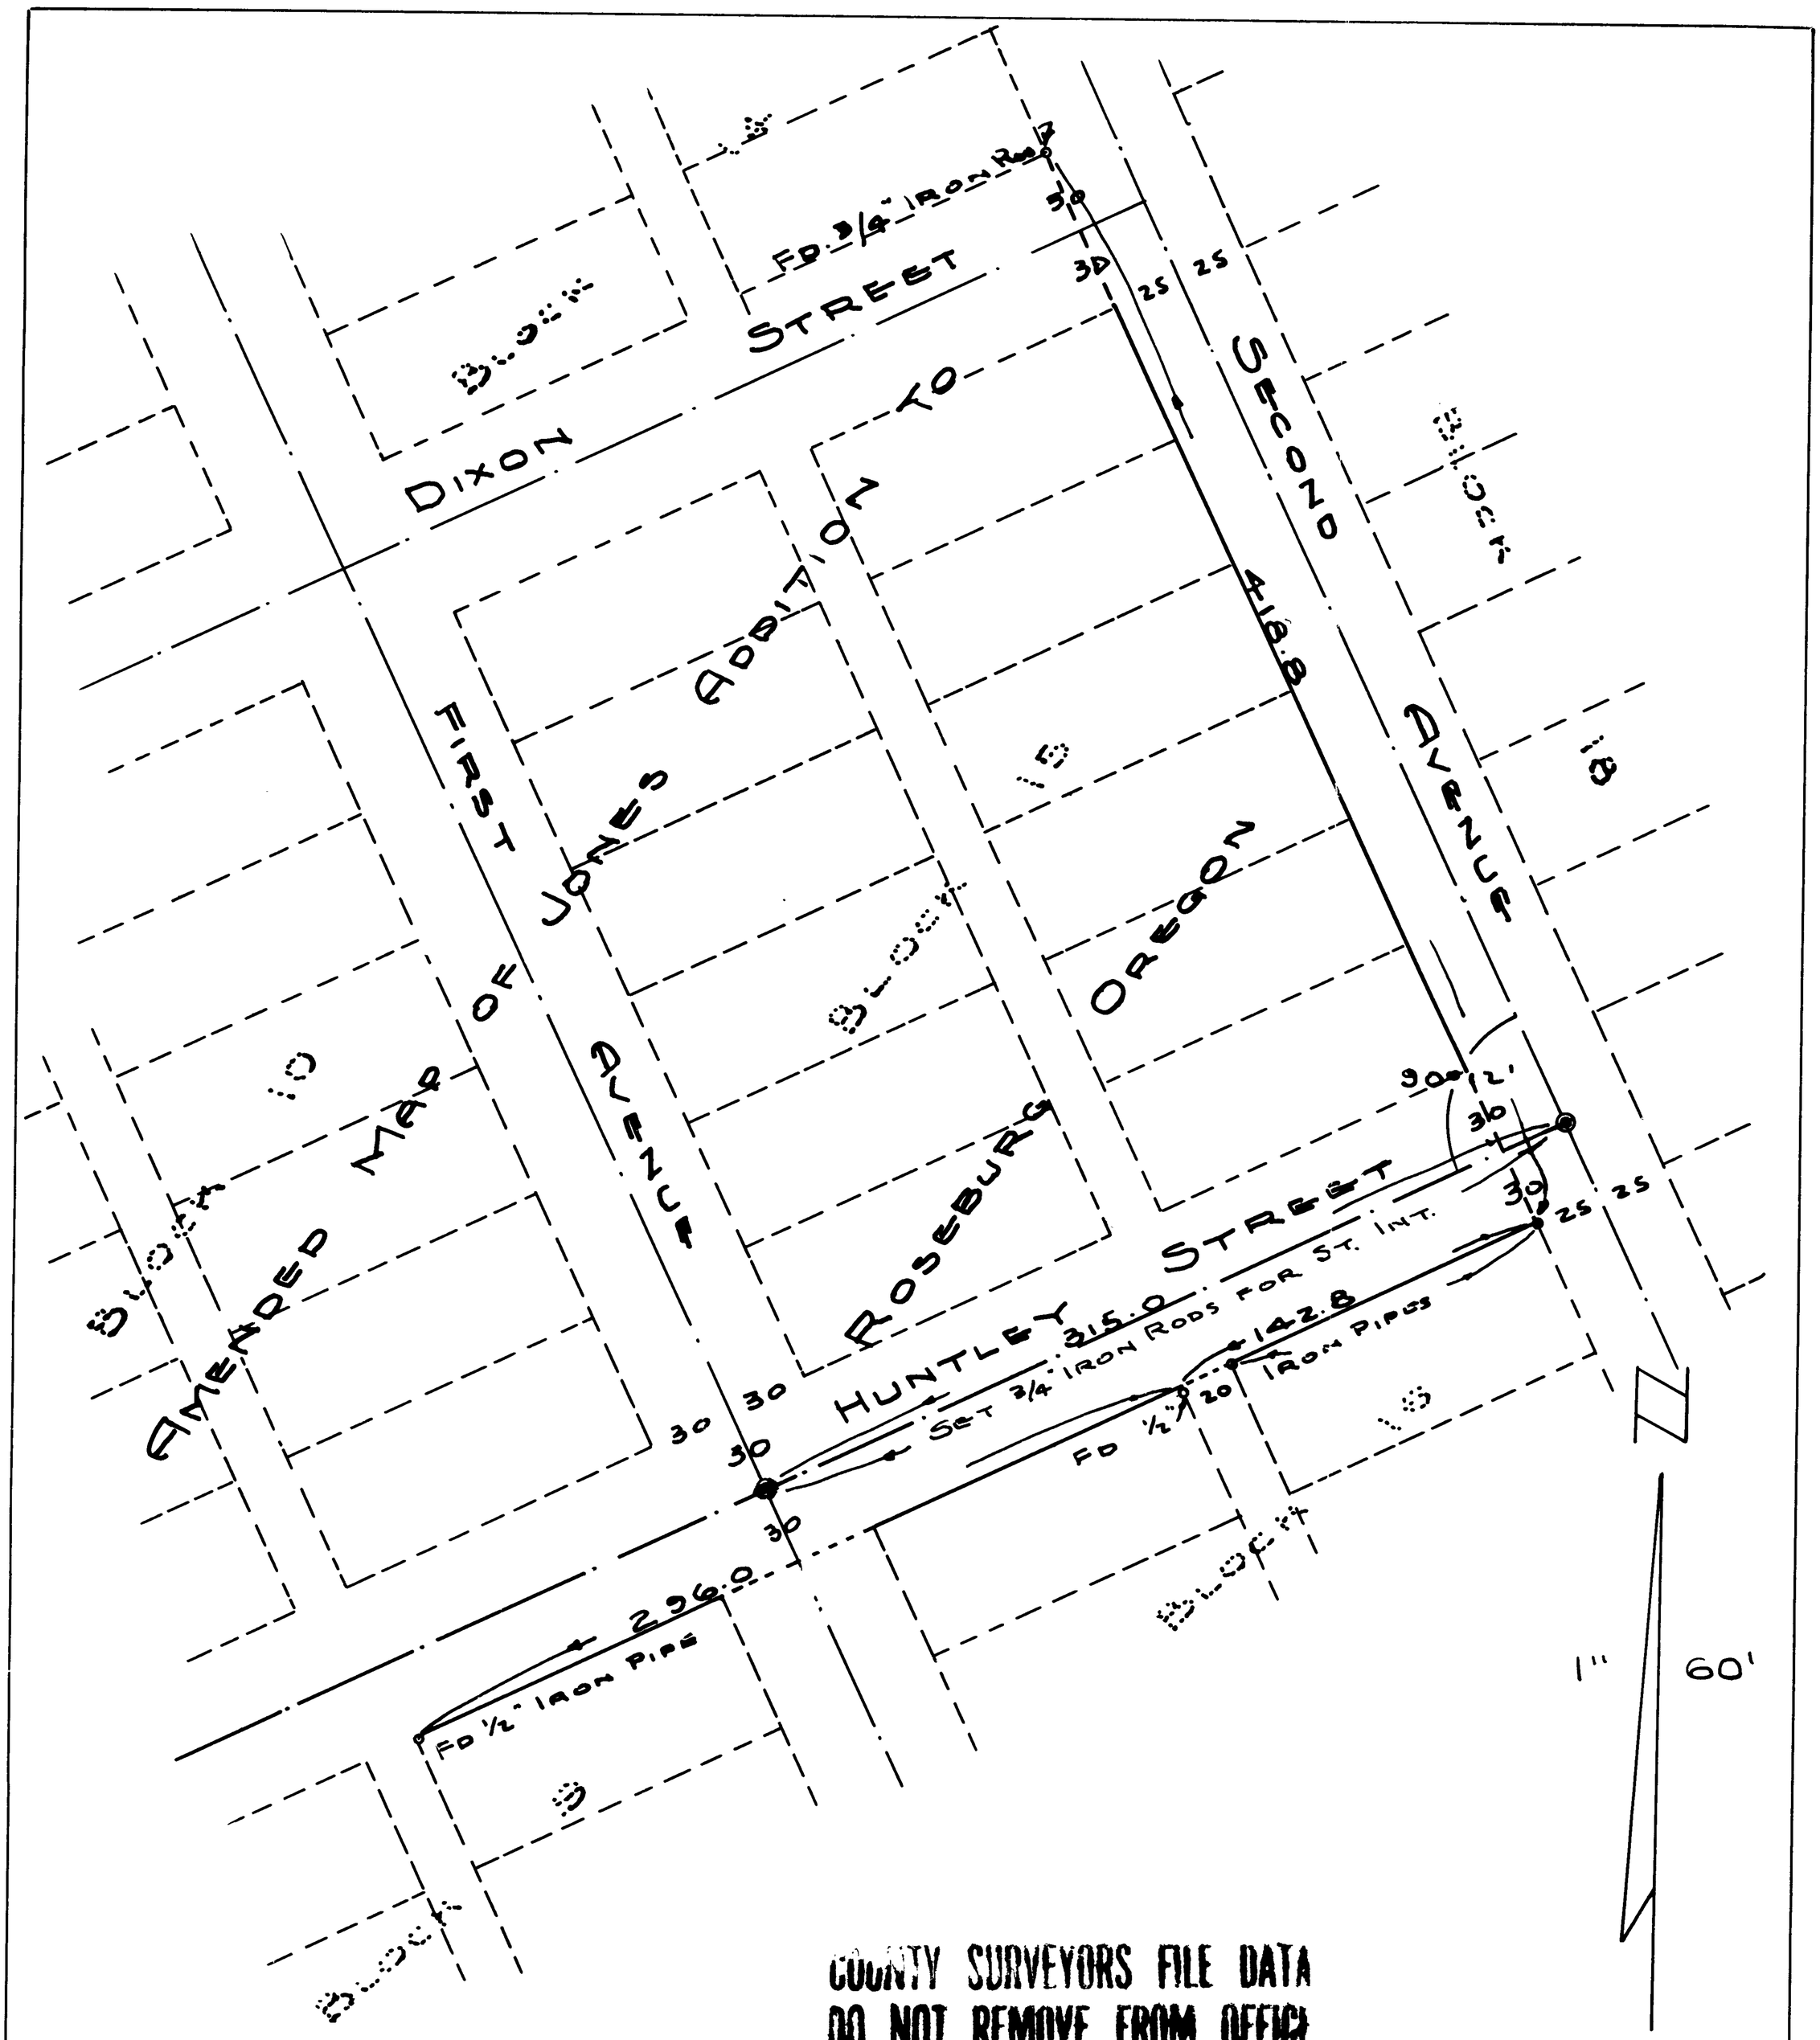

COUNTY SURVEYORS FILE DATA
DO NOT REMOVE FROM OFFICE

COUNTY SURVEYOR'S OFFICE
DOUGLAS COUNTY OREGON
SURVEY FOR LOCATION OF HUNTLEY ST.
JONES ADD'N. TO ROSEBURG, ORE.

T 27 S R 5 W W.M.

Arthur R Evans

BEN B. IRVING, REG. ENG'R. CO. SURVEYOR
SURVEYED & PLATTED JULY 1951, BY
A.R. EVANS, REG. ENG'R. DEP. CO. SURVEYOR

THIS IS C.S. FILE ONLY 6/30/94 THIS NUMBER WAS ASSIGNED TWICE ~~M12-4~~
C.S. FILE 44/146