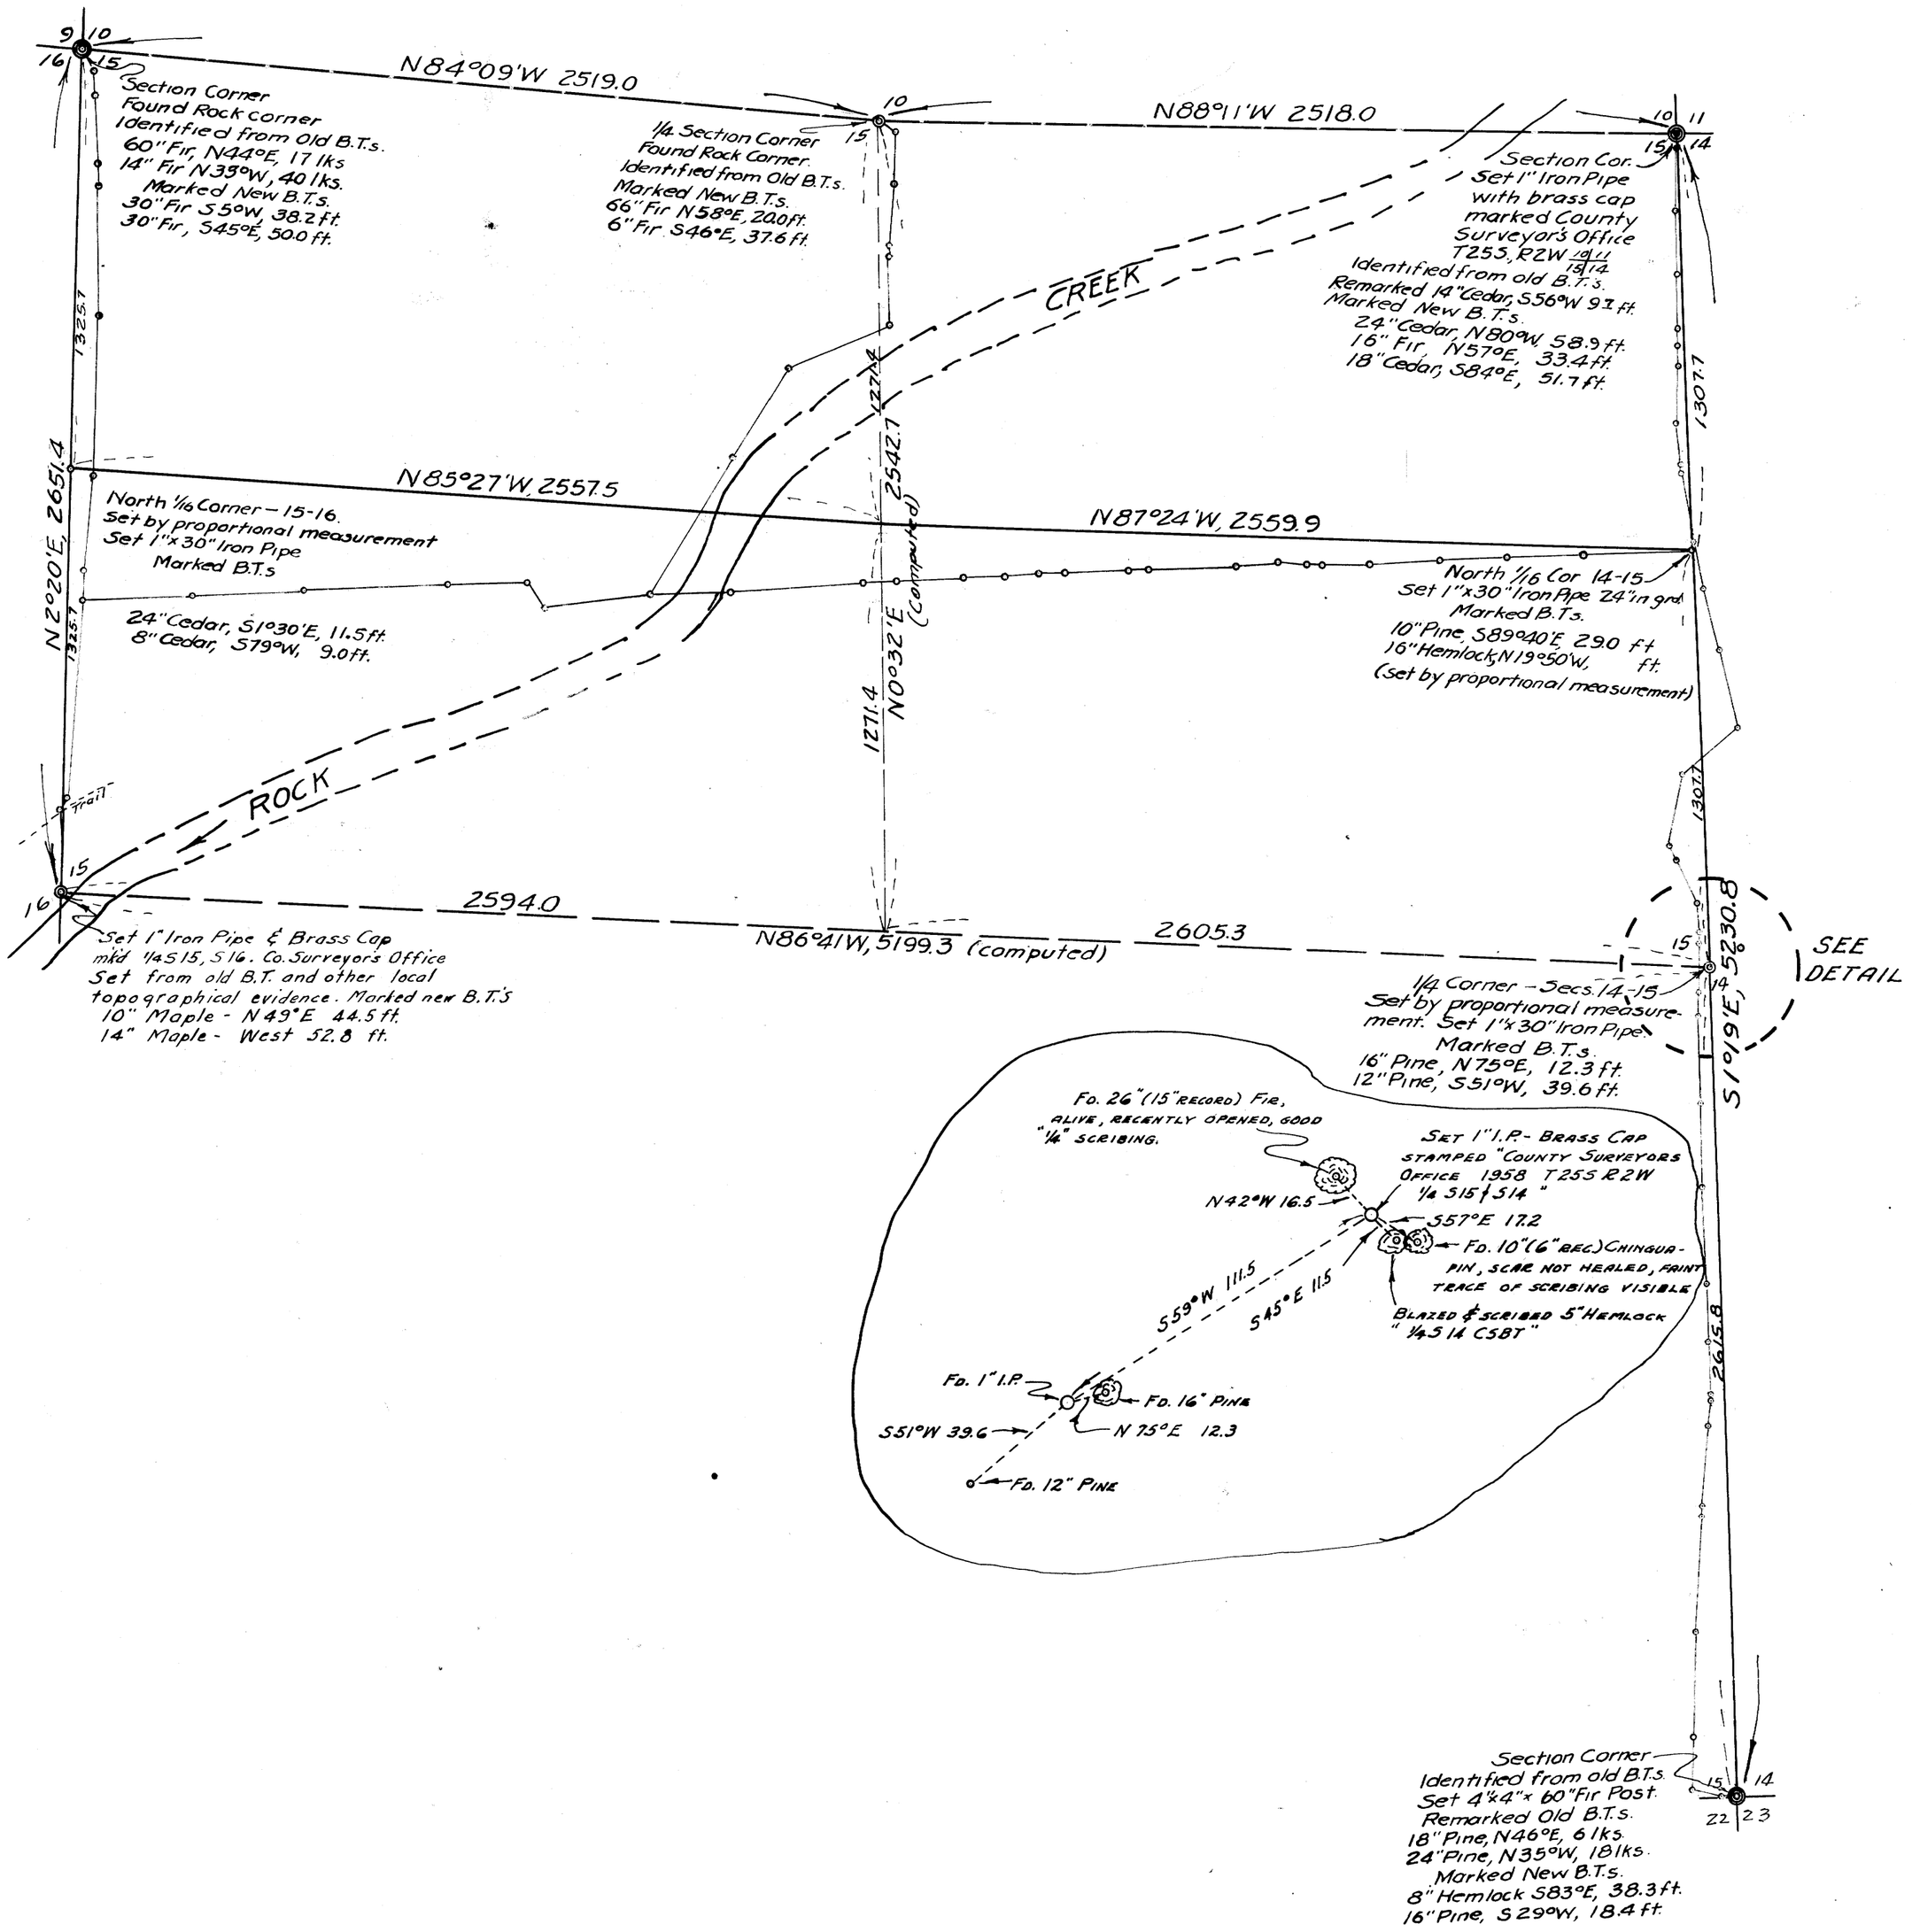

COUNTY SURVEYOR'S OFFICE
DOUGLAS COUNTY OREGON

SURVEY OF THE NORTH 1/2 OF THE NORTH 1/2, SEC. 15, T25S., R2W. W.M.

BEN B IRVING COUNTY SURVEYOR
SURVEYED FEBRUARY, 1948
SCALE 1" = 400'

THIS MAP REVISED BY ADDING DETAIL SHOWING RELATION OF TRUE ORIGINAL 1/4 COR SEC. 15-14 TO PROPORTIONED COR, AS OF 7/14/58.
F.M. DARBY

COUNTY SURVEYOR'S FILE DATA
DO NOT REMOVE FROM OFFICE

MAP FILE M 12-34

FILE 169 DRAWER 39