C.S. FILE # 41/54
MAP FILE M 12-35

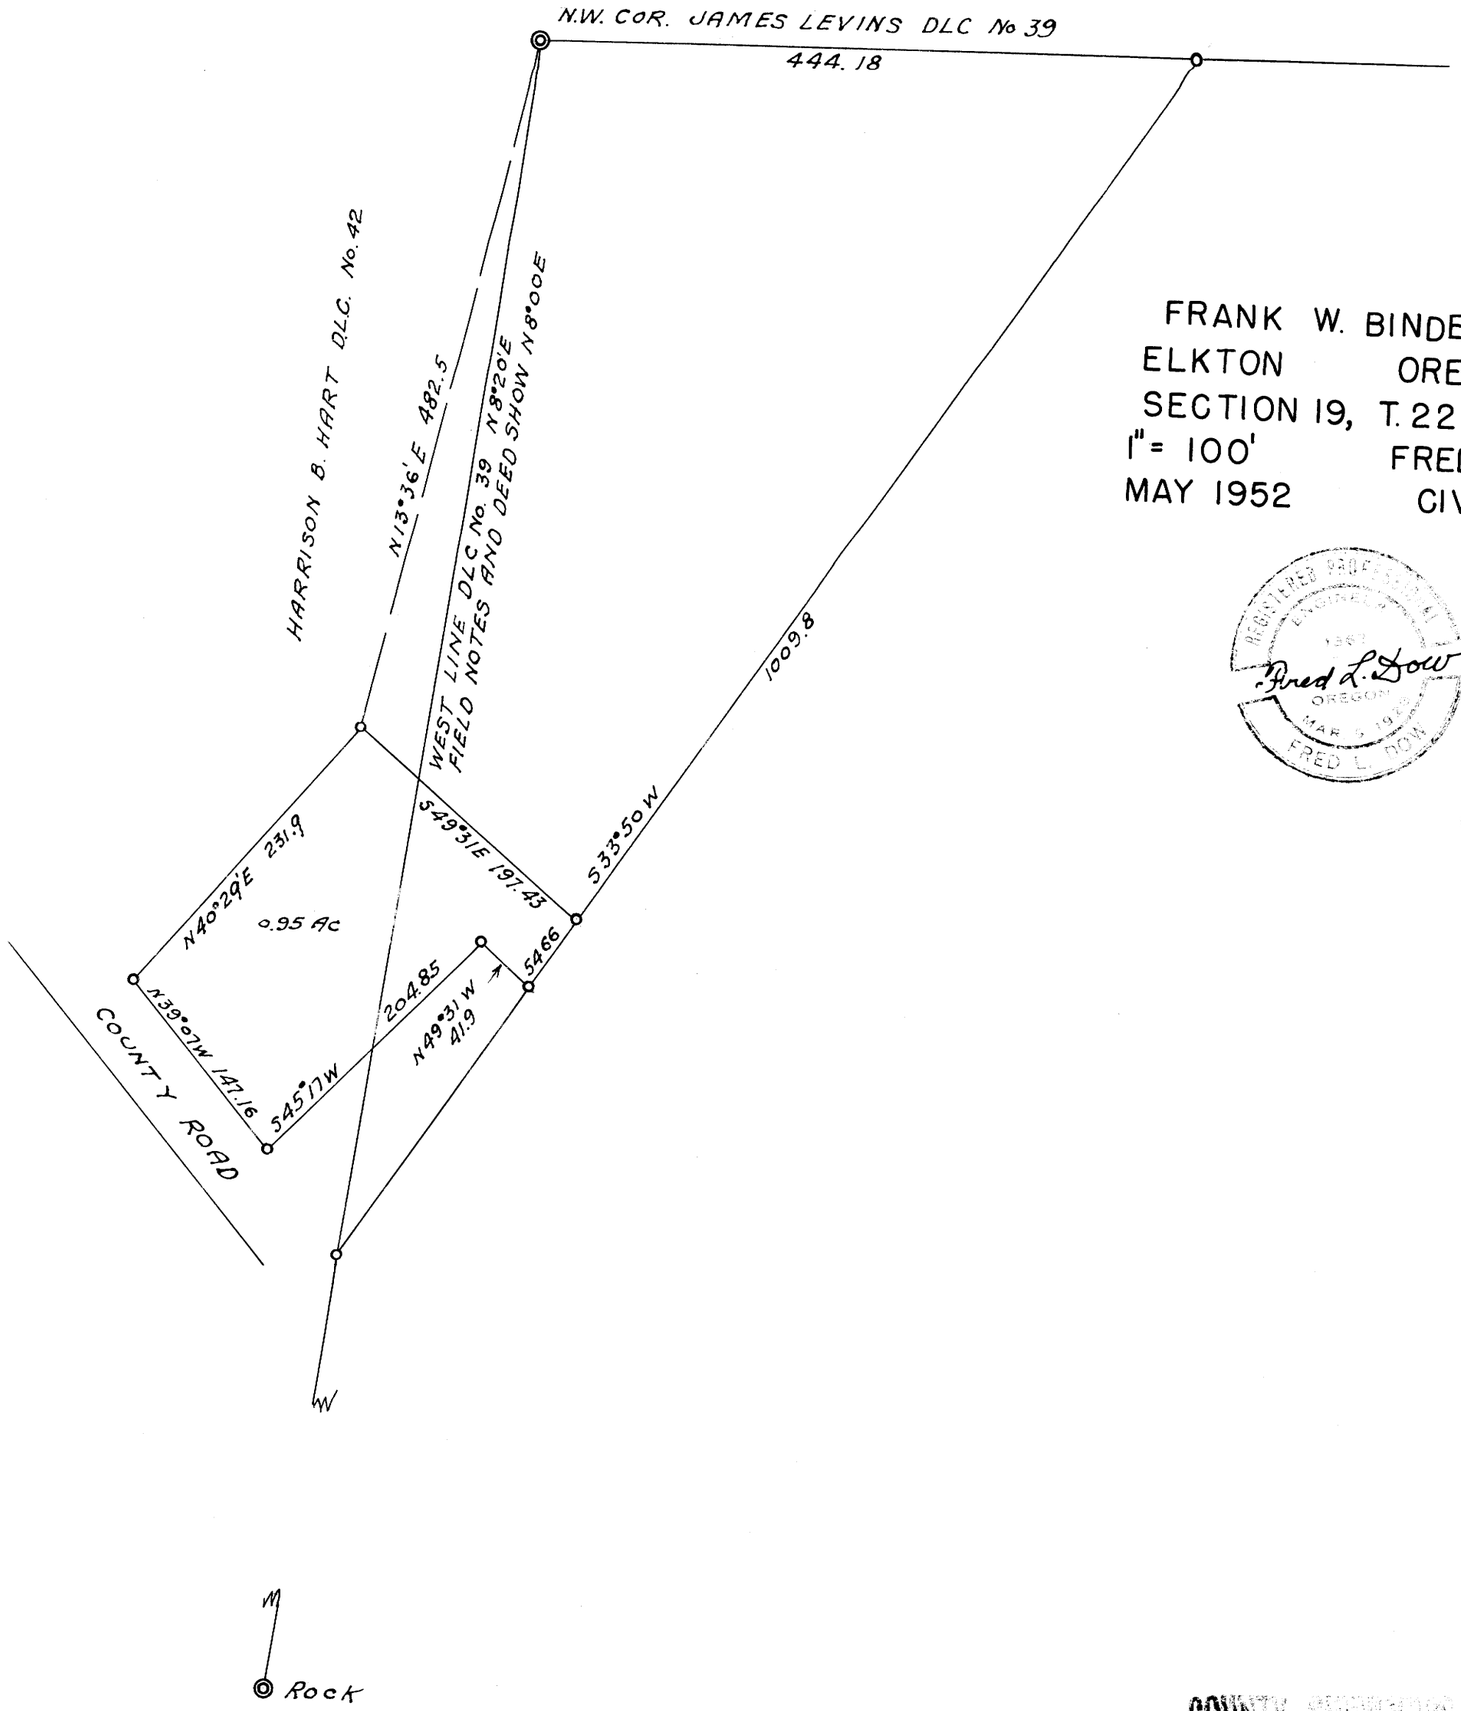

FRANK W. BINDER
ELKTON OREGON
SECTION 19, T. 22 S.R.7 W.
1" = 100'
MAY 1952
FRED L. DOW
CIVIL ENG.

REGISTERED PROFESSIONAL ENGINEER
1952
Fred L. Dow
OREGON
MAR 5 1952
FRED L. DOW

COUNTY SURVEYOR
DOUGLAS COUNTY, ORE.

COUNTY SURVEYORS FILE DATA
DO NOT REMOVE FROM OFFICE

41/54

M 12-35

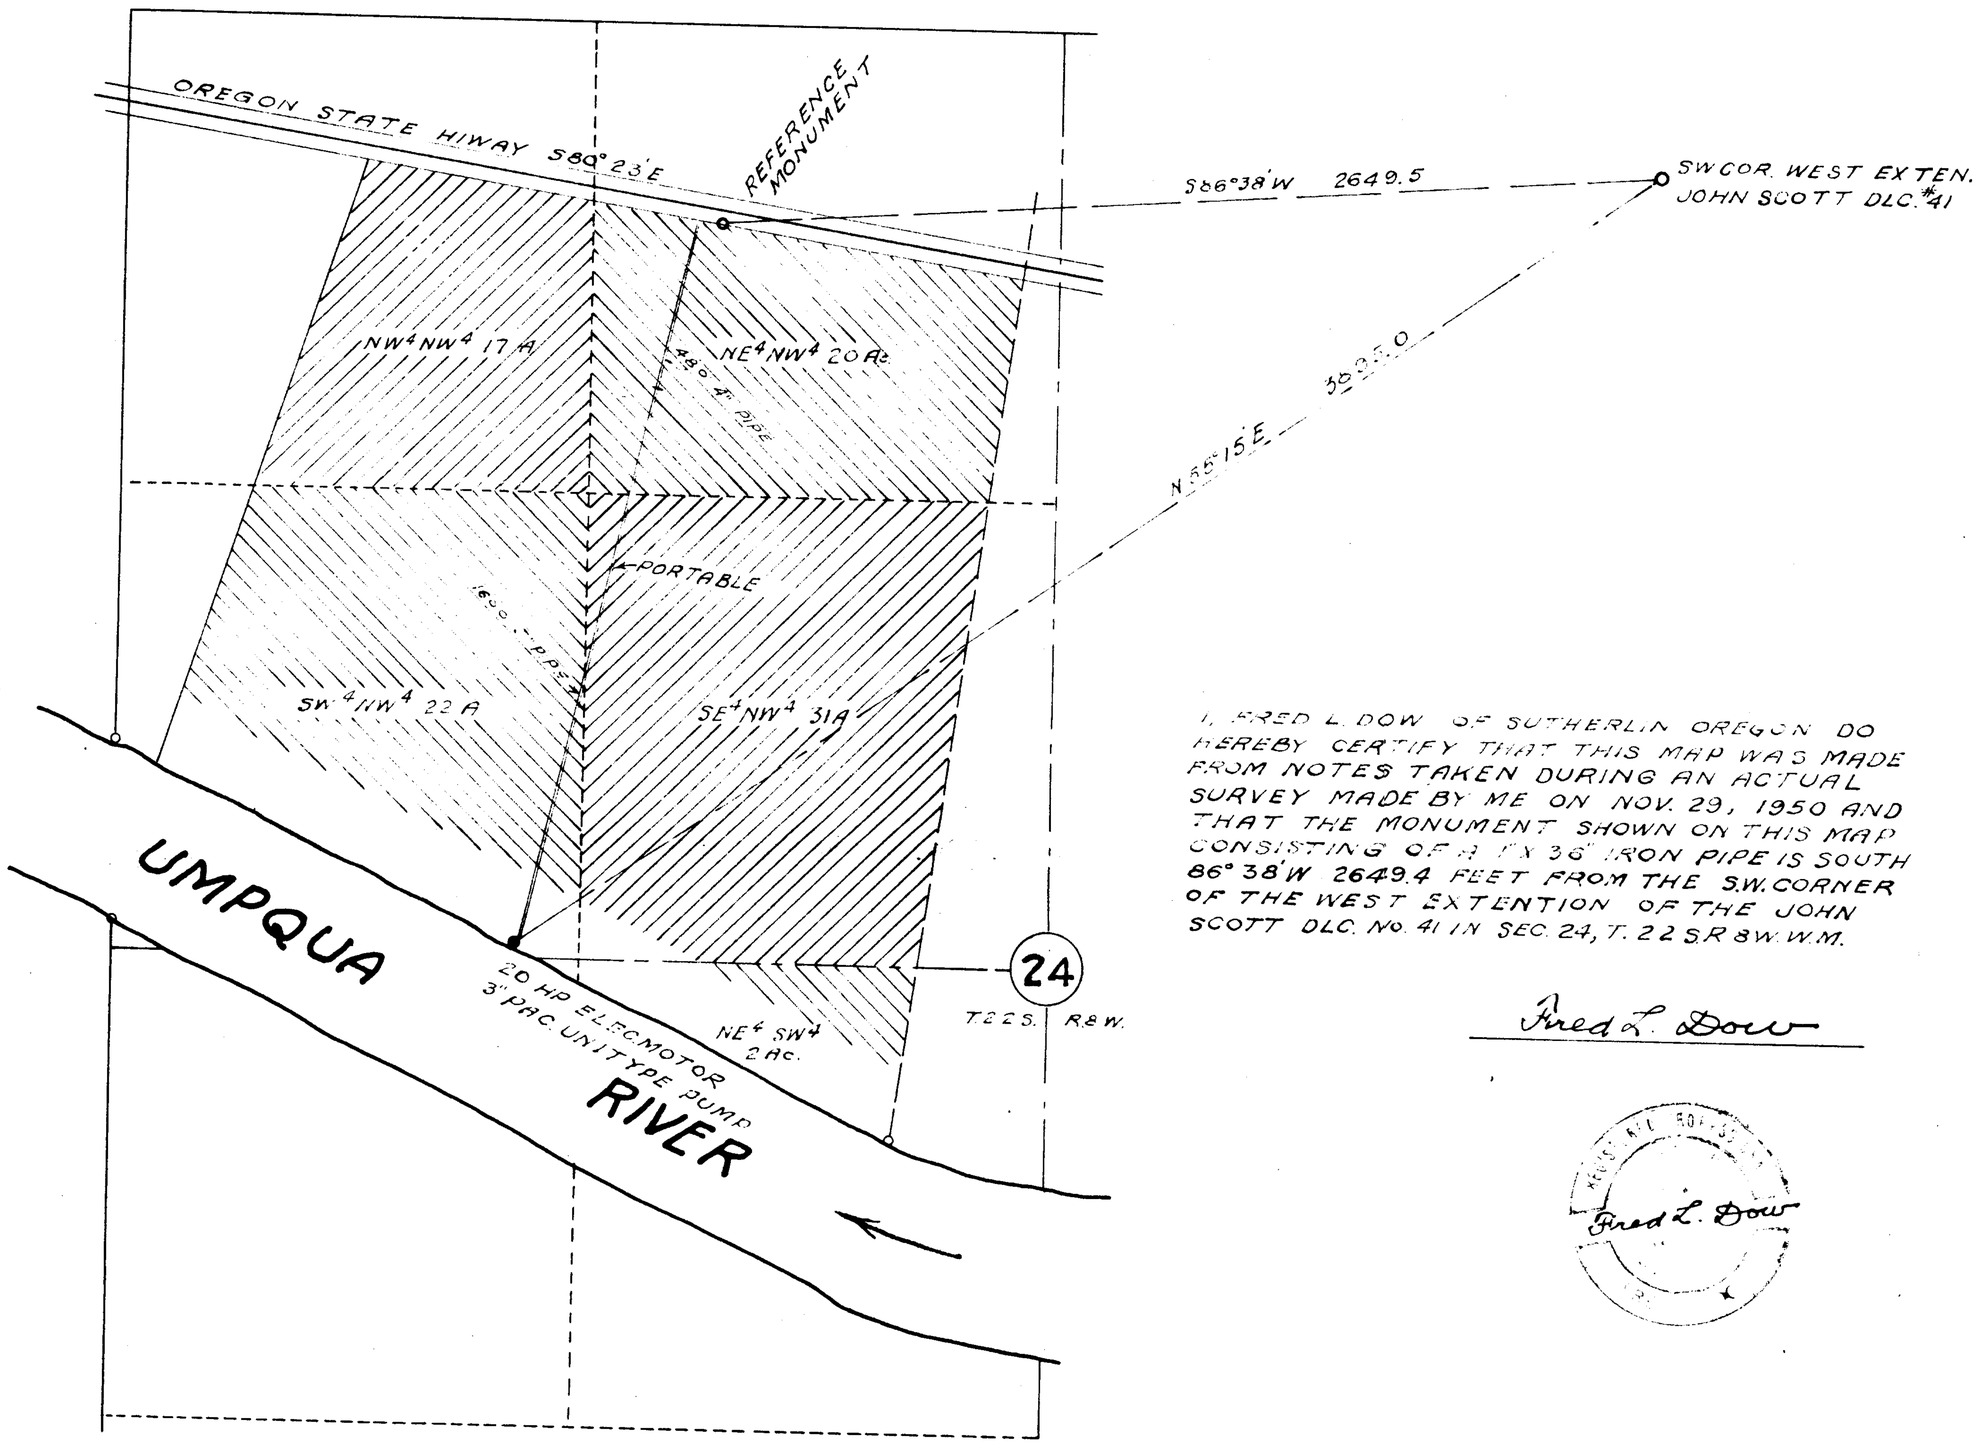

I, FRED L. DOW OF SUTHERLIN OREGON DO HEREBY CERTIFY THAT THIS MAP WAS MADE FROM NOTES TAKEN DURING AN ACTUAL SURVEY MADE BY ME ON NOV. 29, 1950 AND THAT THE MONUMENT SHOWN ON THIS MAP CONSISTING OF A 1" X 36" IRON PIPE IS SOUTH 86° 38' W 2649.4 FEET FROM THE S.W. CORNER OF THE WEST EXTENTION OF THE JOHN SCOTT DLC. No. 41 IN SEC. 24, T. 22 S. R 8 W. W.M.

Fred L. Dow

Fred L. Dow

FRANK W. BINDER
ELKTON ORE

SCALE 1"=400'

CS 41/54-1