C.S. 50-10
M 12-41

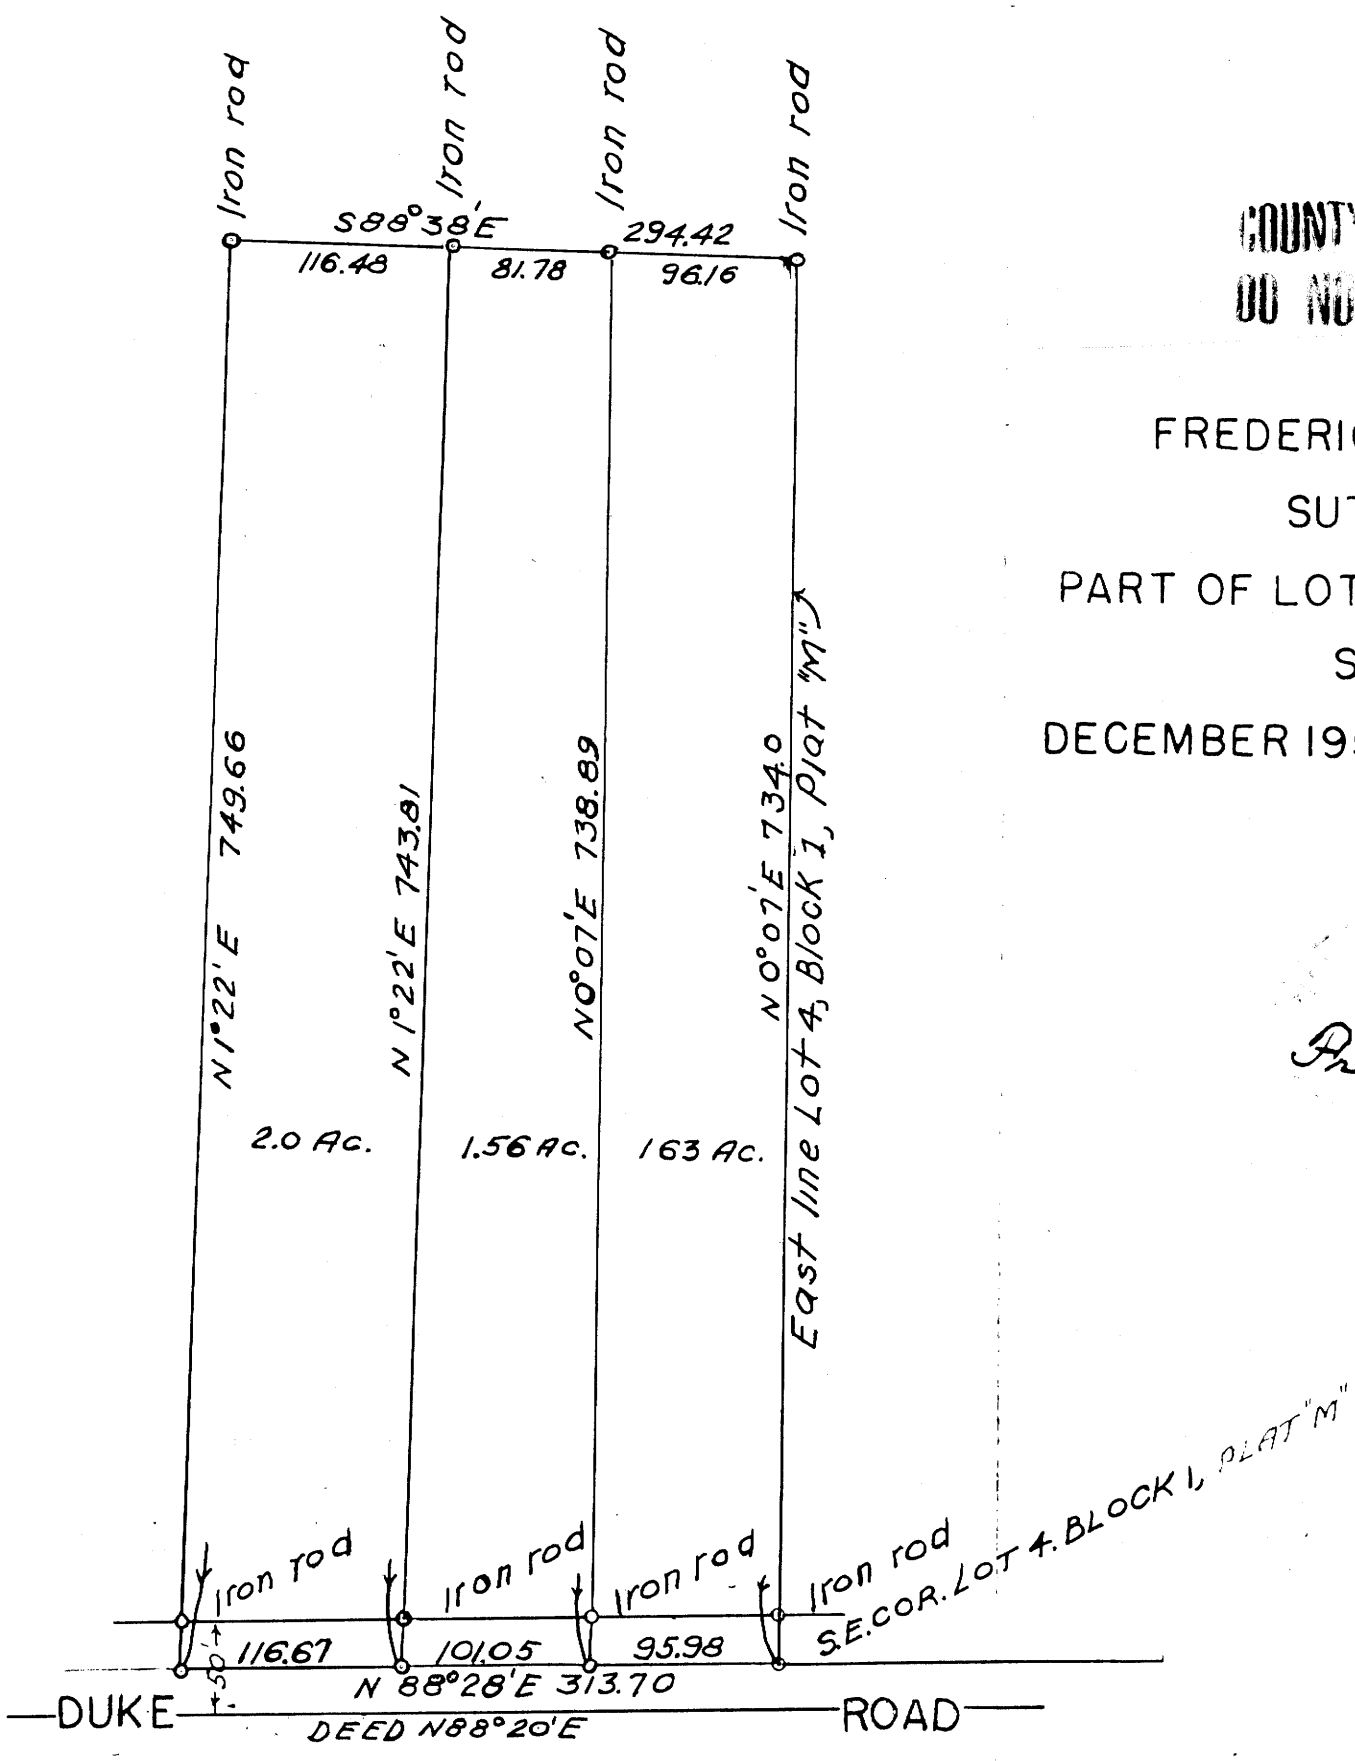

COUNTY SURVEYORS FILE DATA
DO NOT REMOVE FROM OFFICE

FREDERICK E. BLAKLEY

SUTHERLIN

PART OF LOT 4, BLOCK 1, PLAT "M"

S.L.& W. Co.

DECEMBER 1954 SCALE 1"=100'

Fred E. Blakley

THIS COPY MADE FROM
A XEROX 2510
DATE 5-25-89

C.S. 50/10
M 12-41