


MAP
OF
PORTION OF DARREL CARTER PROPERTY
IN
SECTION 24 T_{30S}-R_{6W} WM.
Scale - 1"=50'
Sept. 1958.

COUNTY SURVEYORS FILE DATA
DO NOT REMOVE FROM OFFICE

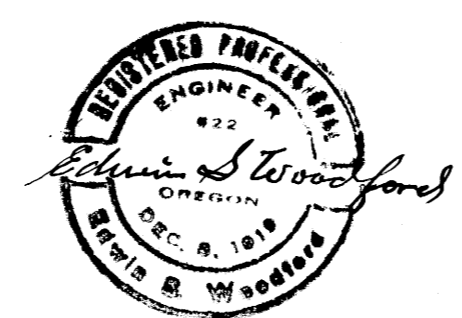

RECEIVED
SEP 10 1958
COUNTY SURVEYOR
DOUGLAS COUNTY, ORE.
SUPERSEDED OLD SURVEY

MAP FILE M12-53