MAP FILE M 12 - 55

Found 4 original bearing trees
B.T.'s for sections 22 & 23
dead & down
B.T. for section 26 dead but standing
B.T. for section 27 alive & standing
Re-established corner as shown

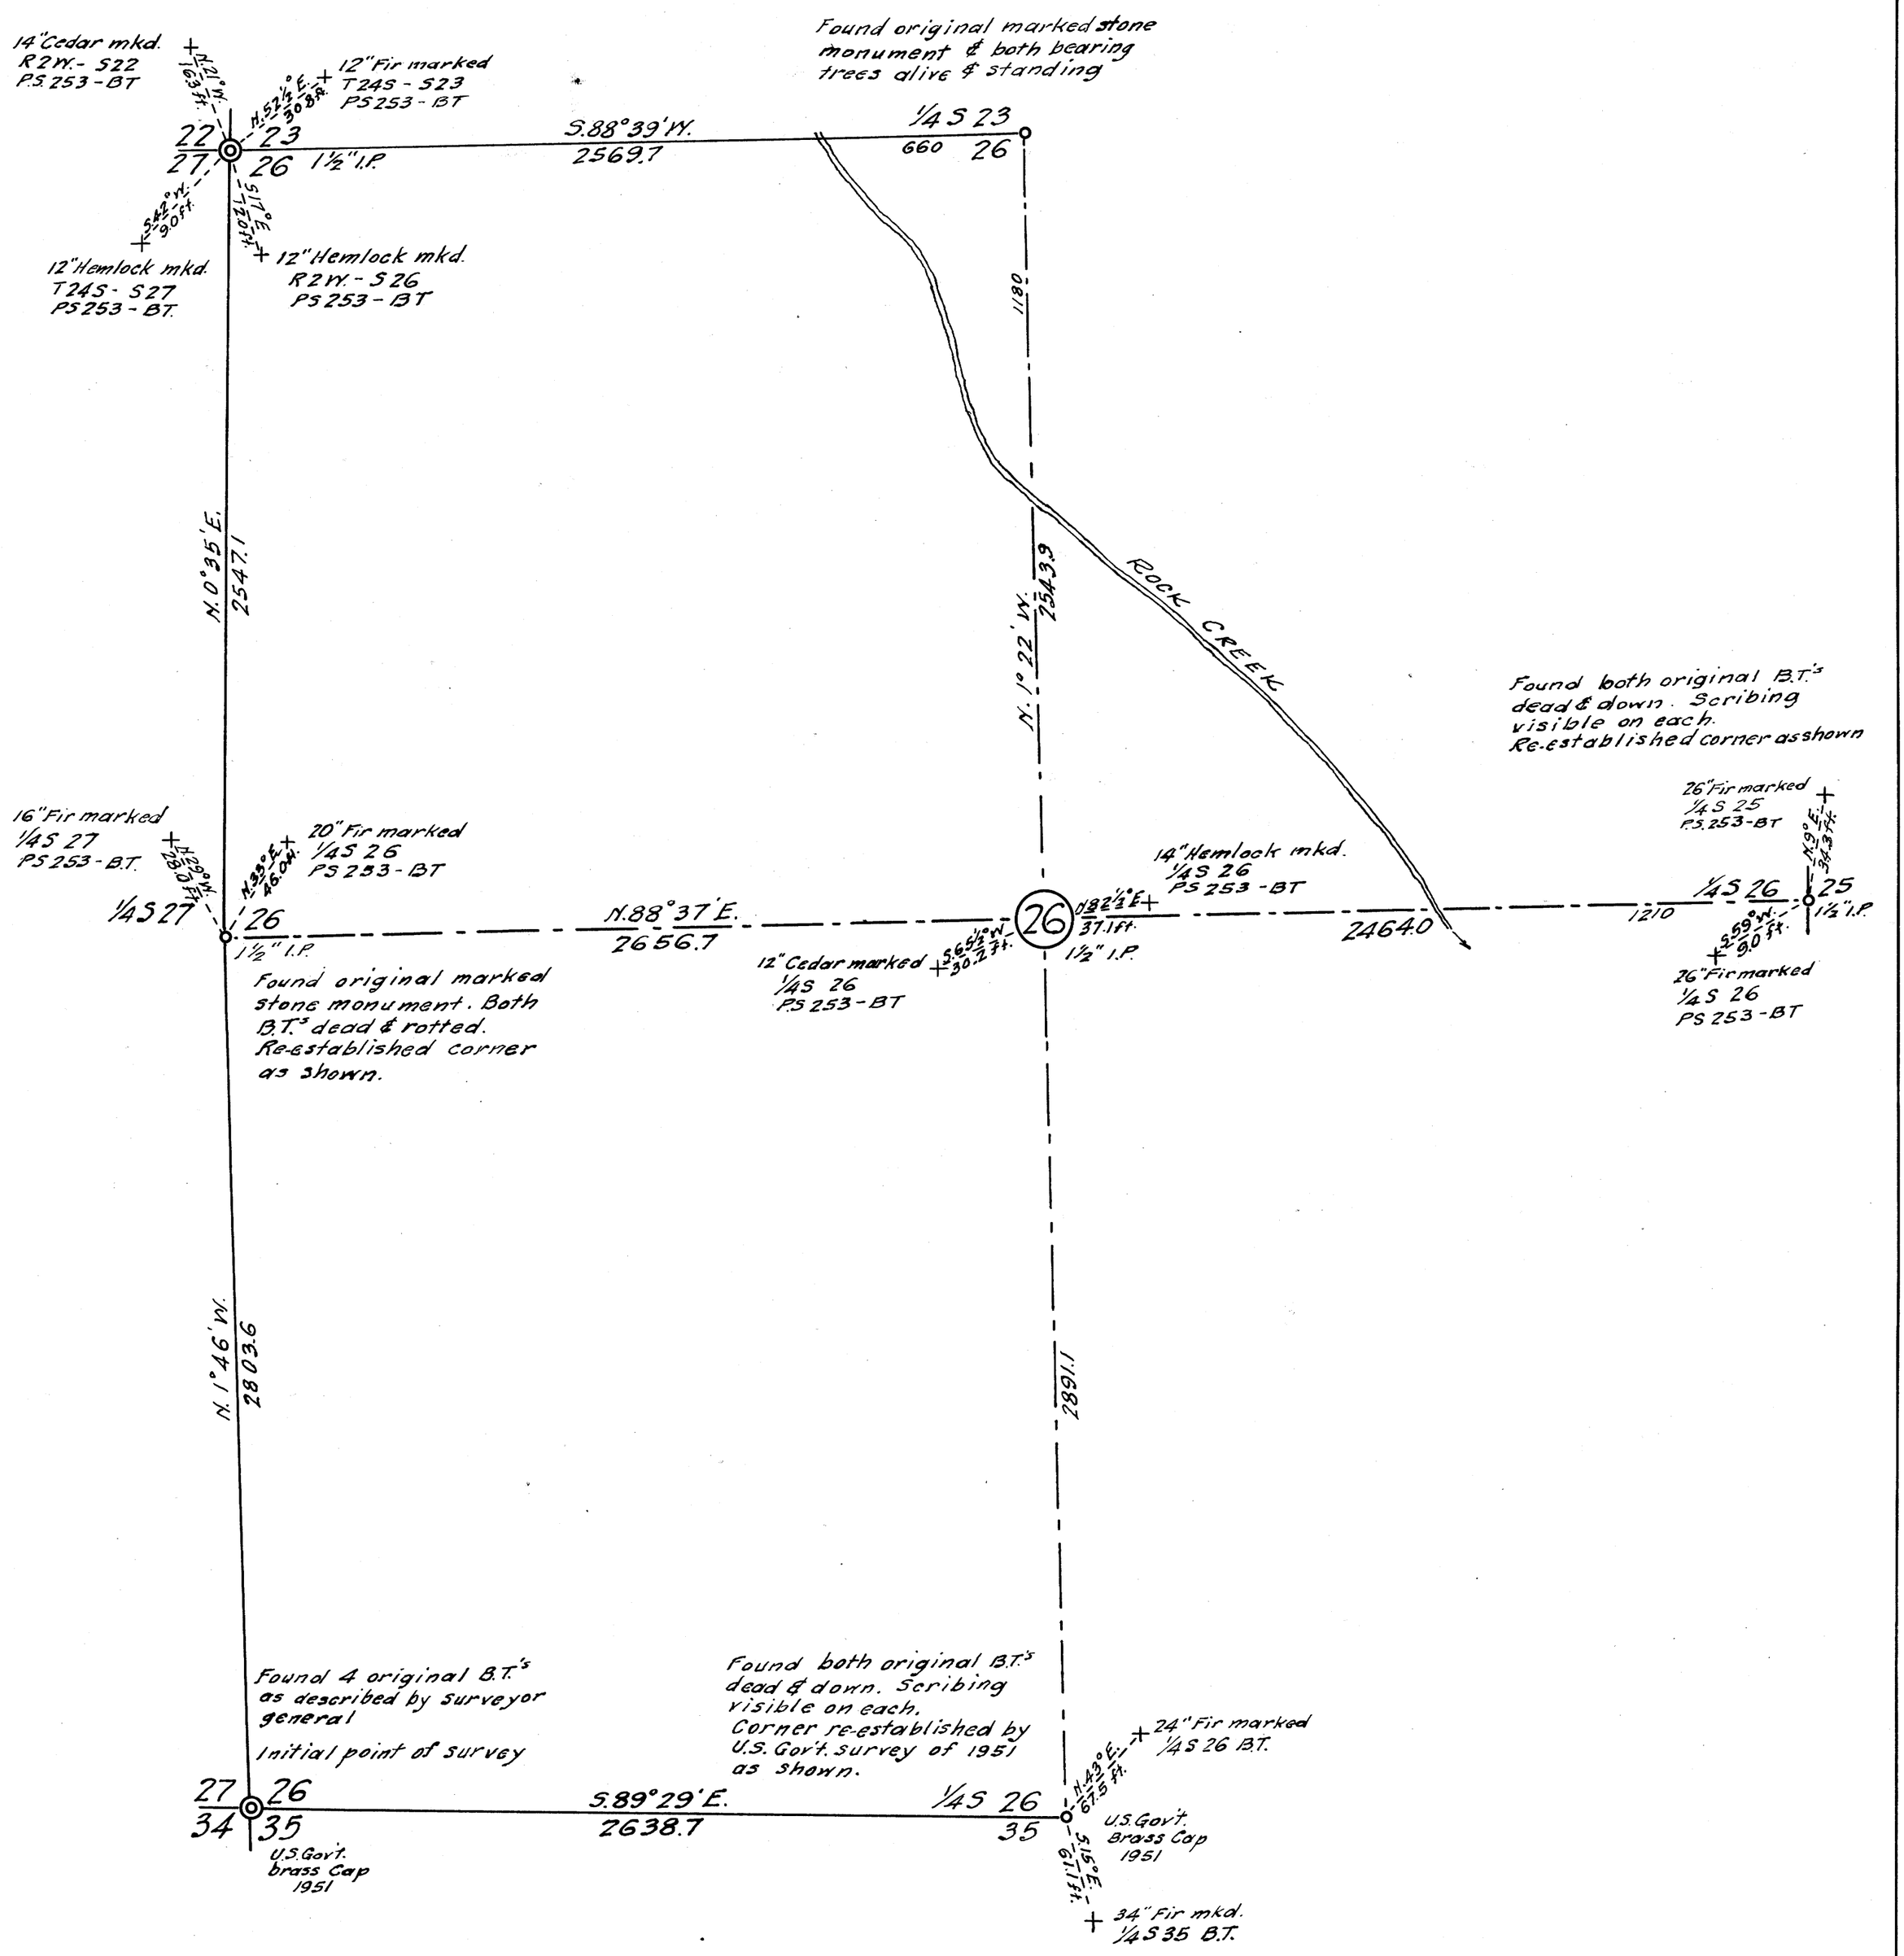

MAP

Showing sub-division of section 26, T.24S., R.2W., W.M. with re-establishment of obliterated corners and establishment of center ¼ corner.
This survey was made for the Douglas County Lumber Company by V.W. Hosford in April 1952 to determine the boundaries of the N.W. ¼ of this section.
All lines were run by transit and bearings determined by solar observation.
Magnetic variations are very unreliable in this area. The average is about 20°30"
Distances shown to bearing trees are not to scale.
All distances were measured with a 300 ft. steel tape and all vertical angles measured by the transit.

Scale : 1" = 400'

N.

V.W. Hosford

COUNTY SURVEYORS FILE COPY
DO NOT REMOVE FROM OFFICE

M12-55
FILE 41/27