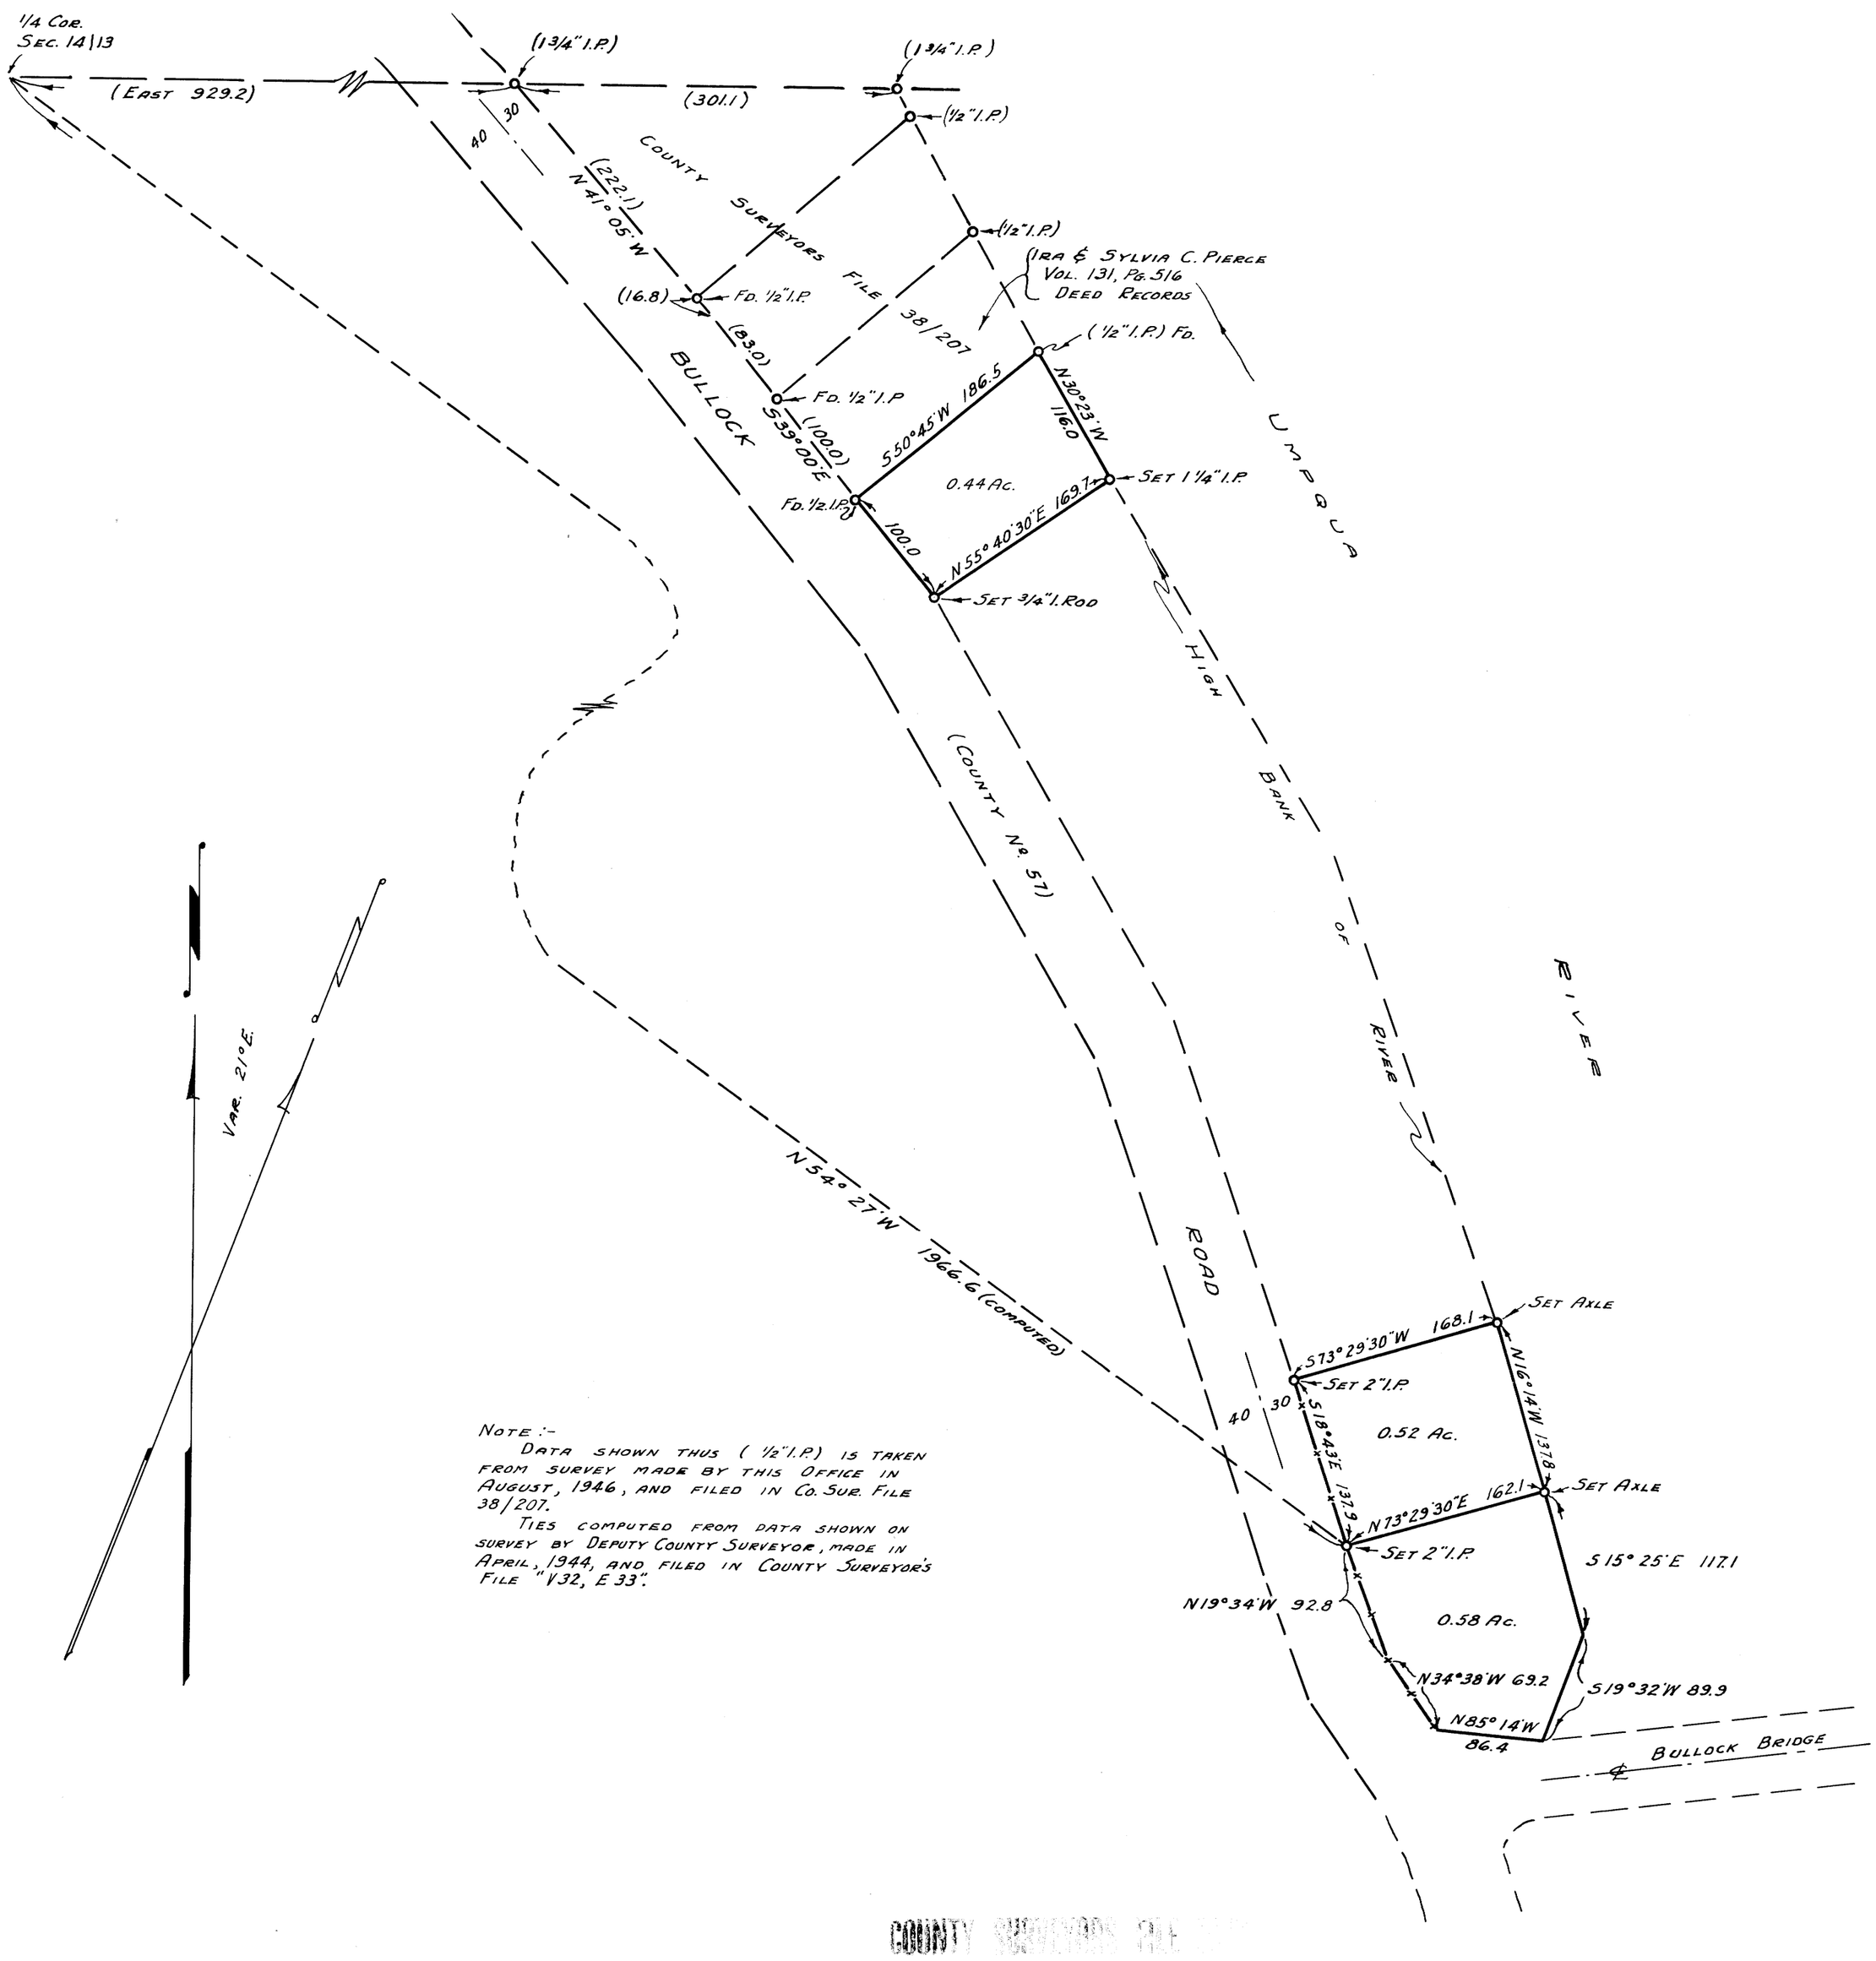

Note :-
Data shown thus (1/2" I.P.) is taken from survey made by this Office in August, 1946, and filed in Co. Sur. File 38/207.
Ties computed from data shown on survey by Deputy County Surveyor, made in April, 1944, and filed in County Surveyor's File "V32, E 33".

COUNTY SURVEYOR'S FILE
DO NOT REMOVE FROM

COUNTY SURVEYOR'S OFFICE.
DOUGLAS COUNTY, OREGON.

SURVEY FOR DEED DESCRIPTIONS IN LOT 7, SECTION 13, T24S, R7W.

BEN. B. IRVING
SURVEYED JAN. 17, 1952.

COUNTY SURVEYOR
SCALE 1" = 100'

C.S. FILE 38/207
M12-60