M12-7

COUNTY SURVEYORS FILE DATA
DO NOT REMOVE FROM OFFICE

C. A. PETHERICK & O. W. EGGLESTON

PART OF LOT 3, BLOCK 1,

PLAT "A" S. L. & W. Co.

NOVEMBER 1954 1" = 50'

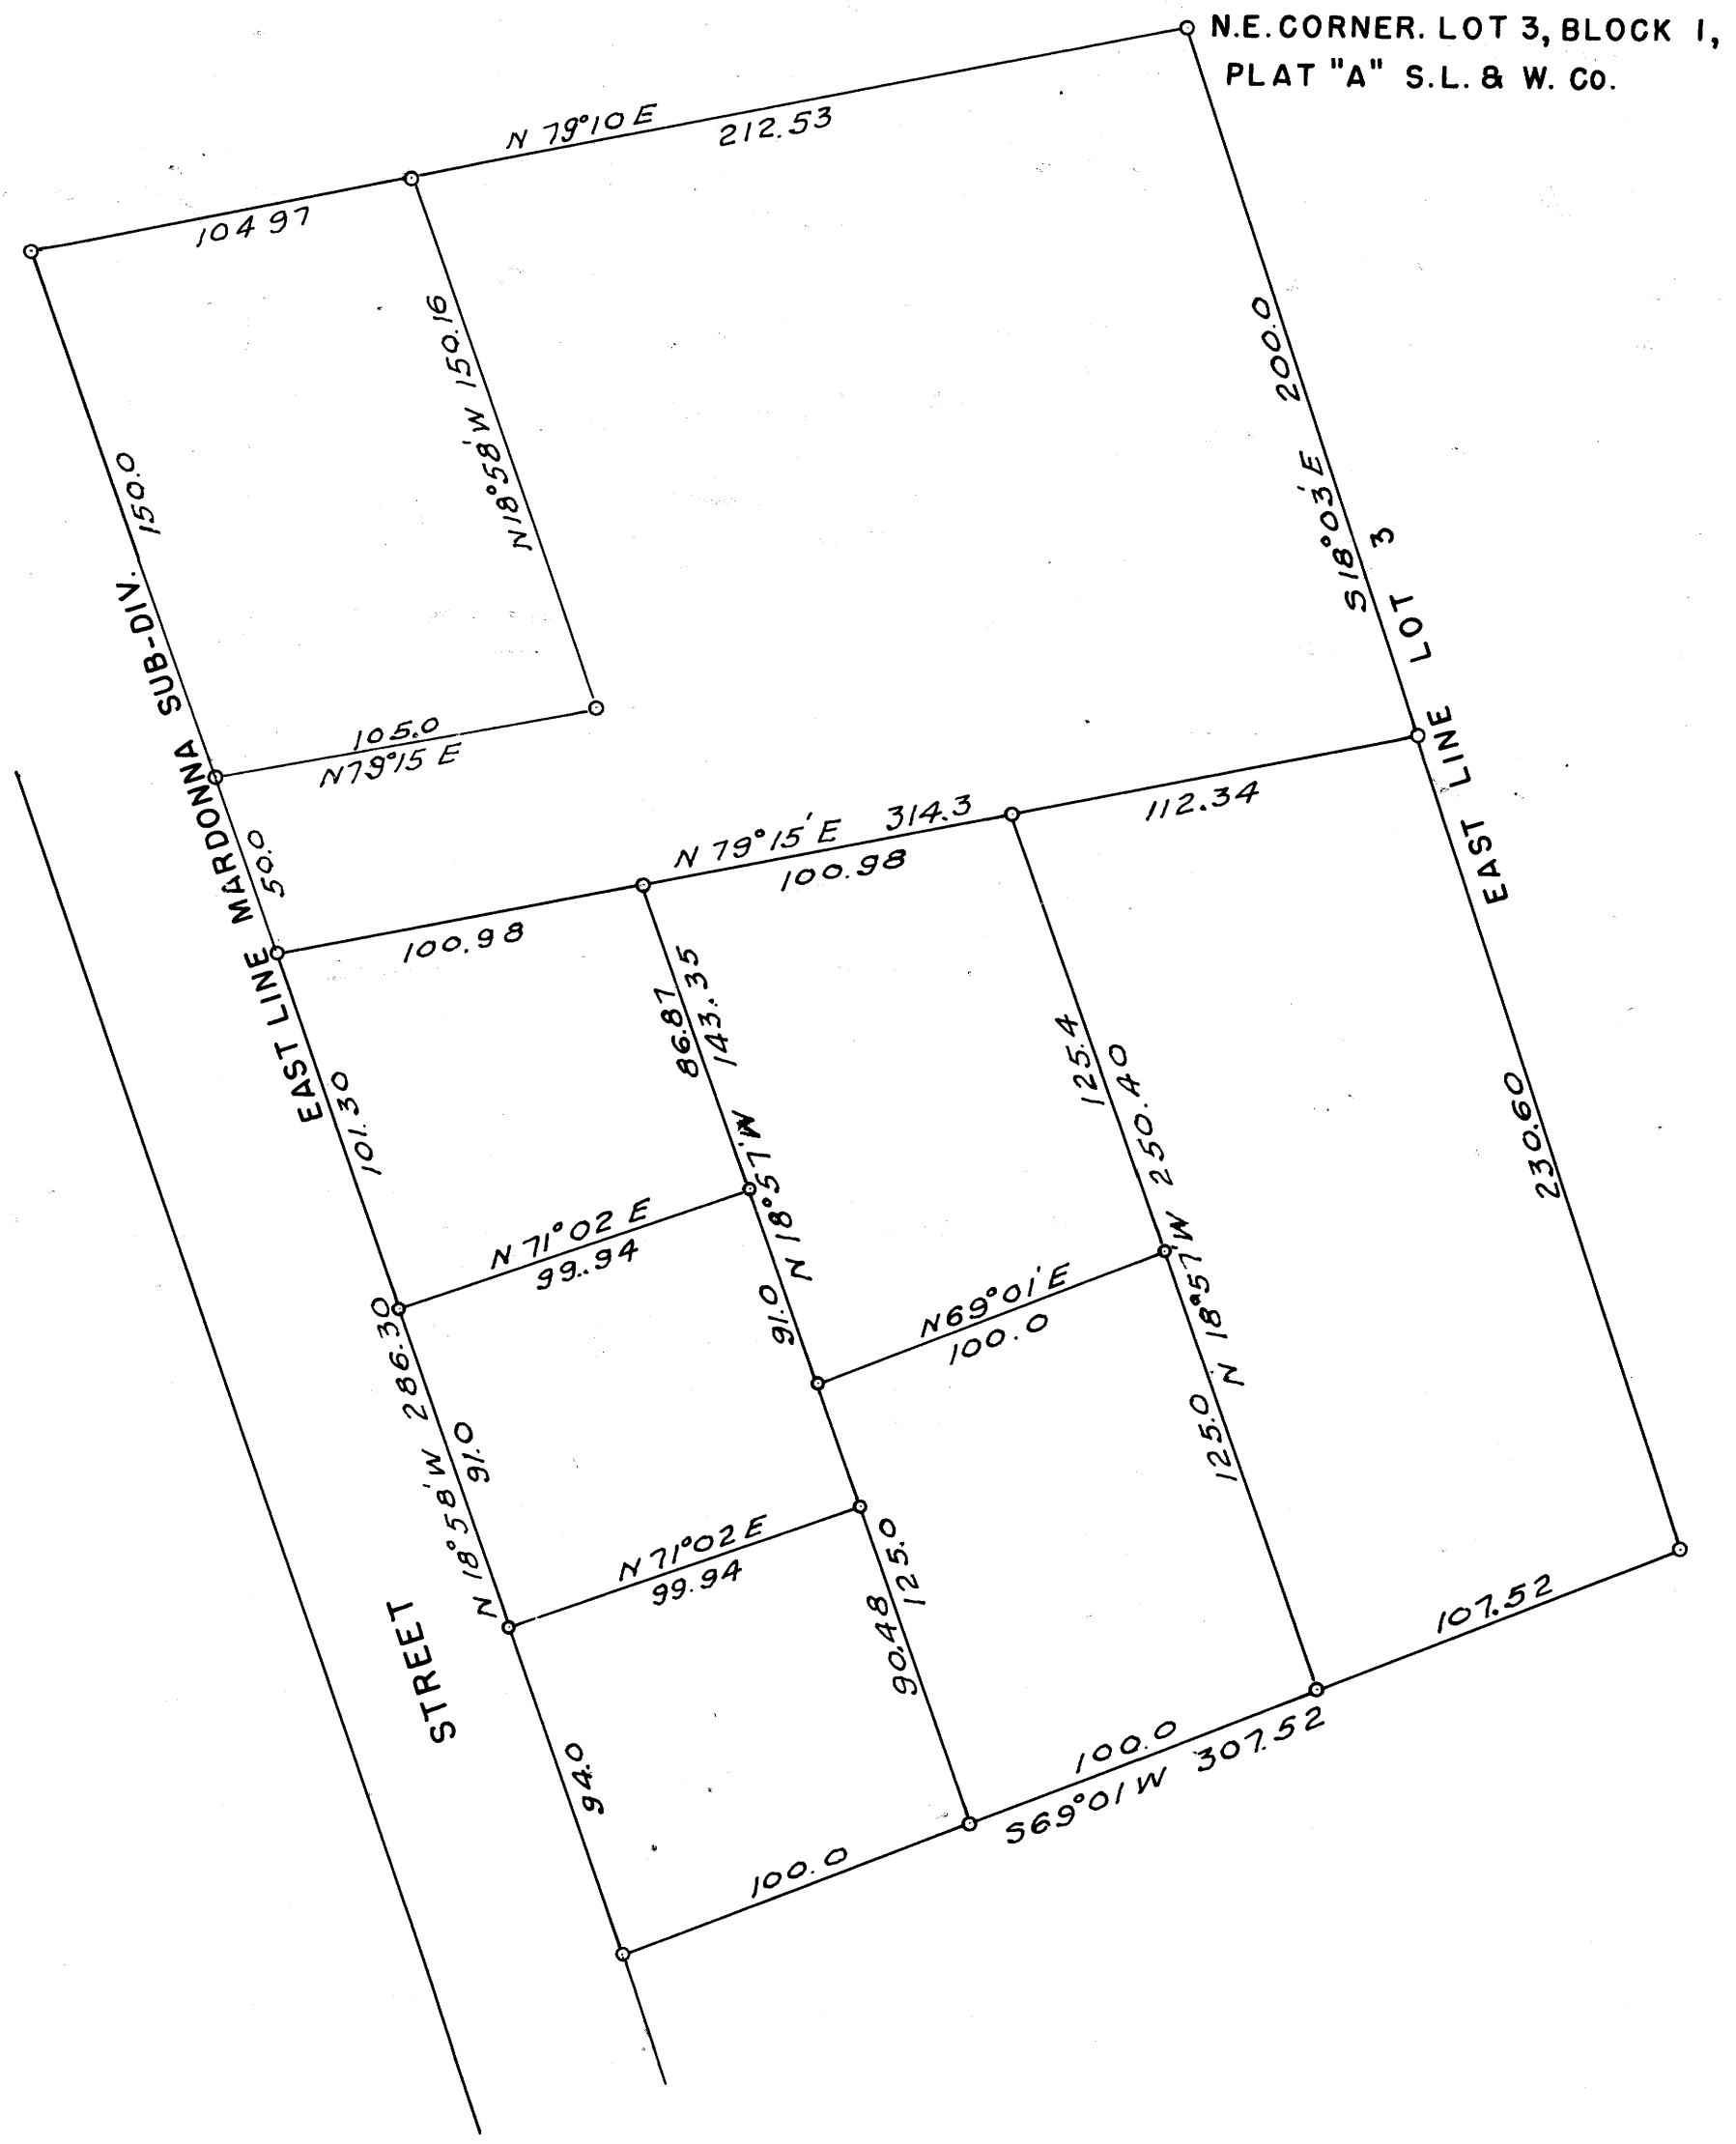

FILED
RECEIVED
APR 21 1958
COUNTY SURVEYOR
DOUGLAS COUNTY, ORE.

41 49

M12 7