M 12-14

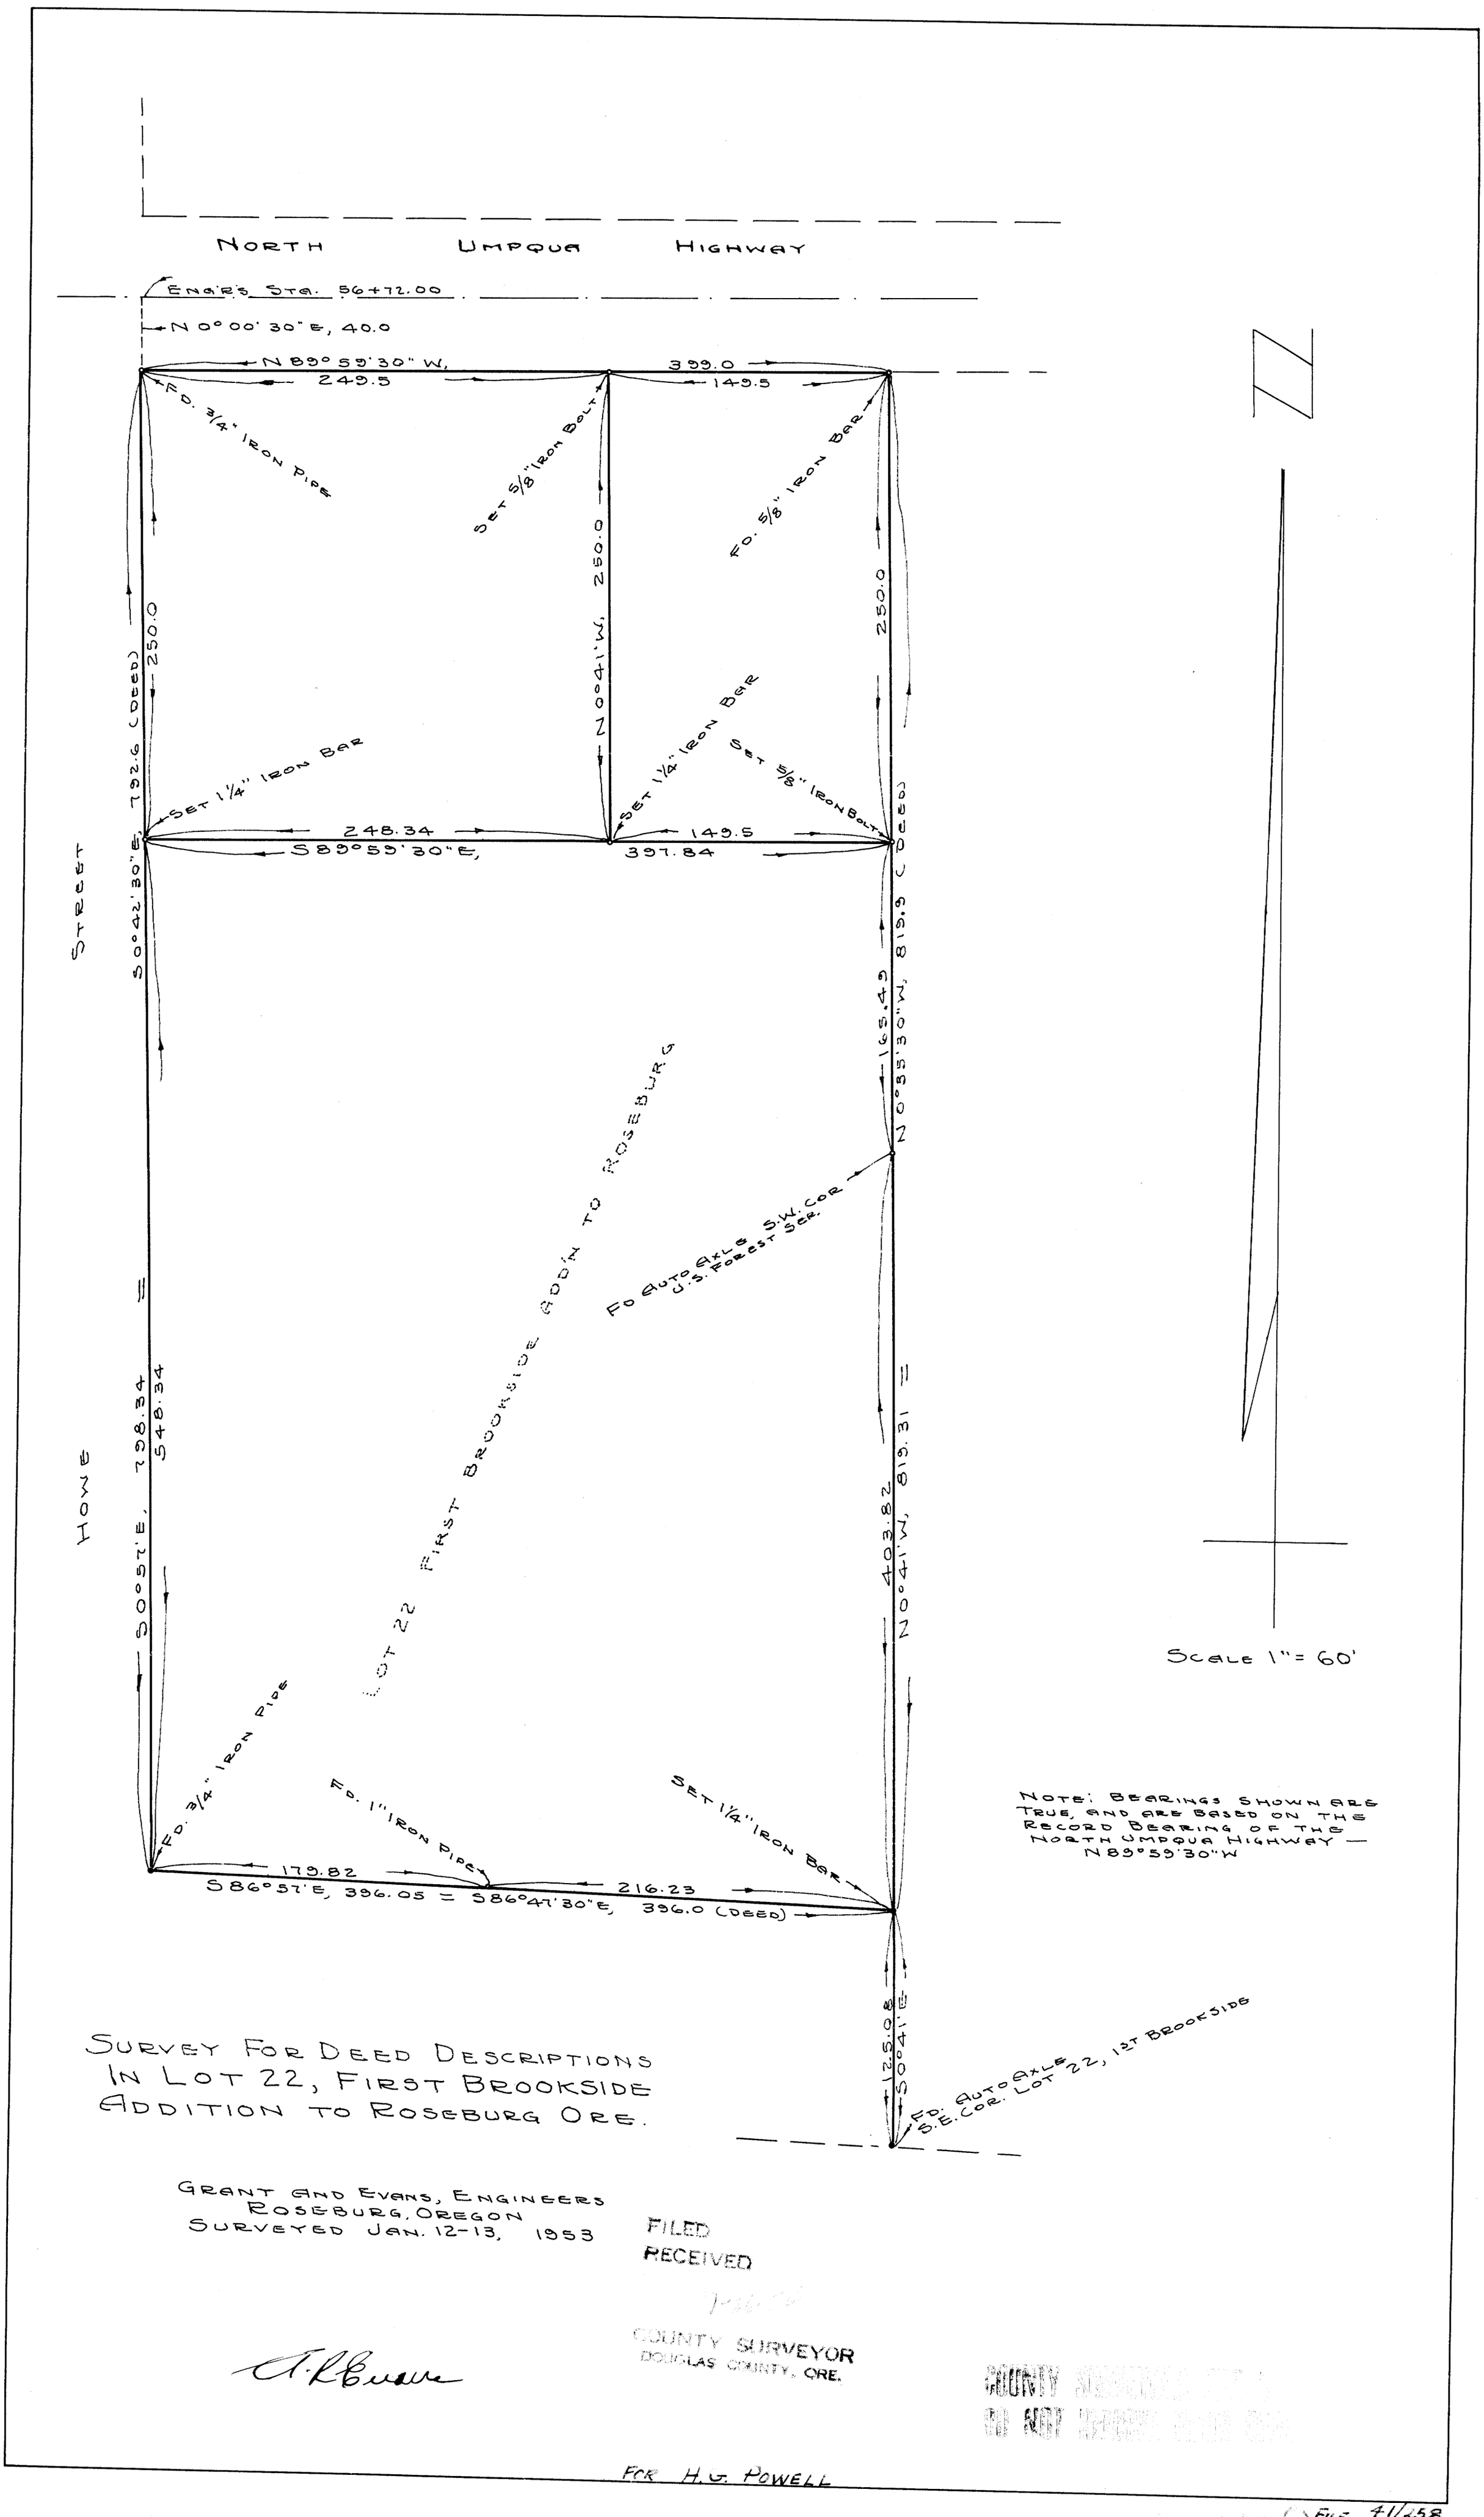


NOTE: BEARINGS SHOWN ARE TRUE, AND ARE BASED ON THE RECORD BEARING OF THE NORTH UMPQUA HIGHWAY — N 89°59' 30" W

SURVEY FOR DEED DESCRIPTIONS IN LOT 22, FIRST BROOKSIDE ADDITION TO ROSEBURG ORE.

GRANT AND EVANS, ENGINEERS
ROSEBURG, OREGON
SURVEYED JAN. 12-13, 1953

FILED
RECEIVED
COUNTY SURVEYOR
DOUGLAS COUNTY, ORE.

COUNTY SURVEYOR
DO NOT REMOVE THIS SEAL

FOR H. G. POWELL

H. G. Powell C.S. FILE 41/258
MAP FILE M 12-14