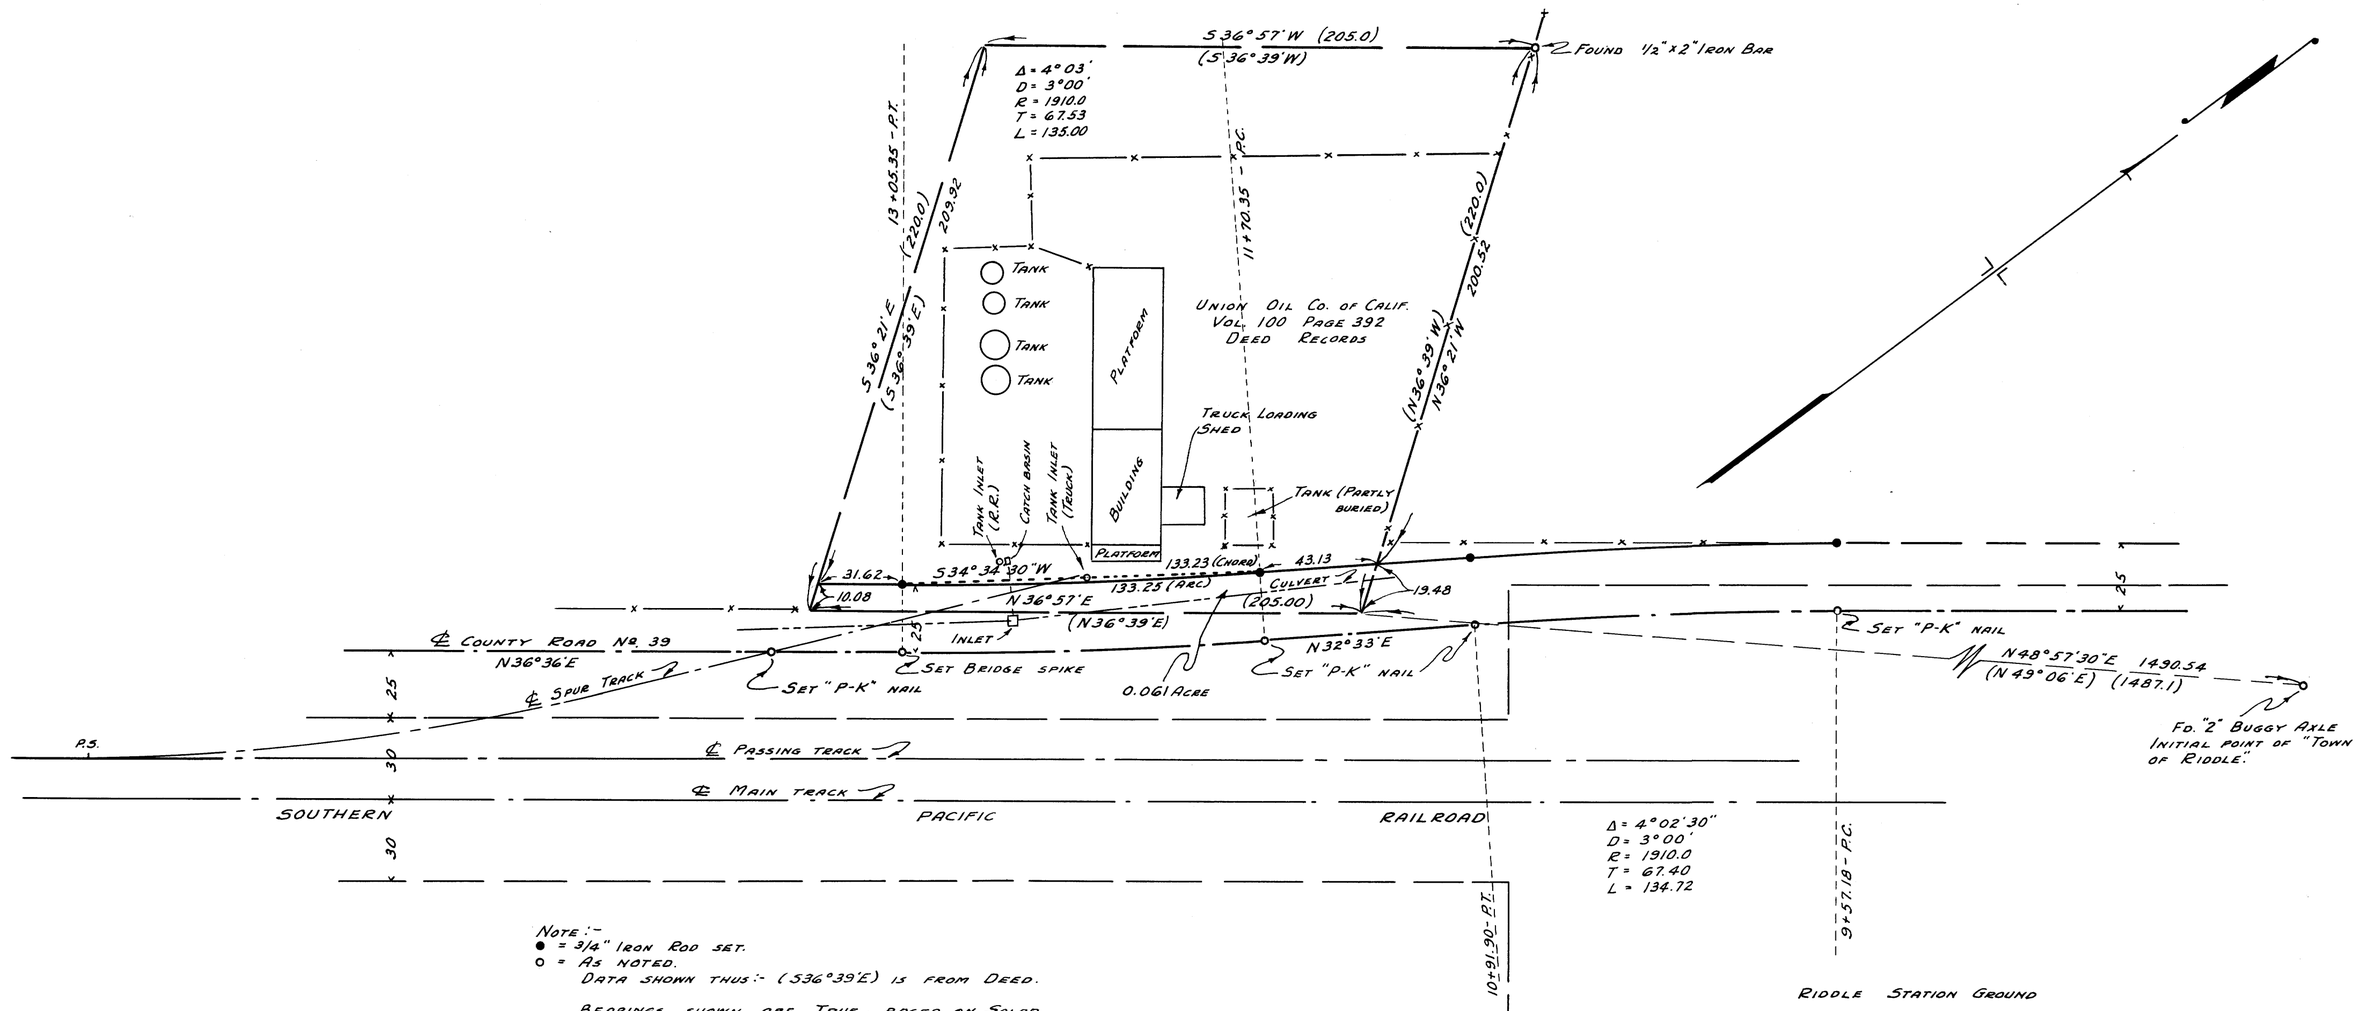

NOTE:-
● = 3/4" IRON ROD SET.
○ = AS NOTED.
DATA SHOWN THUS:- (S36°39'E) IS FROM DEED.

BEARINGS SHOWN ARE TRUE, BASED ON SOLAR OBSERVATION MADE OCT. 14, 1953, AT ROAD STA. 169+53.

COUNTY SURVEYORS FILE DATA
DO NOT REMOVE FROM OFFICE

COUNTY SURVEYOR'S OFFICE
DOUGLAS COUNTY, OREGON

DESCRIPTION OF PARCEL FOR R/W, FOR RIDDLE - GLENBROOK LOOP (COUNTY Nº 39) ROAD.

BEN B. IRVING
DECEMBER 14, 1953

COUNTY SURVEYOR
SCALE 1" = 40'

RD. FILE No. 48/39
MAP FILE M 12-3

48/