SE-SE W

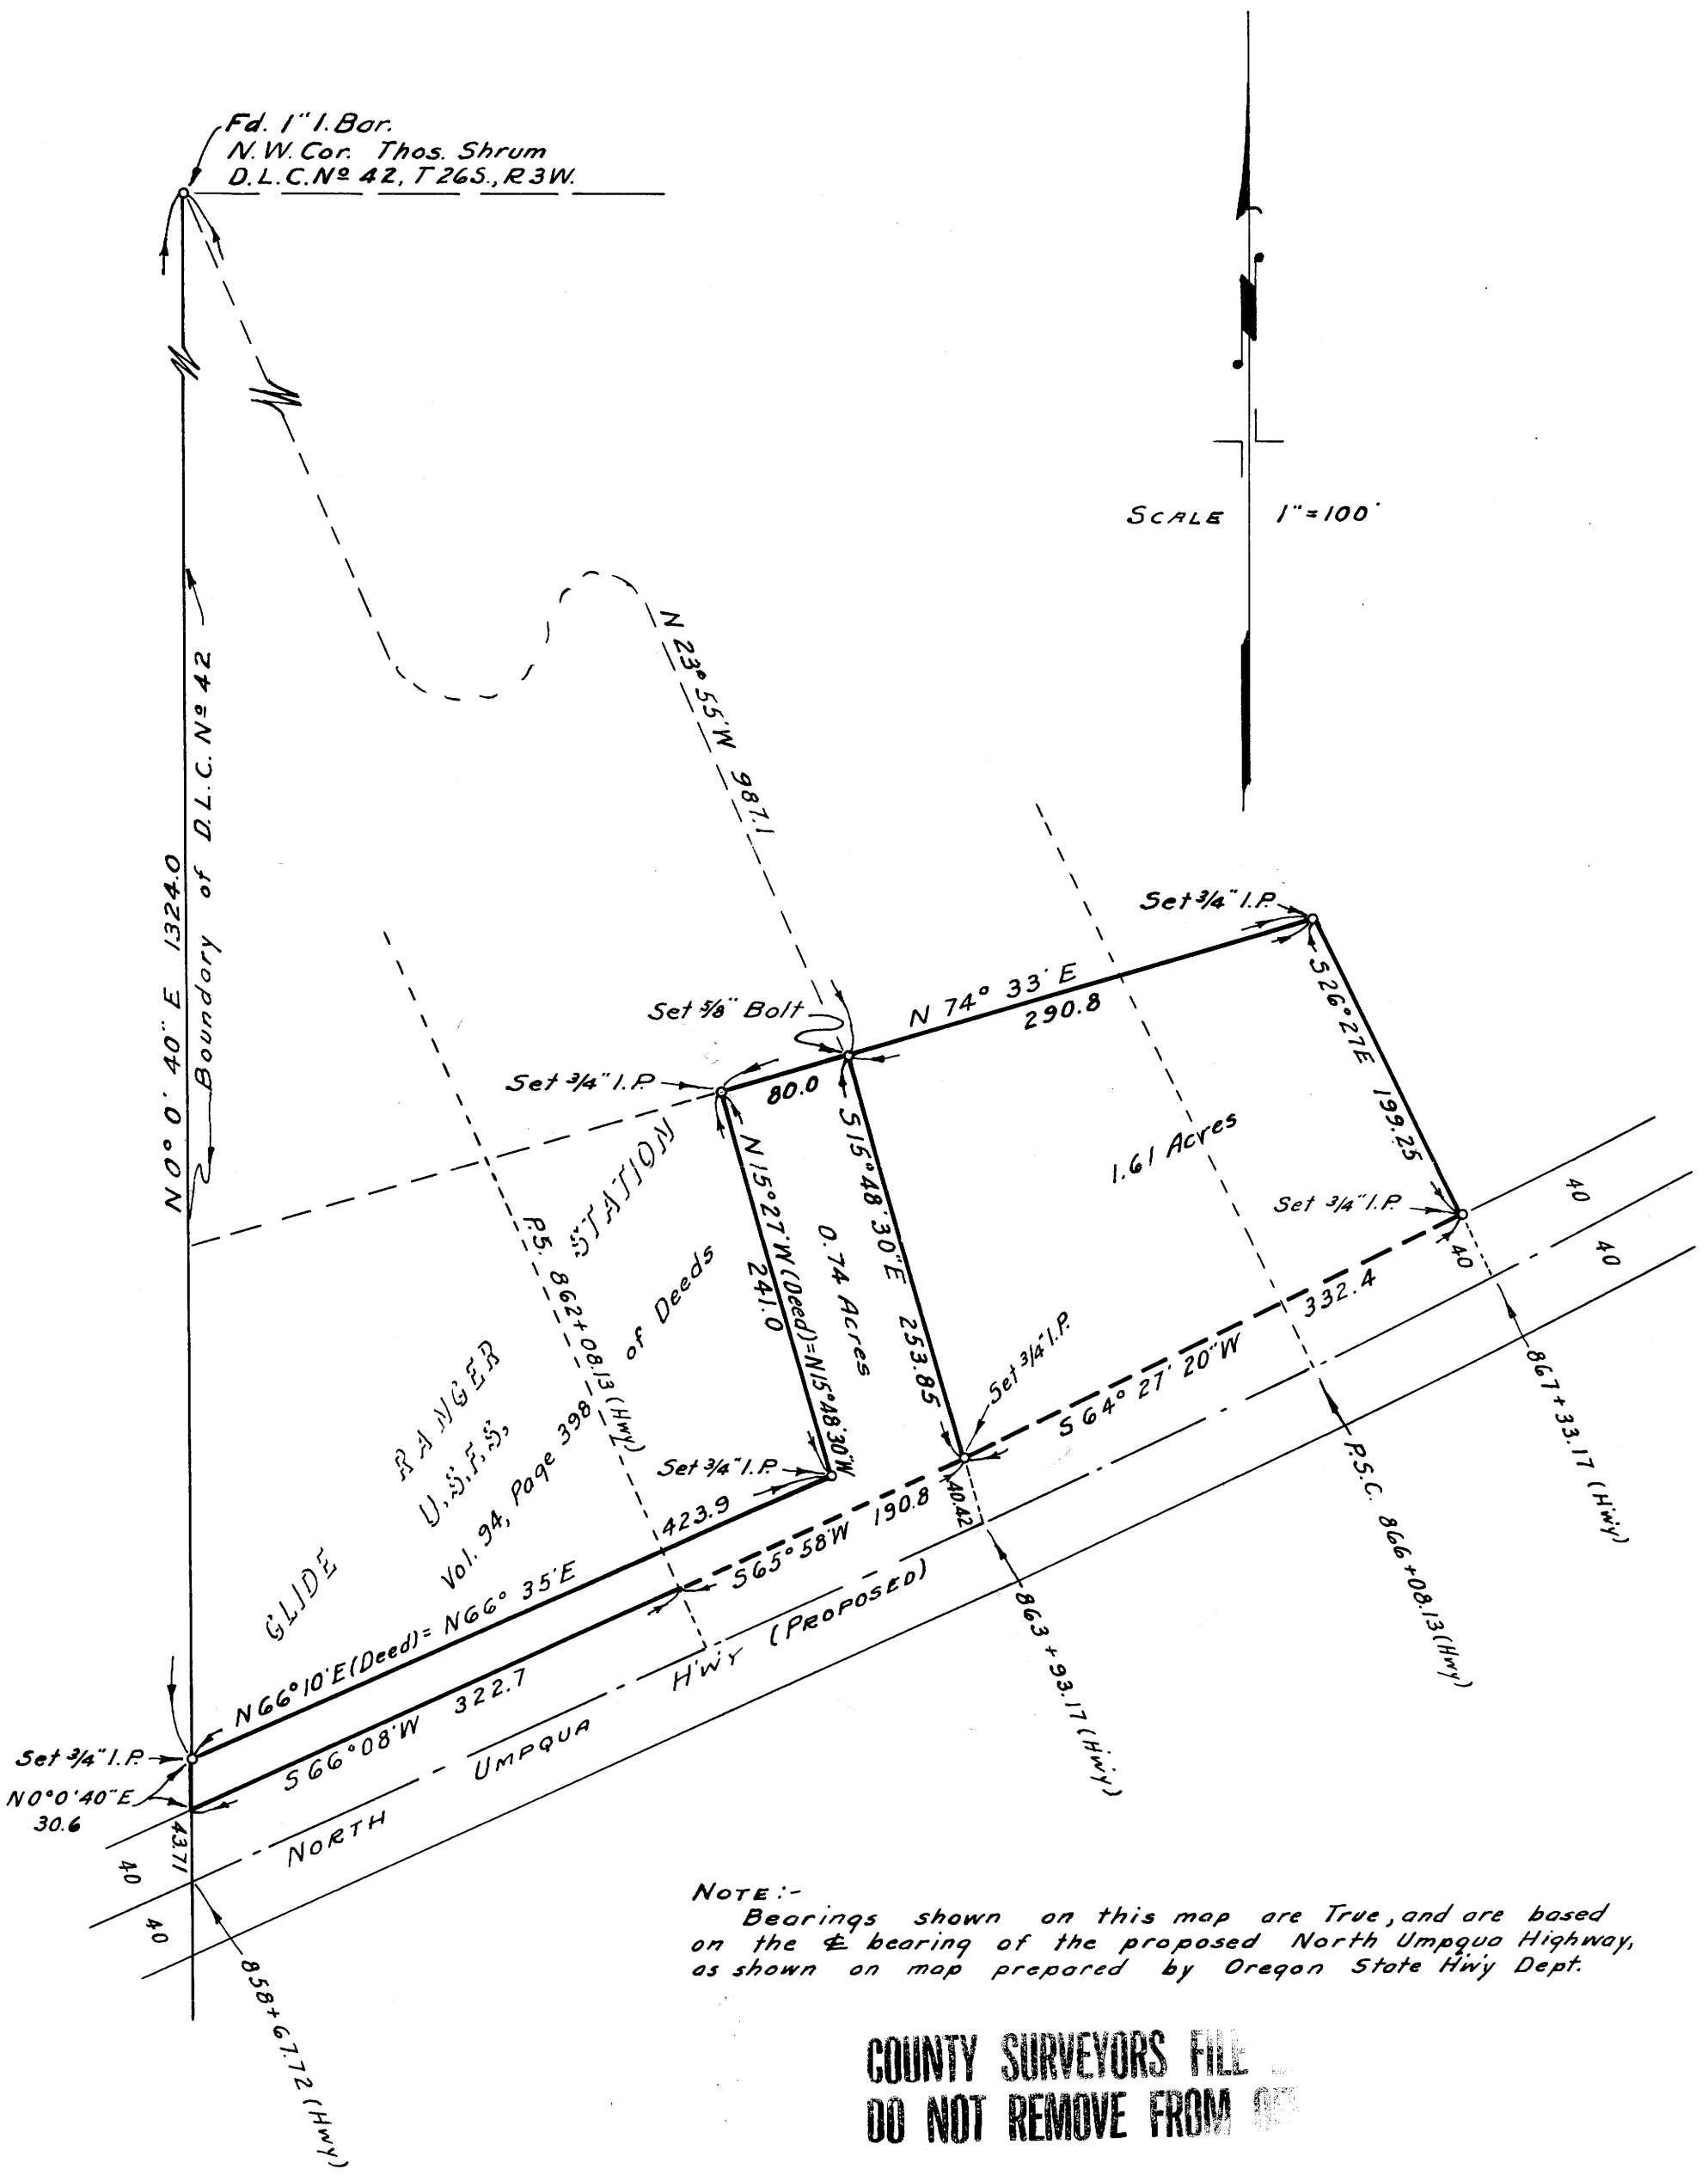

NOTE:-
Bearings shown on this map are True, and are based on the ℄ bearing of the proposed North Umpqua Highway, as shown on map prepared by Oregon State Hwy Dept.

COUNTY SURVEYORS FILE
DO NOT REMOVE FROM OFF

COUNTY SURVEYOR'S OFFICE
DOUGLAS COUNTY. OREGON

SURVEY FOR DEED DESCRIPTION.
PORTION OF D.L.C. 42 T 26 S. R 3 W.. W.M.

BEN. B. IRVING COUNTY SURVEYOR
SURVEYED AUG. 25-27. 1948 BY
N.E. RICHARDSON DEPUTY

N E Richardson

M 13-35
FILE 187 DRAWER 39