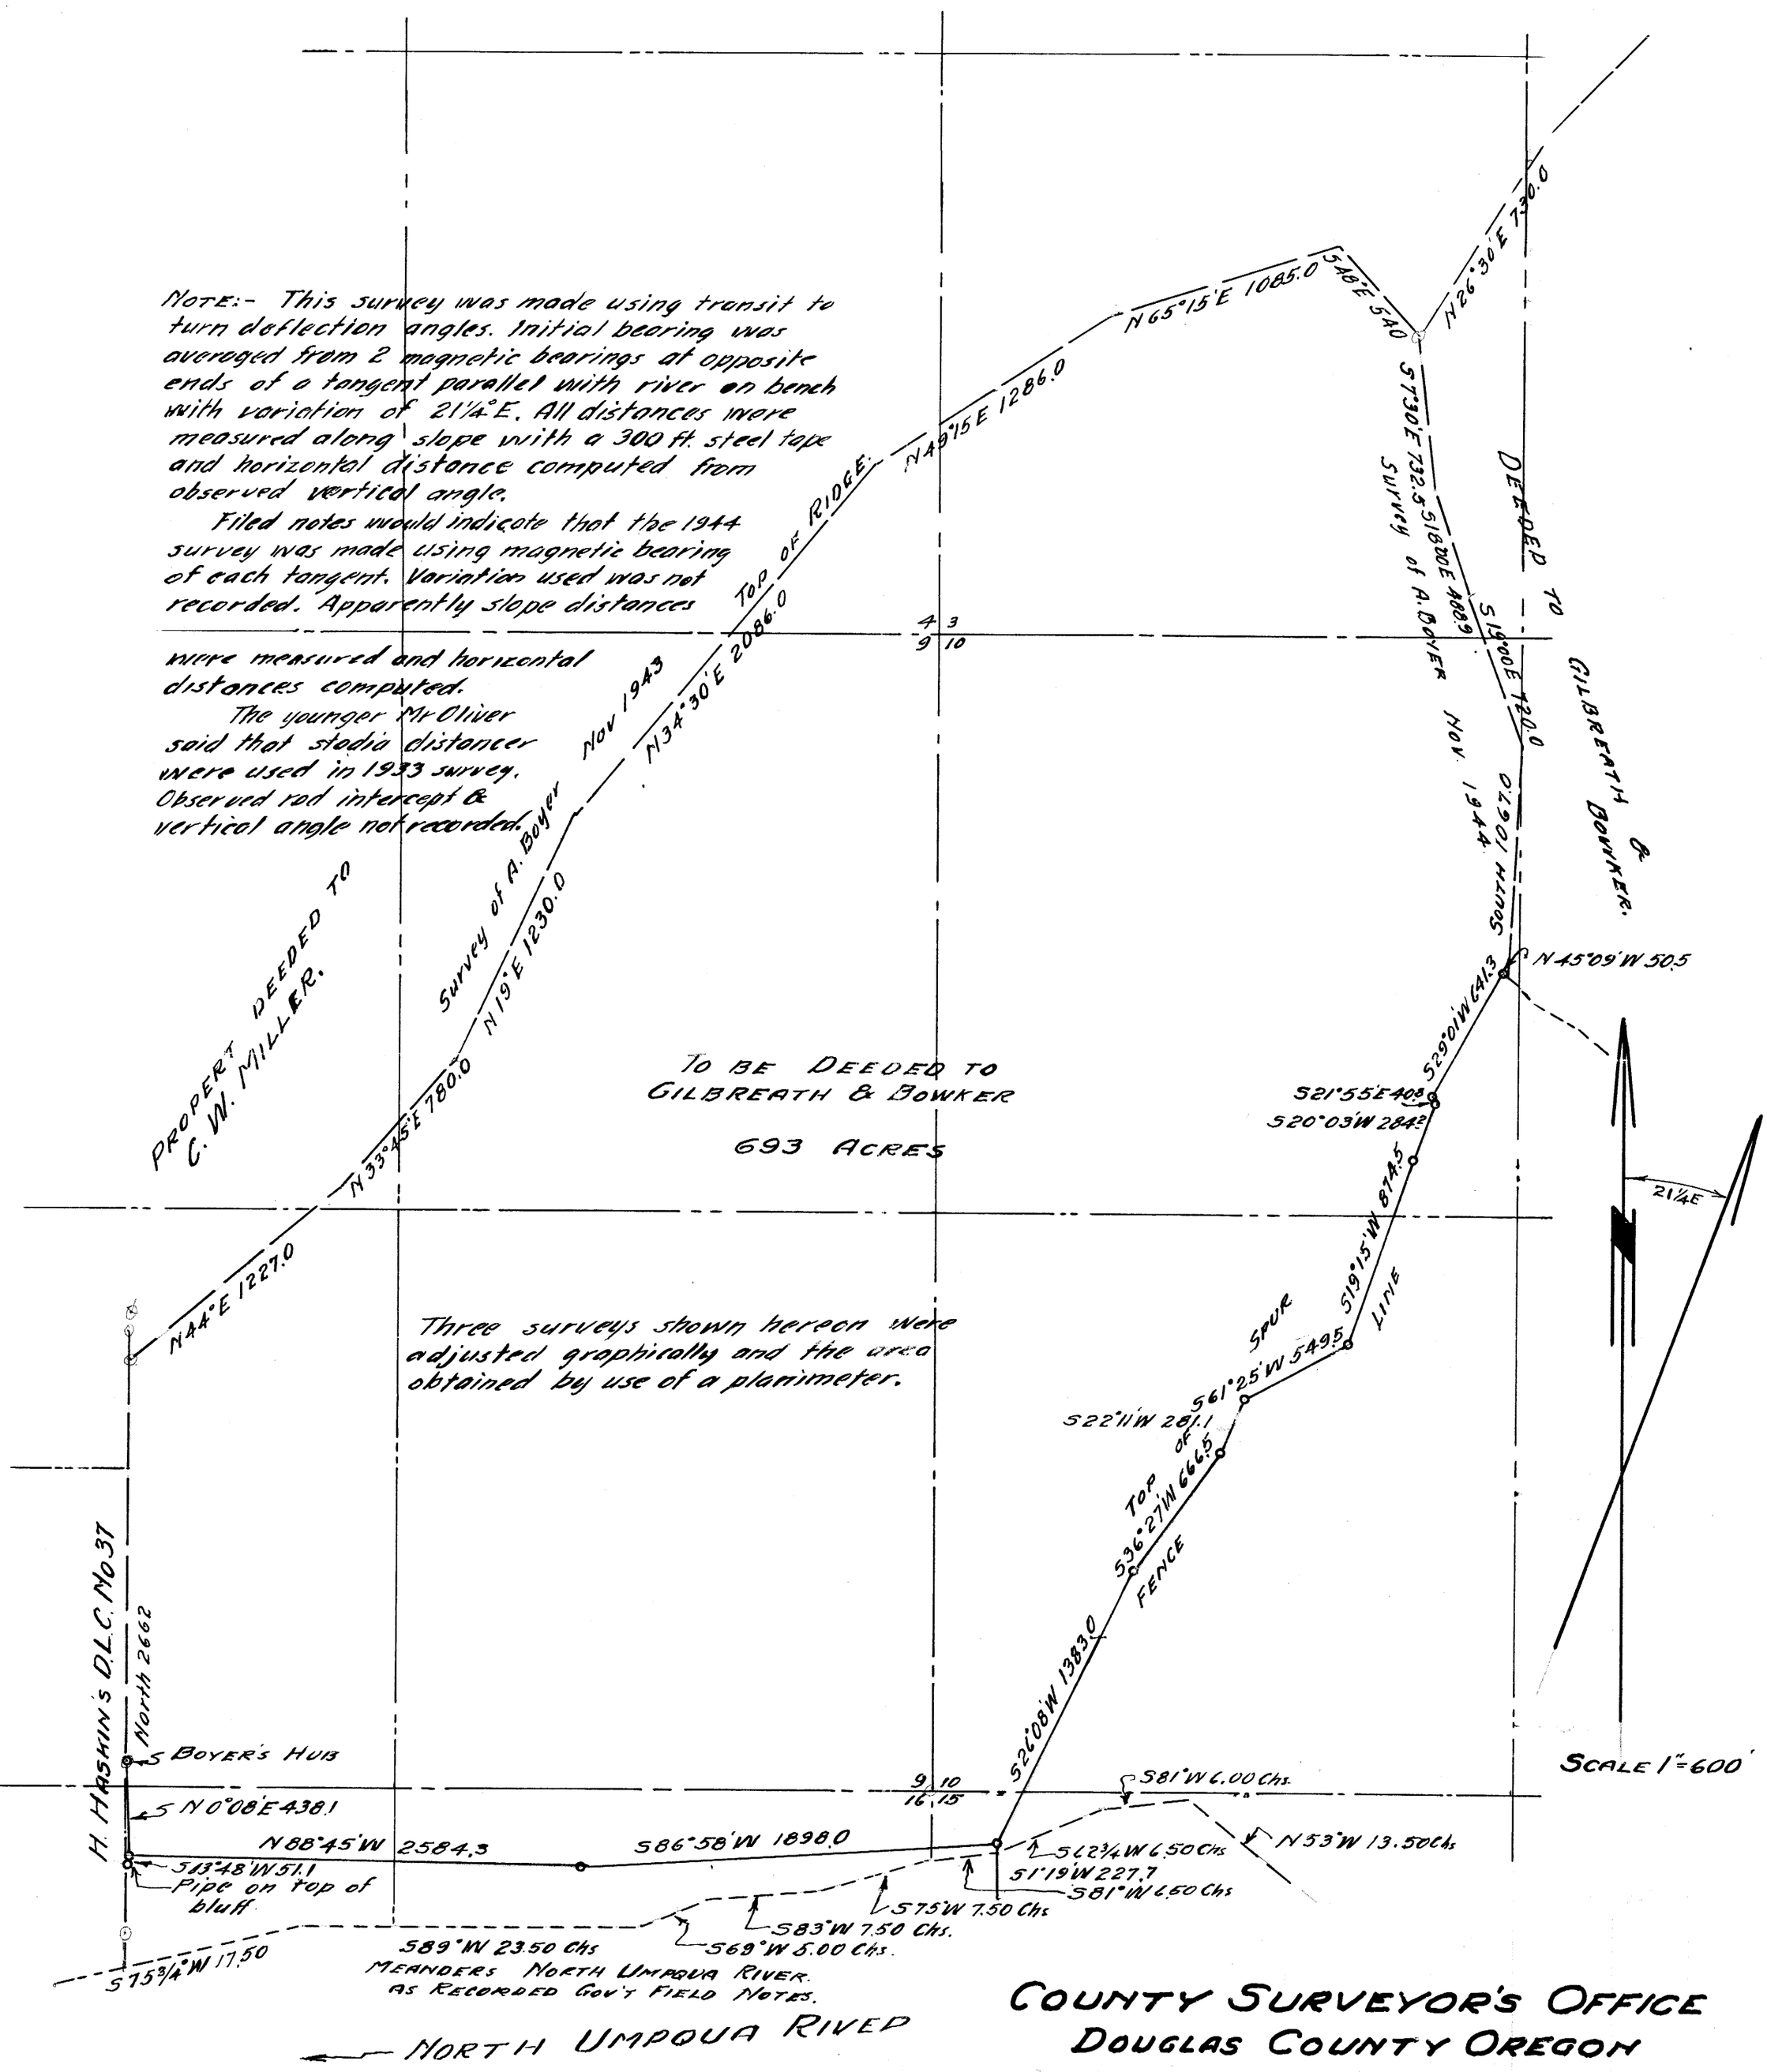

COUNTY SURVEYOR'S OFFICE
DOUGLAS COUNTY OREGON

OLIVER TO GILBREATH & BOWKER
SECTIONS 3-4-9-10-15-16 T26S R4W.

BEN. B. IRVING COUNTY SURVEYOR
Surveyed JAN 24-28 1946

COUNTY SURVEYOR'S OFFICE
DO NOT REMOVE FROM OFFICE