M13-44

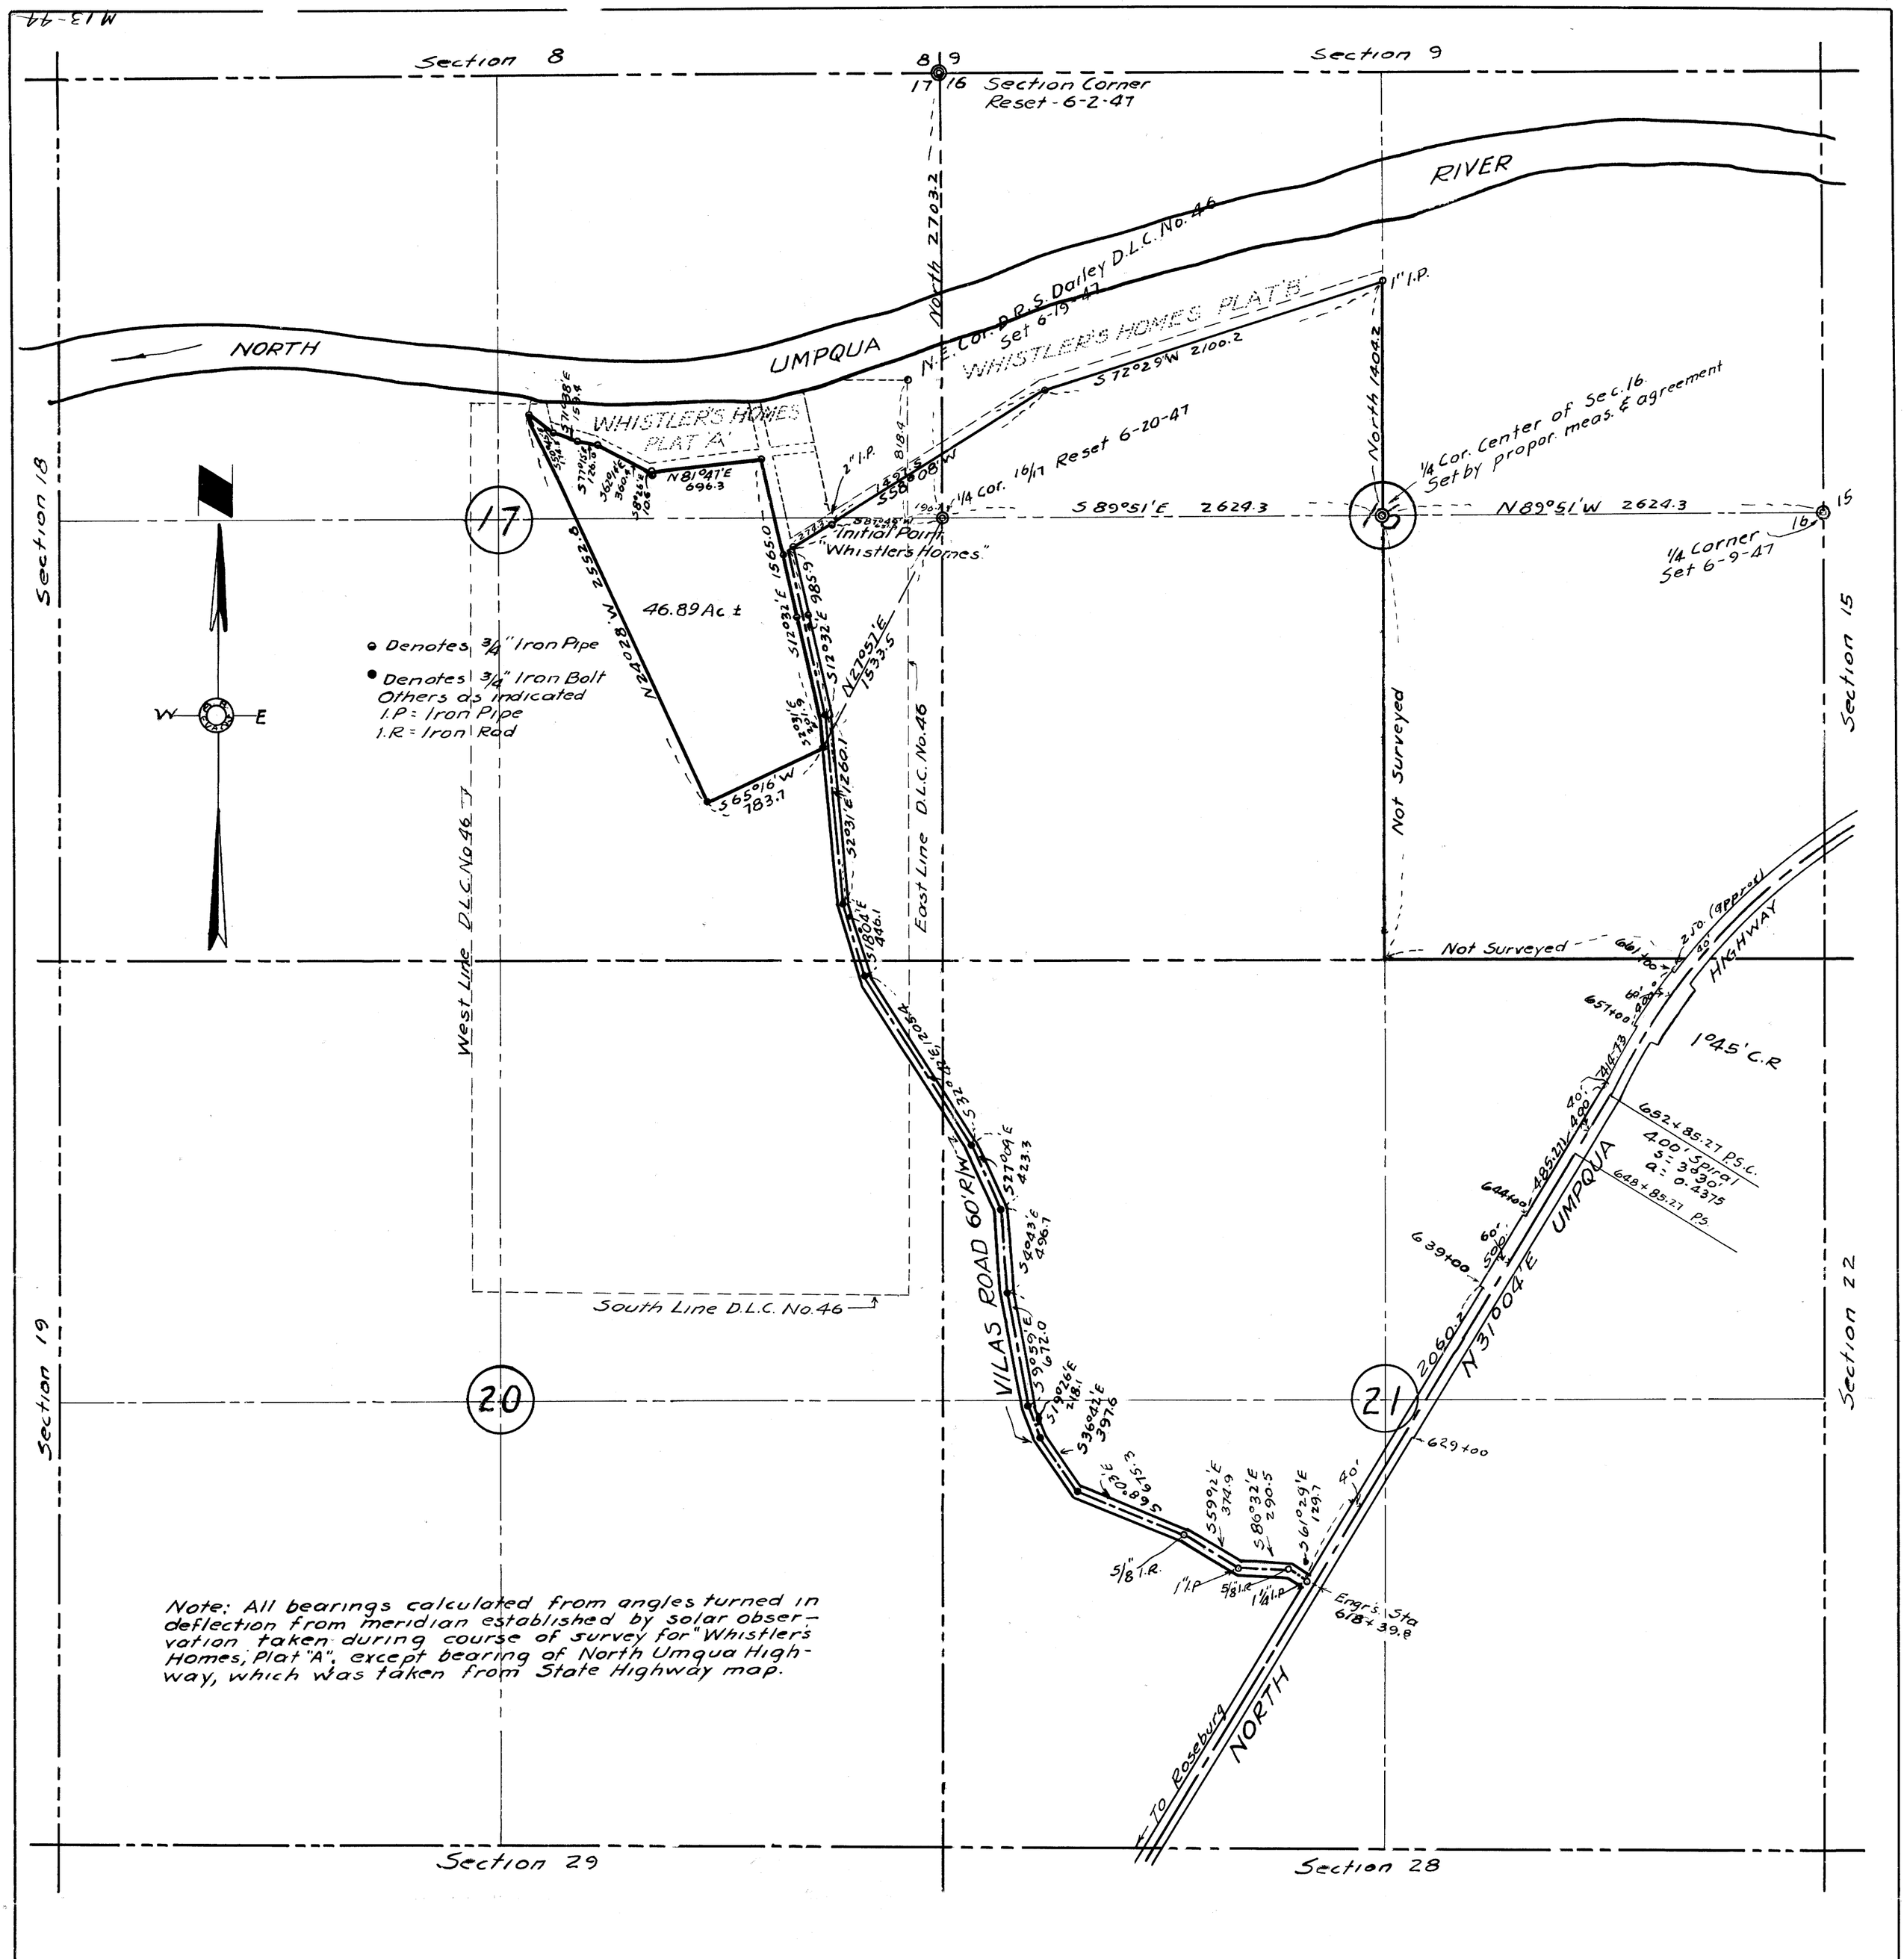

Note: All bearings calculated from angles turned in deflection from meridian established by solar observation taken during course of survey for "Whistler's Homes, Plat "A", except bearing of North Umqua Highway, which was taken from State Highway map.

COUNTY SURVEYOR'S OFFICE
DOUGLAS COUNTY OREGON
SURVEY FOR DEED DESCRIPTION AND ROAD DEDICATION
SECTIONS 16-17-20-21, T26S, R4W.WM.

BEN B. IRVING COUNTY SURVEYOR

SURVEYED NOVEMBER 19-21, 1947 BY

N.E. RICHARDSON DEPUTY

SCALE 8 IN. = 1 MILE

N E Richardson

COUNTY SURVEYORS FILE DATA
DO NOT REMOVE FROM OFFICE

M13-44 P

FILE 128 DRAWER 39