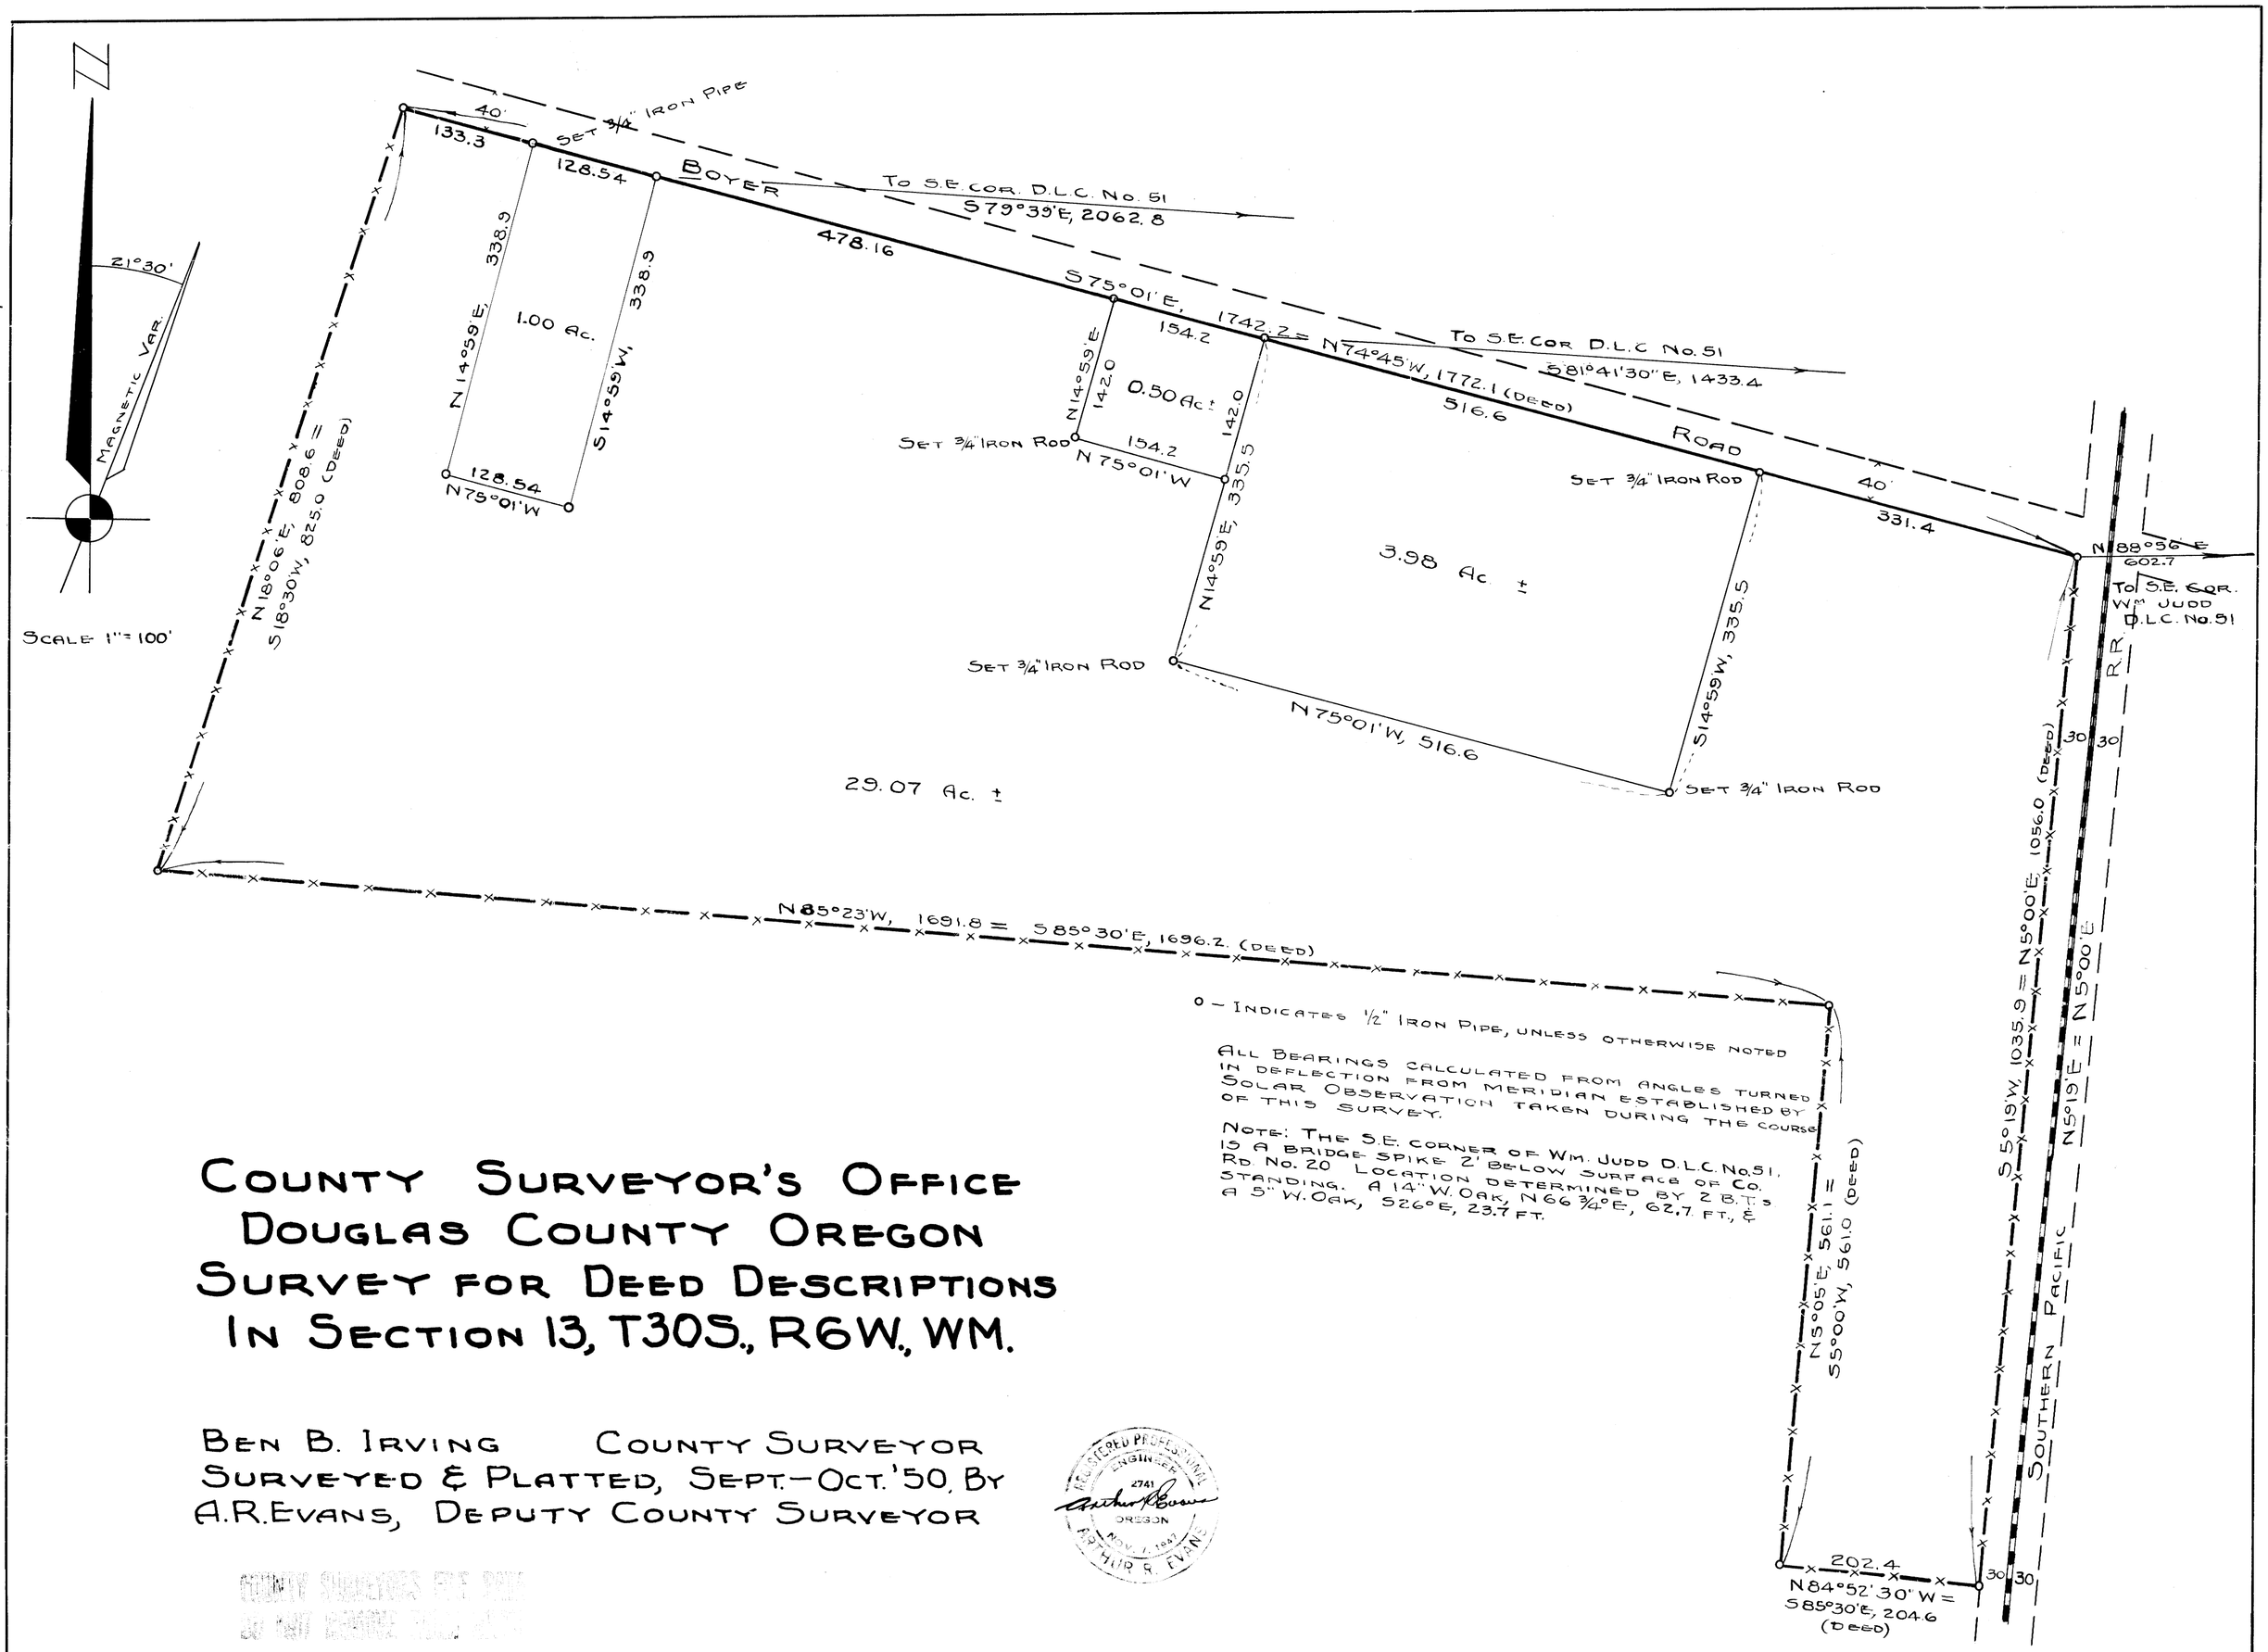

o – INDICATES 1/2" IRON PIPE, UNLESS OTHERWISE NOTED

ALL BEARINGS CALCULATED FROM ANGLES TURNED IN DEFLECTION FROM MERIDIAN ESTABLISHED BY SOLAR OBSERVATION TAKEN DURING THE COURSE OF THIS SURVEY.

NOTE: THE S.E. CORNER OF WM. JUDD D.L.C. No. 51, IS A BRIDGE SPIKE 2' BELOW SURFACE OF CO. RD. No. 20 LOCATION DETERMINED BY 2 B.T.'s STANDING. A 14" W. OAK, N66 3/4°E, 62.7 FT., & A 5" W. OAK, S26°E, 23.7 FT.

COUNTY SURVEYOR'S OFFICE
DOUGLAS COUNTY OREGON
SURVEY FOR DEED DESCRIPTIONS
IN SECTION 13, T30S., R6W., WM.

BEN B. IRVING COUNTY SURVEYOR
SURVEYED & PLATTED, SEPT.–OCT. '50, BY
A.R. EVANS, DEPUTY COUNTY SURVEYOR

REGISTERED PROFESSIONAL ENGINEER 2741 OREGON NOV. 1, 1962 ARTHUR R. EVANS

COUNTY SURVEYOR'S FILE COPY
DO NOT REMOVE FROM FILE