M13-60

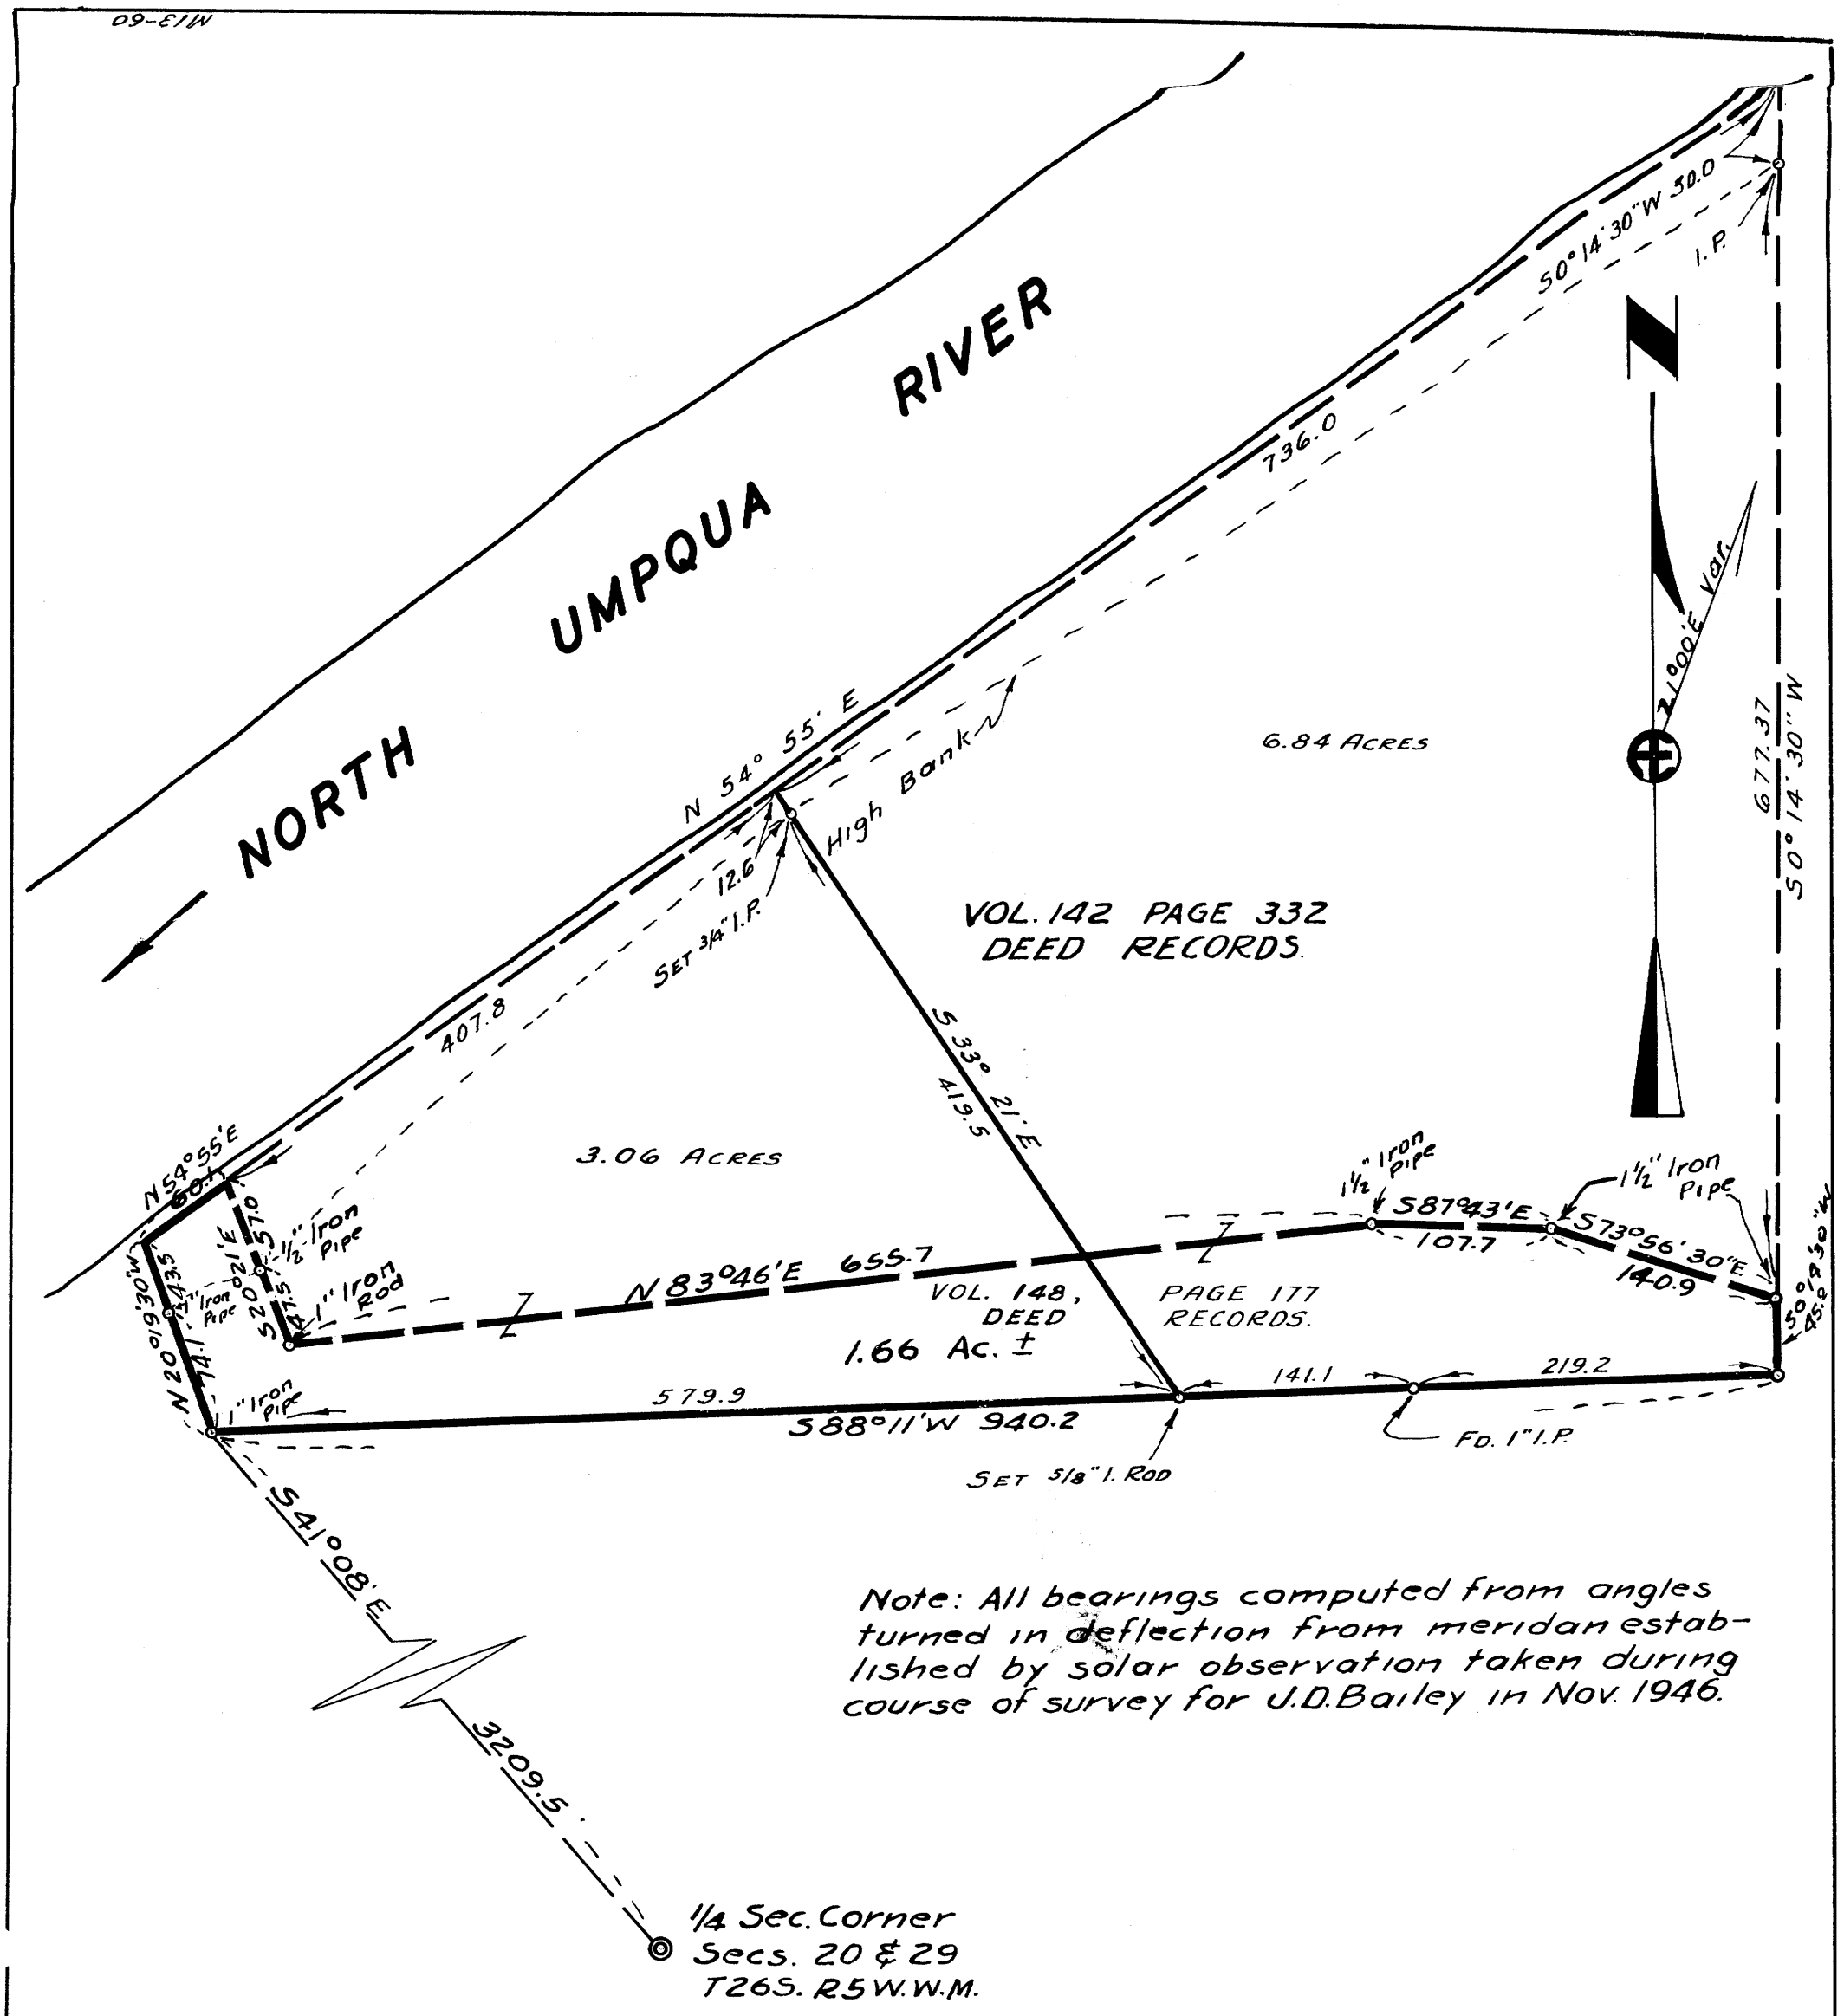

Note: All bearings computed from angles turned in deflection from meridan established by solar observation taken during course of survey for U.D.Bailey in Nov. 1946.

COUNTY SURVEYOR'S OFFICE
DOUGLAS COUNTY OREGON
SURVEY FOR DEED DESCRIPTION
SECTION 20,T26S,R5W.,W.M.

BEN B.IRVING COUNTY SURVEYOR
SURVEYED OCTOBER 24 1947 BY
N E RICHARDSON DEPUTY
SCALE 1" = 100'

OREGON LAND SURVEYOR
N E Richardson
JULY 1, 1953
N. E. RICHARDSON
35

COUNTY SURVEYORS FILE DATA
DO NOT REMOVE FROM OFFICE

SUPPLEMENTAL SURVEY FOR
DIVISION OF PROPERTY
SURVEYED OCTOBER 10.1951

M13-60
FILE 103 DRAWER 39