F.B. H-198
MAP FILE M13+64

FILED
RECEIVED
JAN 1 8 1983
COUNTY SURVEYOR
DOUGLAS COUNTY, ORE.

COUNTY SURVEYORS FILE ONLY
DO NOT REMOVE FROM OFFICE

SECT. 14, T. 23 S. R. 7 W. W.M.

for

E. G. WHIPPLE Mill

Surveyed 1958 — Scale 1" = 500'

Lot Markers shown on this map are: 1" x 1" x 36" iron with cap inscribed - Survey point - Wilford N Haines #239.

REGISTERED OREGON LAND SURVEYOR
Wilford N. Haines
MAY 7, 1968
WILFORD N. HAINES 239

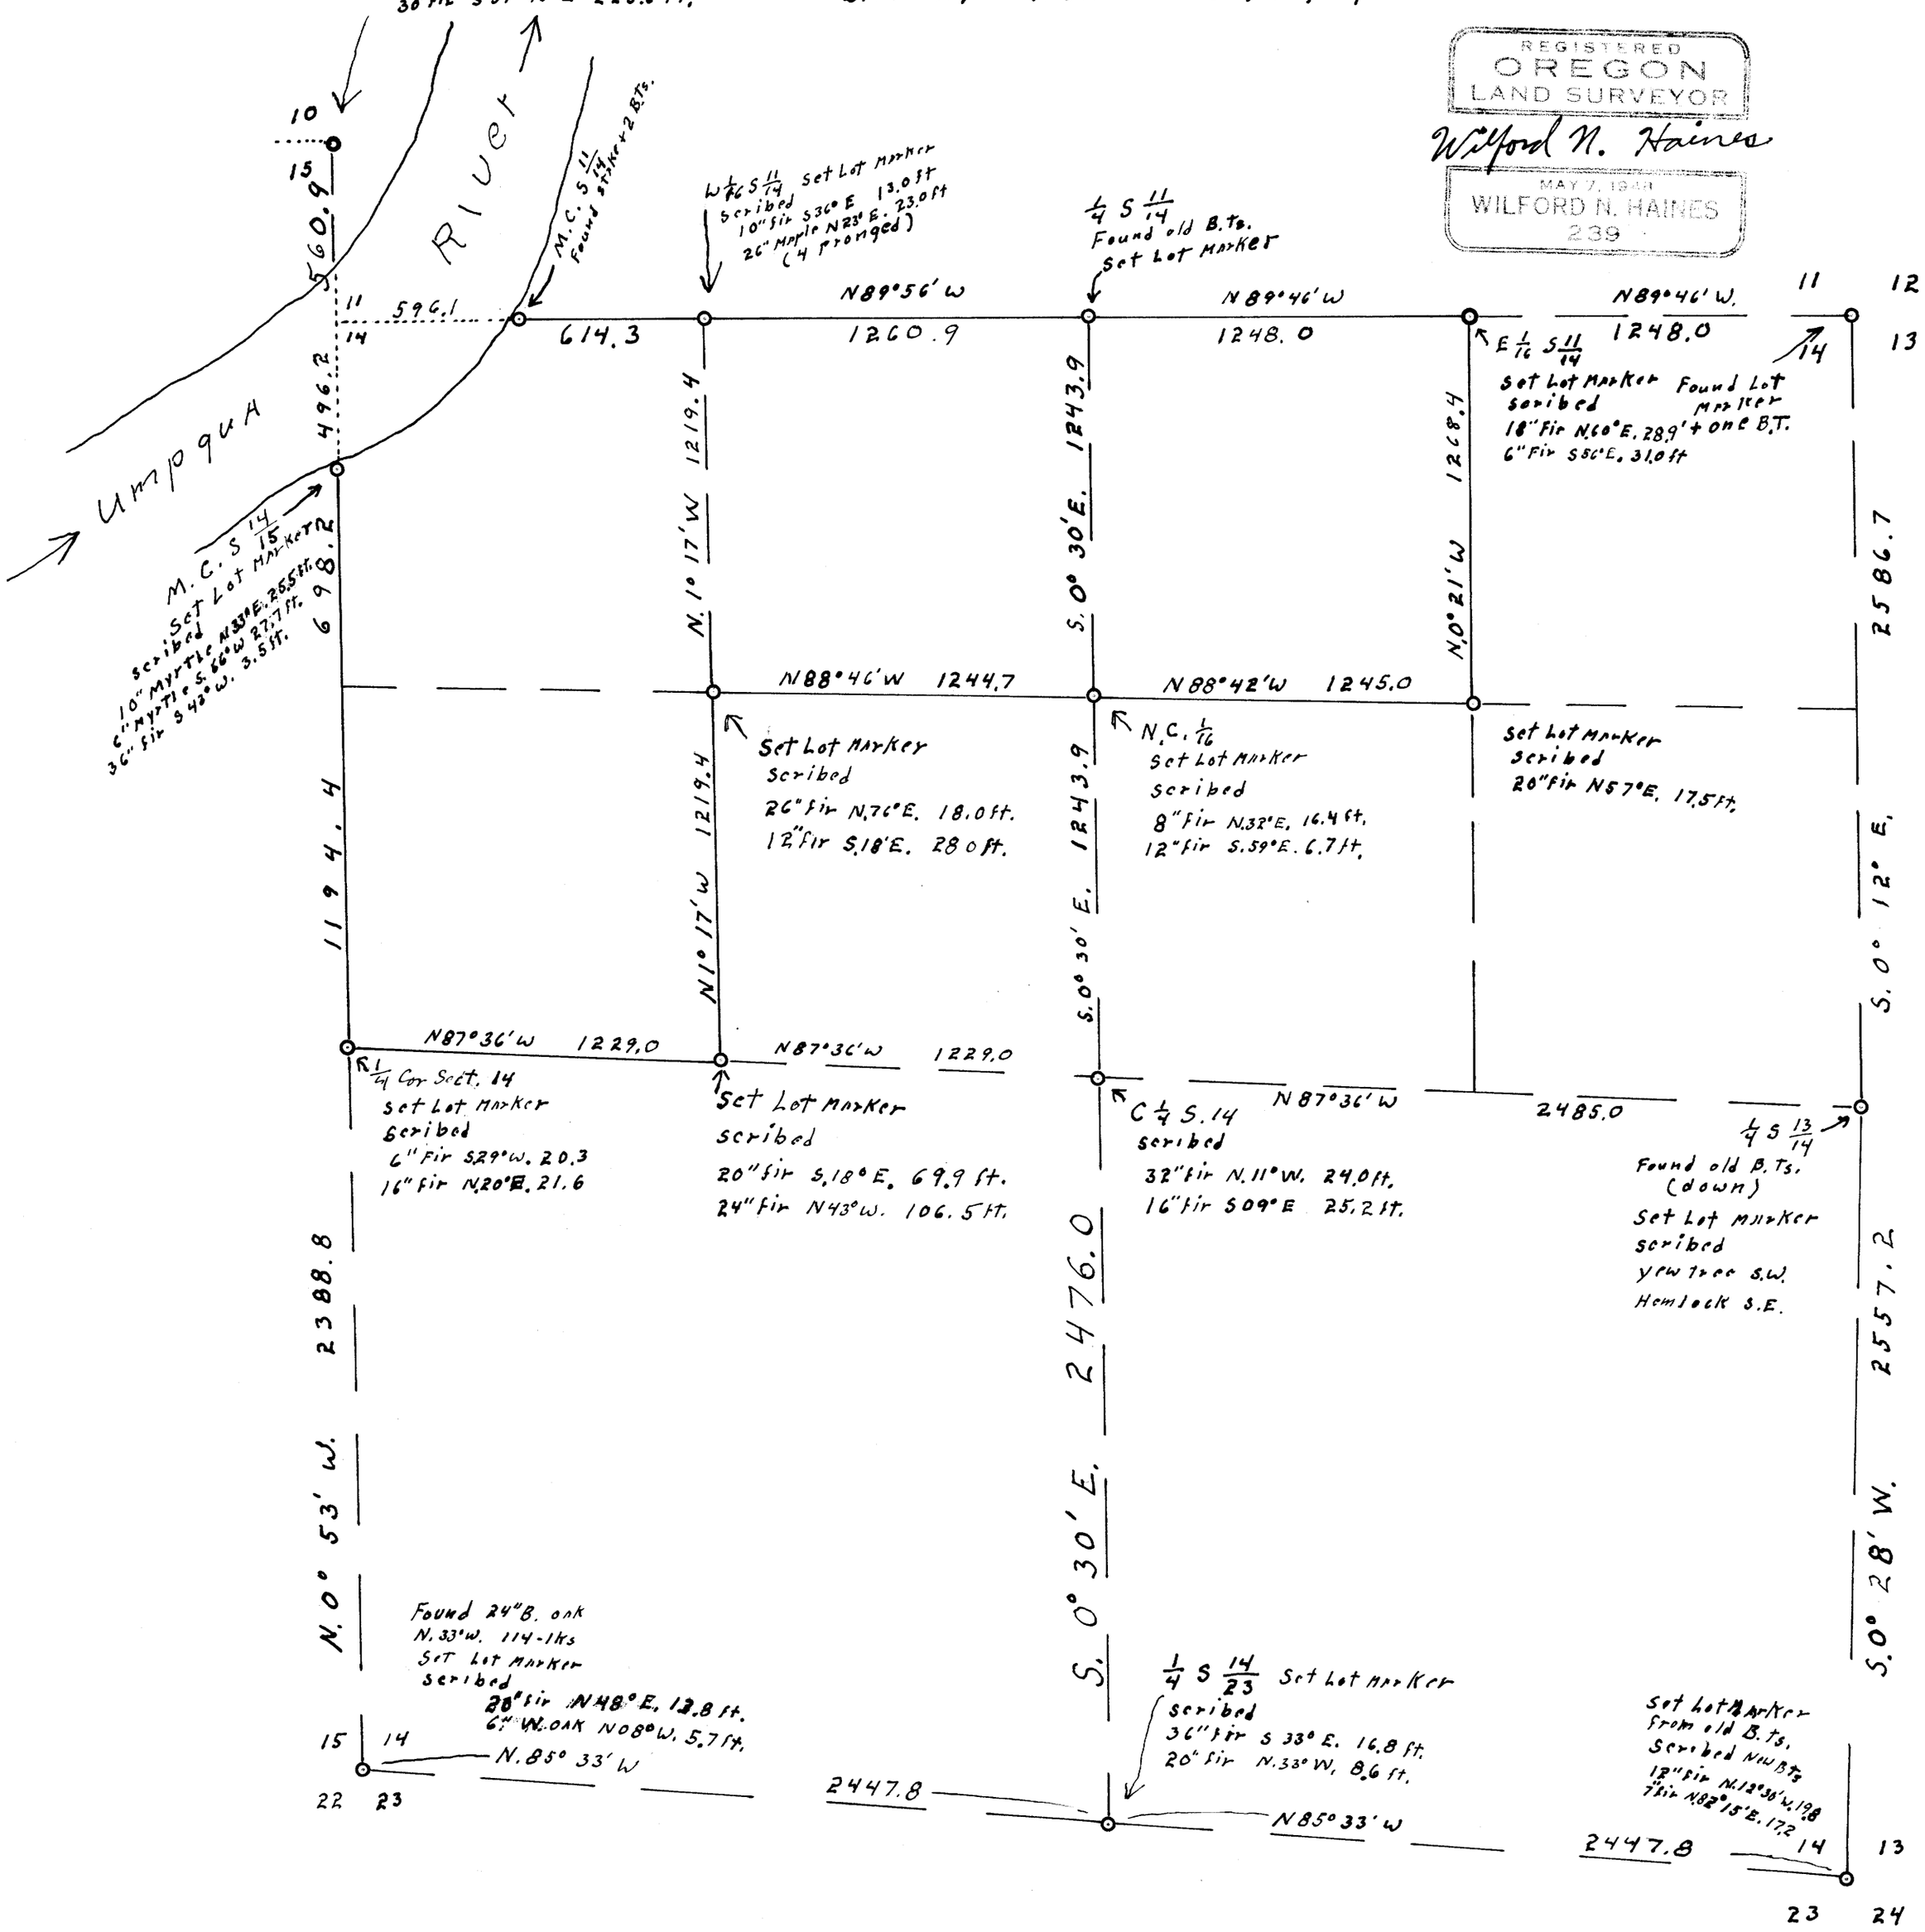

F.B. H-198
MAP FILE M13+64