MAP FILE M13766
611-H
801-H
FILED
RECEIVED
JAN 15 1959
COUNTY SURVEYOR
DOUGLAS COUNTY, ORE.

COUNTY SURVEYORS FILE MAP
DO NOT REMOVE FROM OFFICE

SECT 32, T. 22 S., R 6 W

E. G. WHIPPLE MILL, DRAIN

Scale 1" = 400'

1958

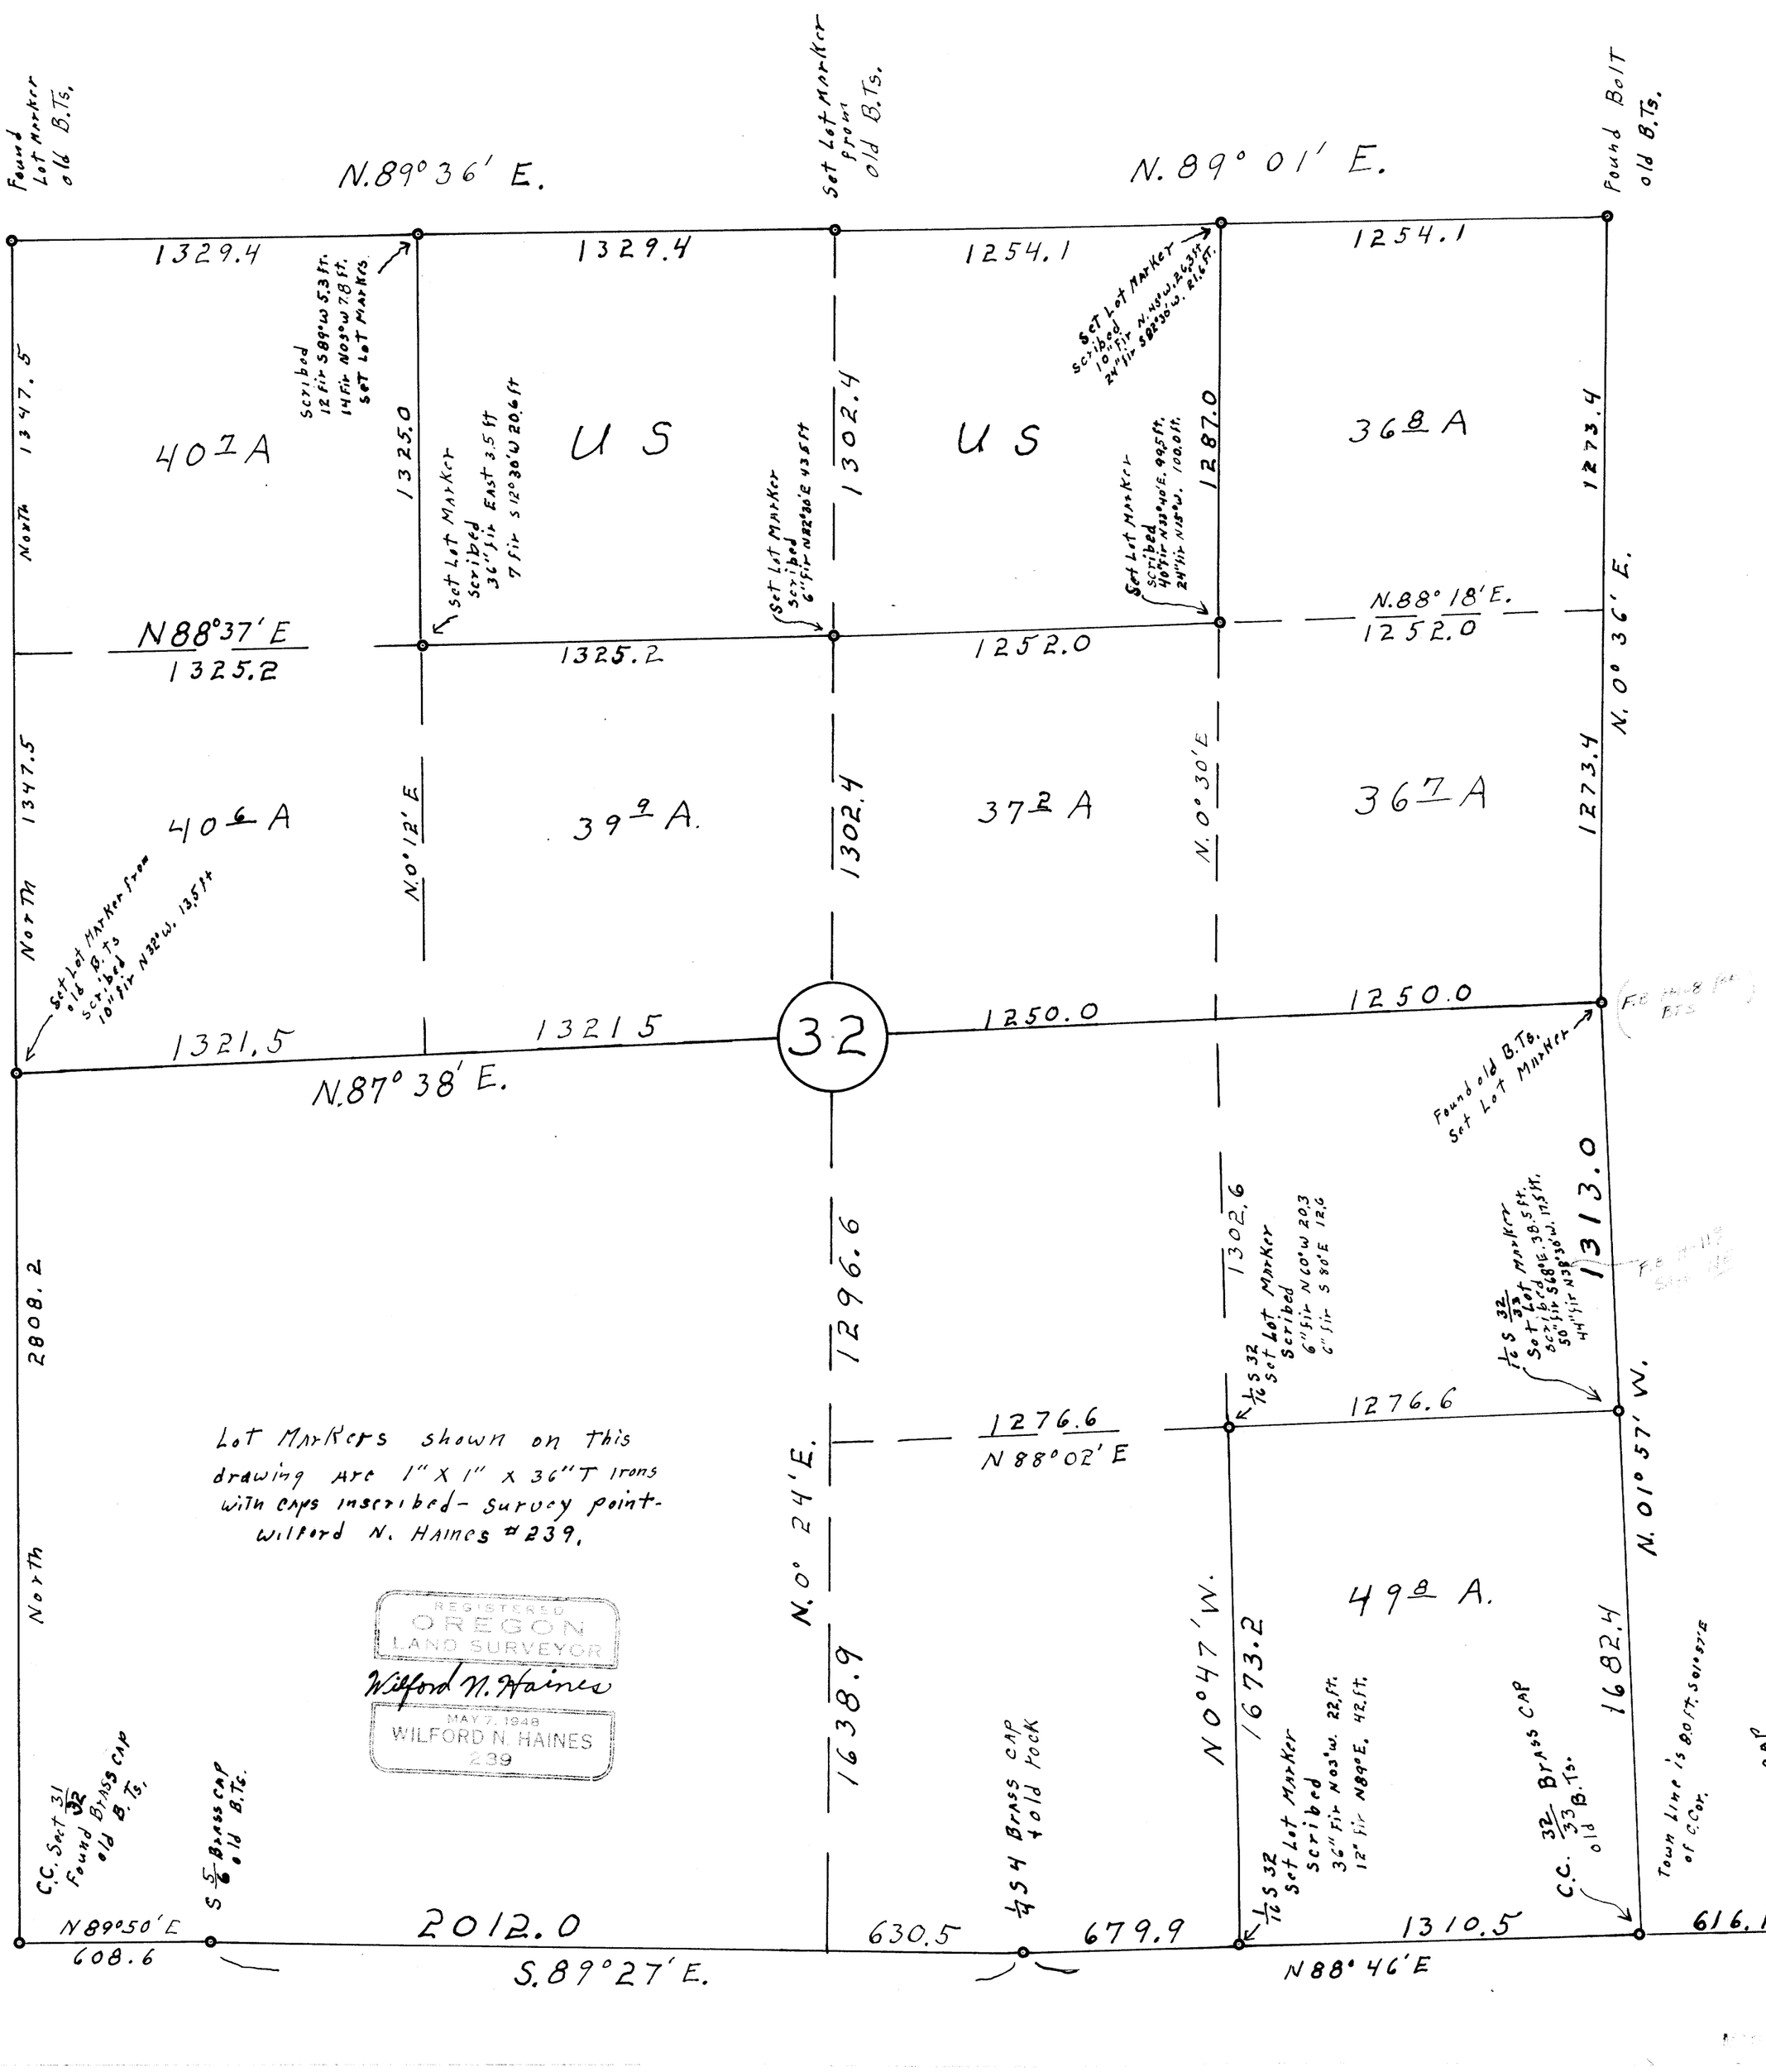

H-108
H-119

MAP FILE M13766