


Fd: Brass Cap

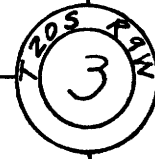

S 89° 24' W

Fd: Brass Cap



1288.1

DUE NORTH

Blazed Line

1304.7

DUE NORTH

1/16 COR.
SET POST

1288.1

1304.7

N 89° 30' W
2636

Fd: Brass Cap




Fd: 1 Fir BT (Windfall)



FILED
RECEIVED

OCT 31 1958

COUNTY SURVEYOR
DOUGLAS COUNTY, ORE.

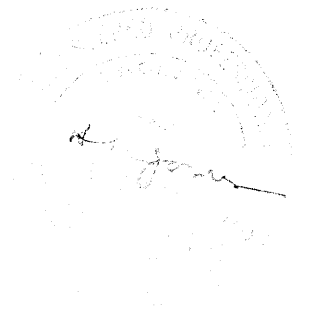

COUNTY SURVEYORS FILE DATA
DO NOT REMOVE FROM OFFICE

PARTIAL SUBDIVISION OF SECTION 3
T 20S R 9W
FOR BARKER TIMBER Co
Scale 1" = 400'
August 1958

C.S. FILE 42 / 39A
M 13 - 7

NIGHT PHONE
H. R. JONES DI 4-5500
N. JULIANO

OFFICE PHONE
DI 5-6595

**HERBERT R. JONES
ENGINEERING Co.**

CASCADE BLDG.
163 East Twelfth Street

EUGENE, OREGON

October 29, 1958

Douglas County Surveyor
Douglas County Courthouse
Roseburg, Oregon

Dear Sir:

Enclosed is a tracing and one print of a compass survey made for the Barker Timber Co. in order to establish the South boundary of an O&C timber sale that they had bought in the $N\frac{1}{2}SE\frac{1}{4}$ of section 3, T 20 S - R 9 W.

We were unable to find the brass cap that had been set at the South $\frac{1}{4}$ cor of section 3 but found the original fir BT and the original yew BT. Both the fir BT and the yew BT are now windfalls and have slid downhill, somewhat, from their original positions.

Because of the fact we did not need the S.W. corner of the $N\frac{1}{2}SE\frac{1}{4}$ we did not run the North & South centerline the full mile North to the North $\frac{1}{4}$ corner, but only to the East & West centerline which we established by running a true line from the West $\frac{1}{4}$ corner to the East $\frac{1}{4}$ corner.

All the above described work was done with a staff compass and chain.

Very truly yours,

Herbert R. Jones

FILED

RECEIVED

OCT 31 1958

COUNTY SURVEYOR
DOUGLAS COUNTY, ORE.

C. S. File No. 42/394