map 1916

5/33

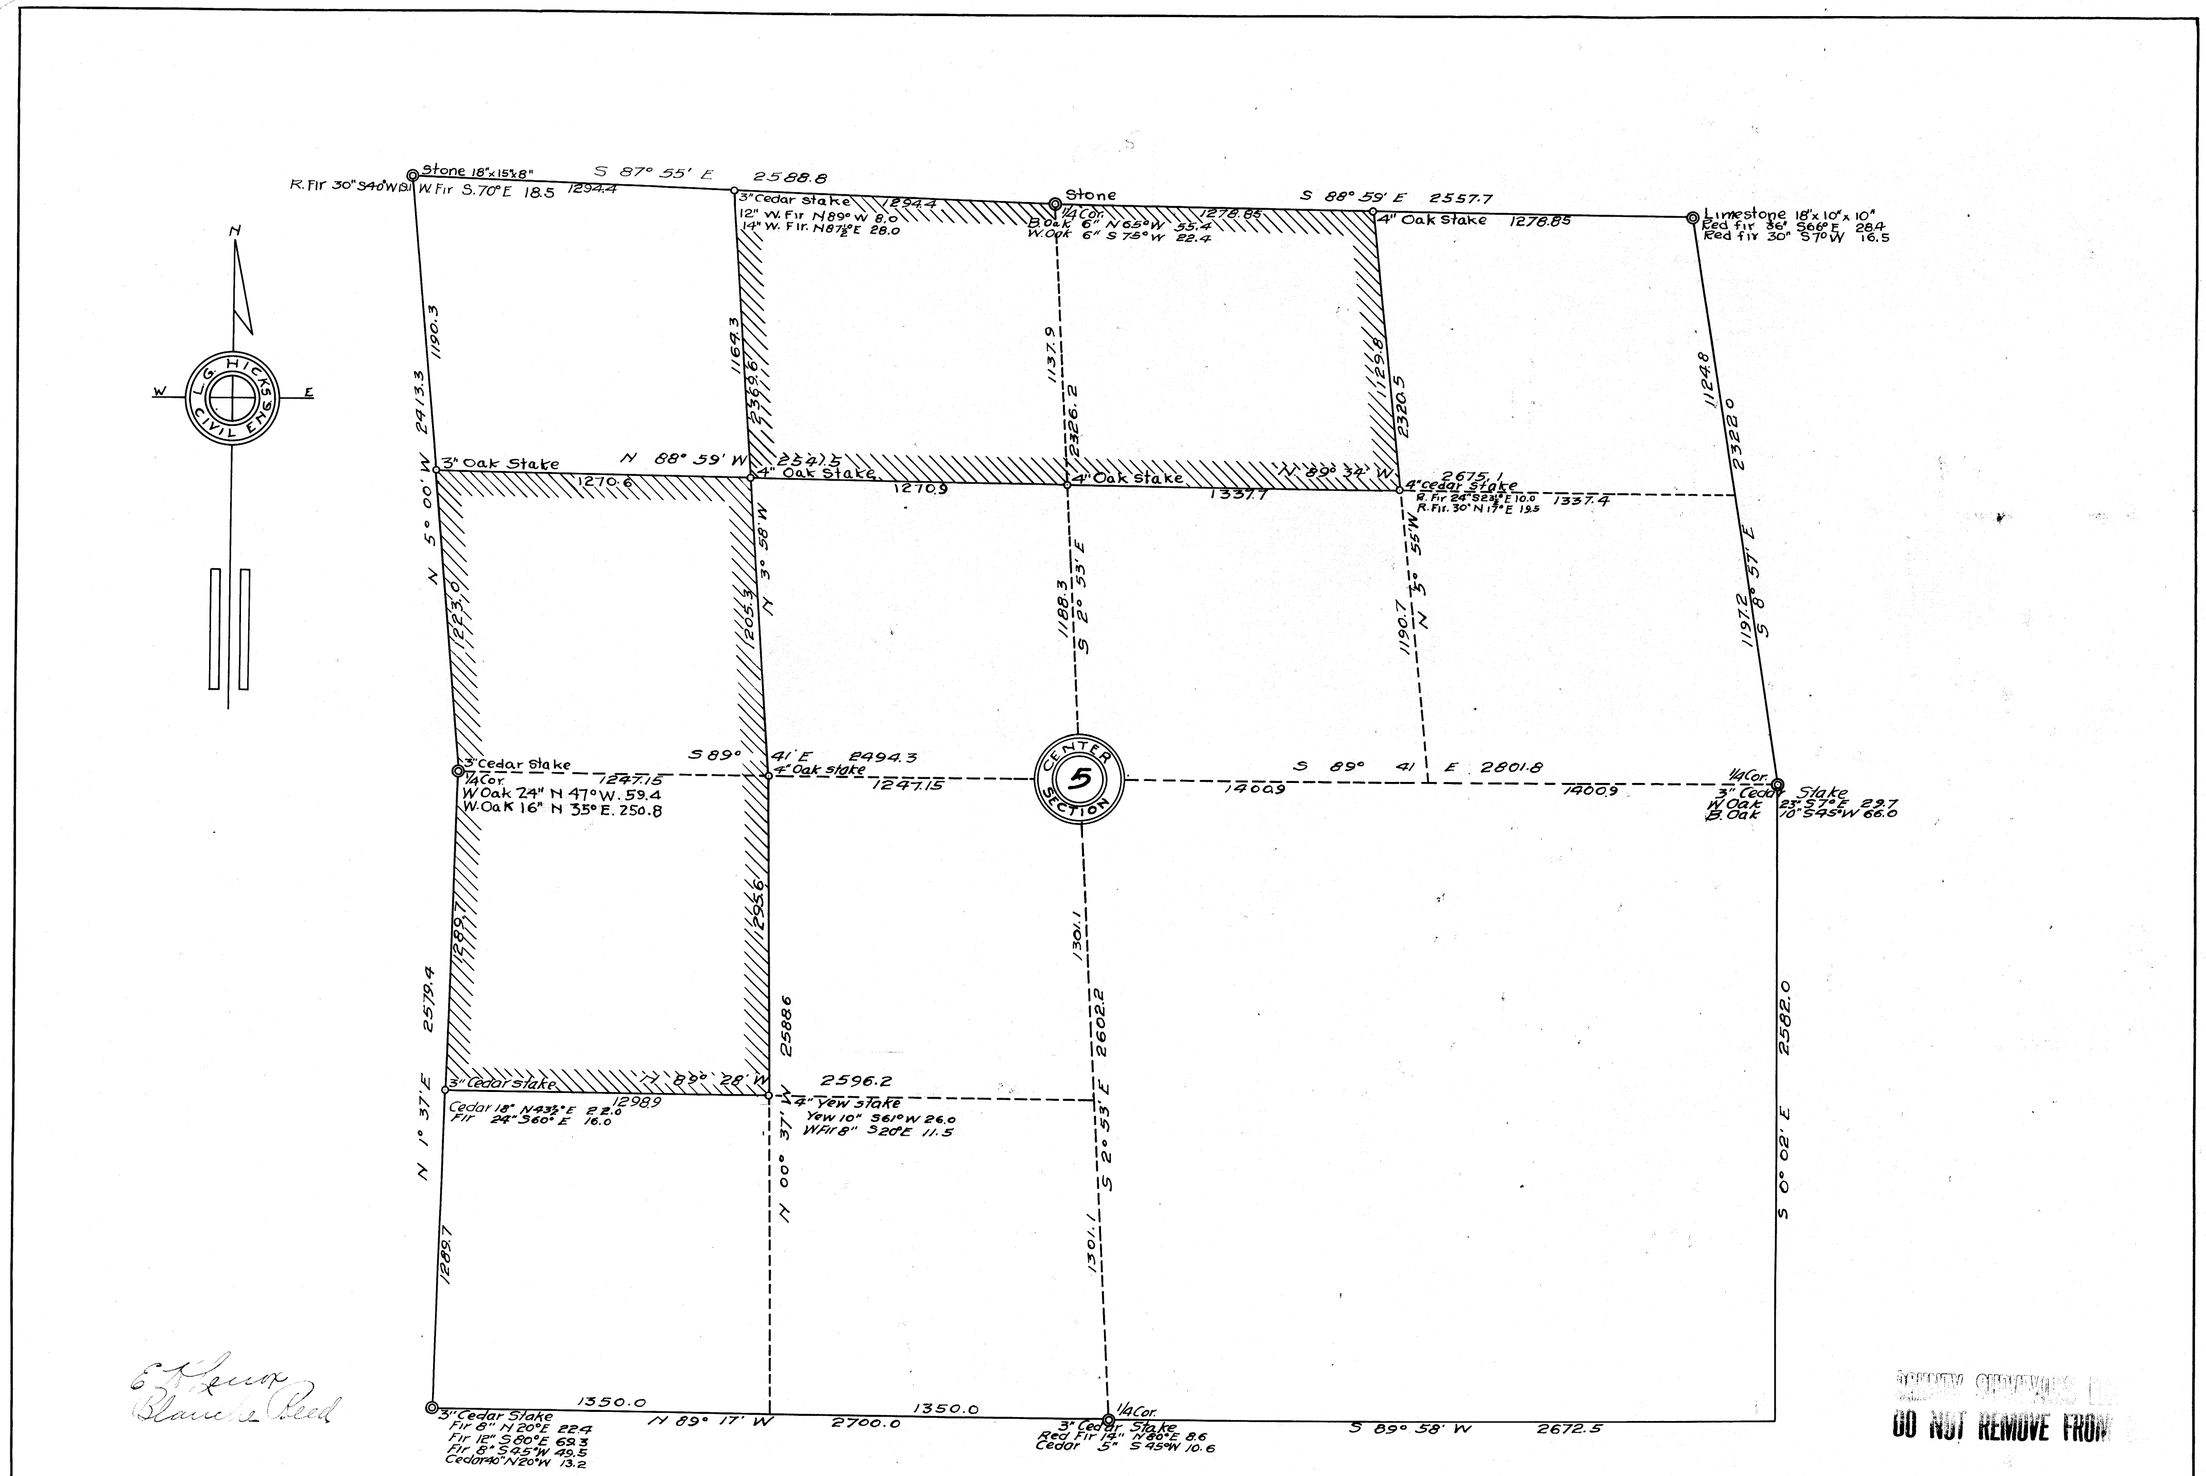

E. Lenox
Blanche Reed

SURVEY SERVICES CO.
DO NOT REMOVE FROM

BOUNDARIES OF SECTION FIVE
TOWNSHIP 30 SOUTH.
RANGE 6 WEST

Scale 1 in. = 400 ft.

From the Office of L. G. Hicks Civil Engr.
Roseburg, Ore.

T.S. File 19.28
Map File M13-72