M14-24

COUNTY SURVEYORS FILE DATA
DO NOT REMOVE FROM OFFICE

FILED L.L.
RECEIVED
MAR 27 1959
COUNTY SURVEYOR
DOUGLAS COUNTY, ORE.

SURVEY FOR DEED DESCRIPTION SHOWING PORTION OF NE1/4SE1/4 SECTION 31, T 24 S, R 3 W, W.M.

SURVEYED FOR: RAY LANG — MARCH 1959

SURVEYED BY: G. R. LECKLIDER — SCALE: 1" = 100'

○ DENOTES 1/2" IRON ROD SET FOR CORNER

● DENOTES CORNER FOUND

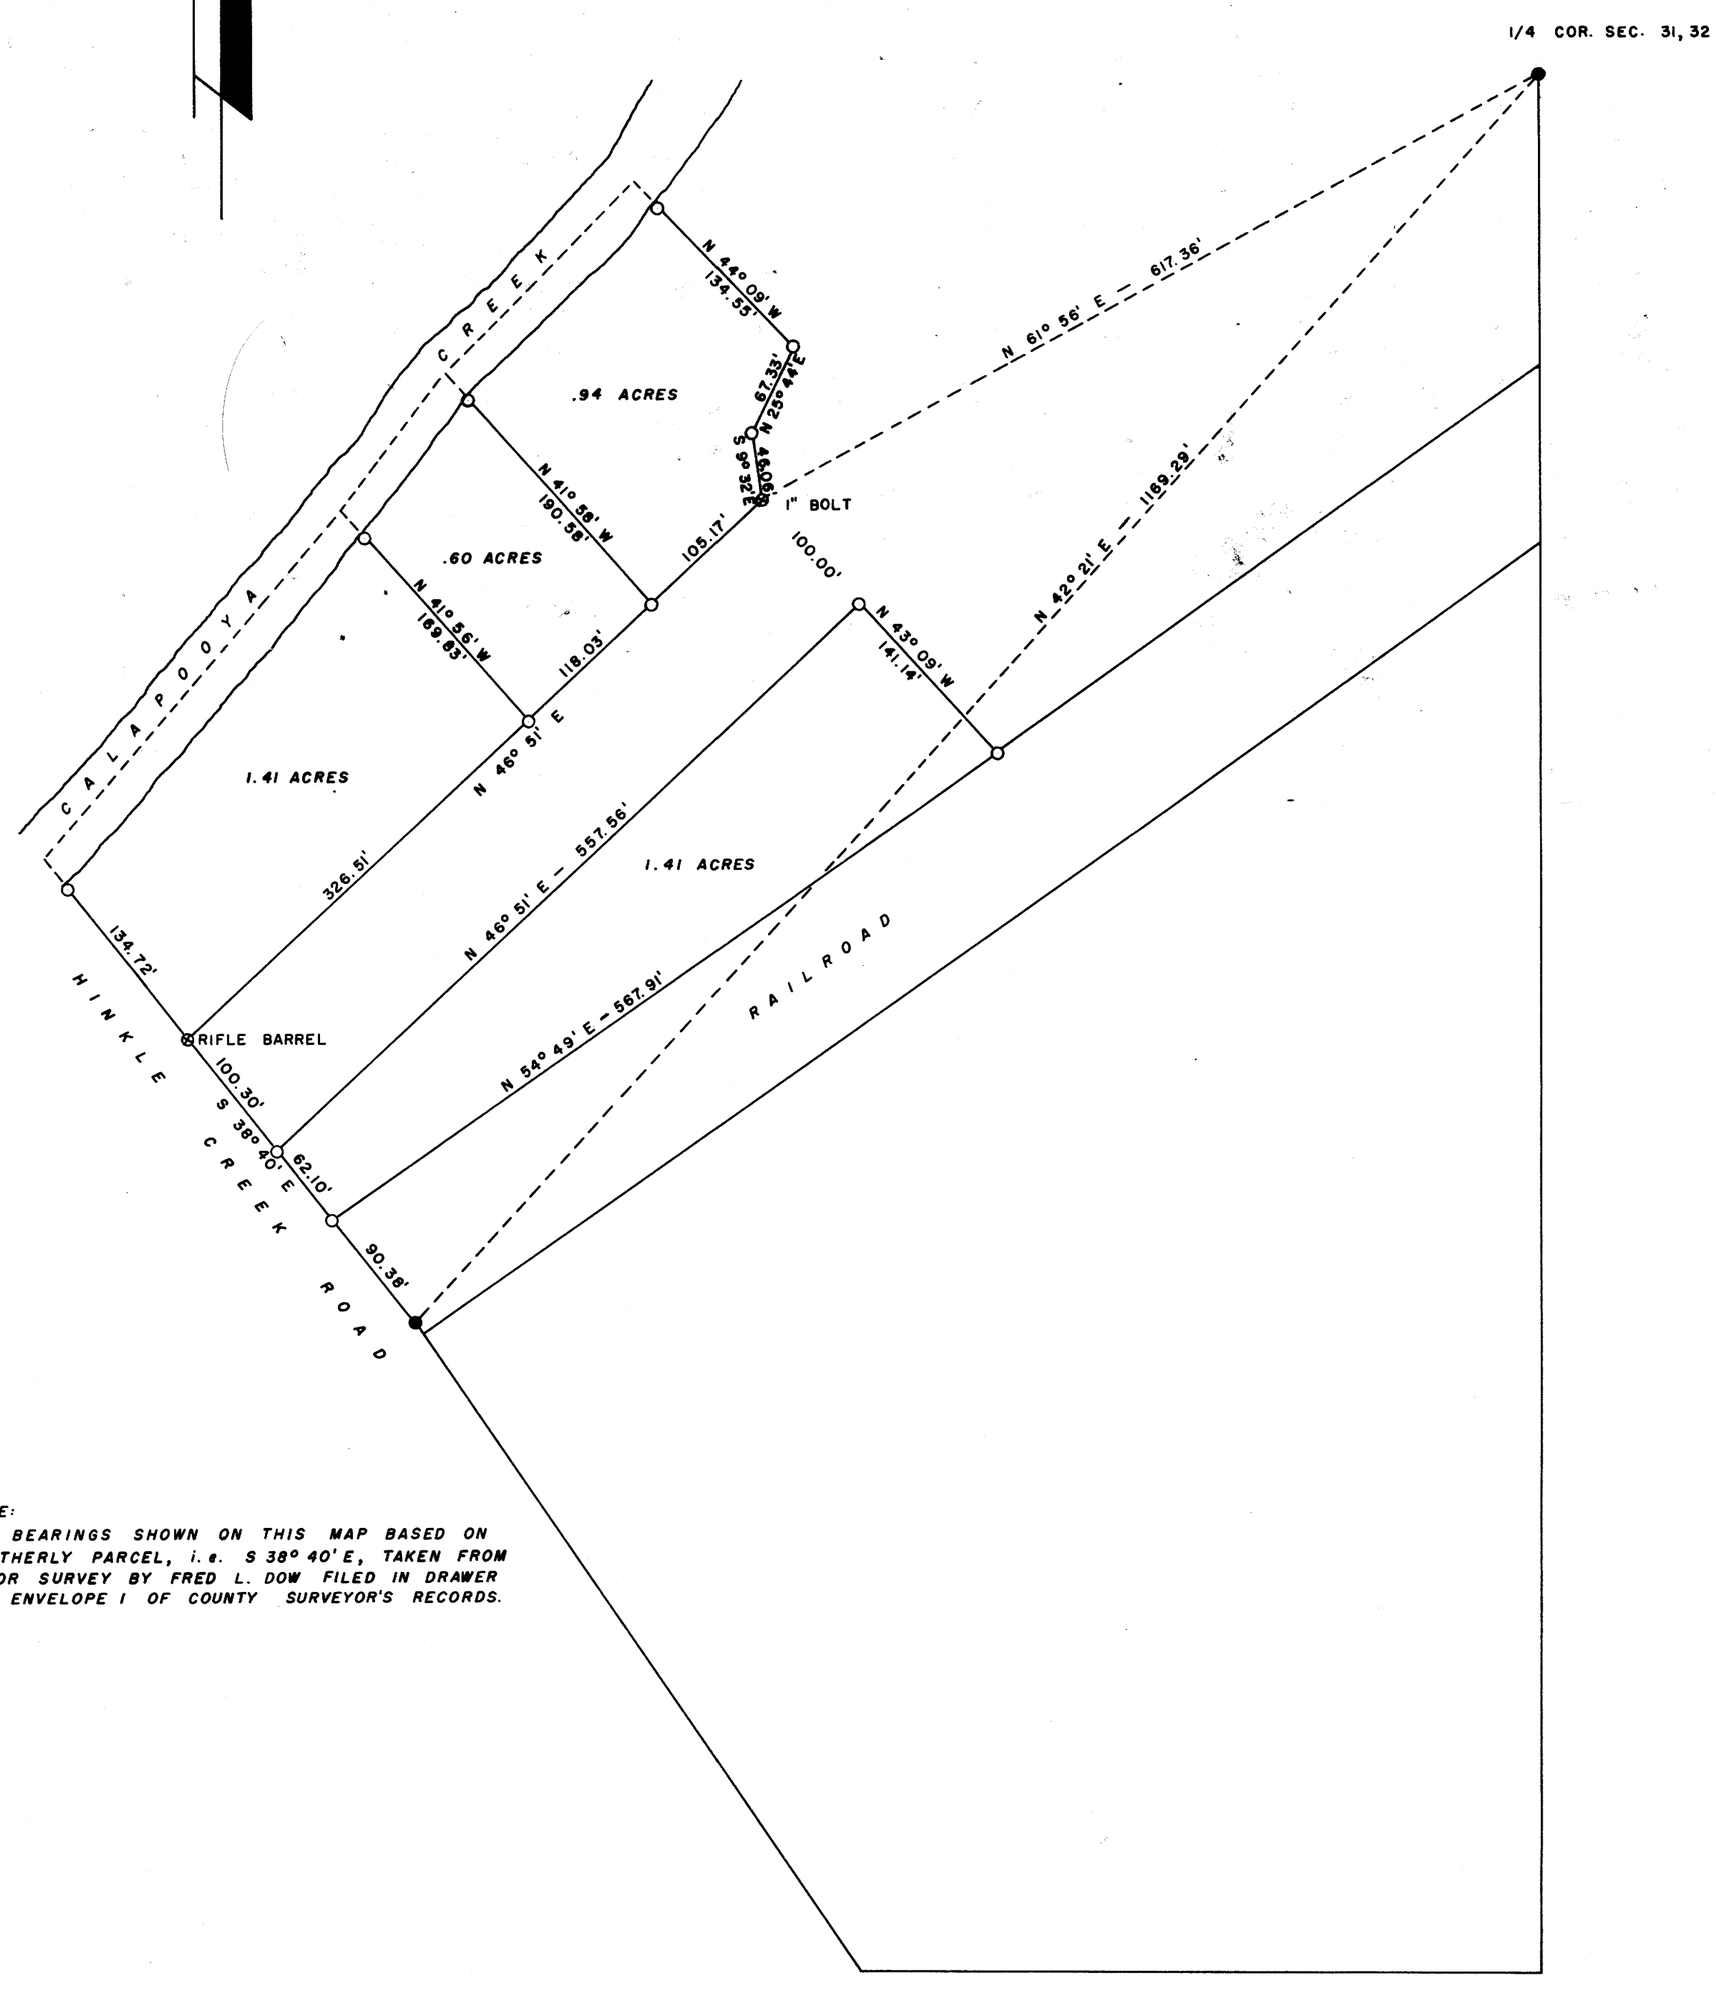

NOTE:
BEARINGS SHOWN ON THIS MAP BASED ON SOUTHERLY PARCEL, i.e. S 38° 40' E, TAKEN FROM PRIOR SURVEY BY FRED L. DOW FILED IN DRAWER 50, ENVELOPE 1 OF COUNTY SURVEYOR'S RECORDS.

REGISTERED PROFESSIONAL ENGINEER 4079 OREGON OCT. 15, 1956 G. ROBERT LECKLIDER

G. Robert Lecklider

MAP FILE M 14-24