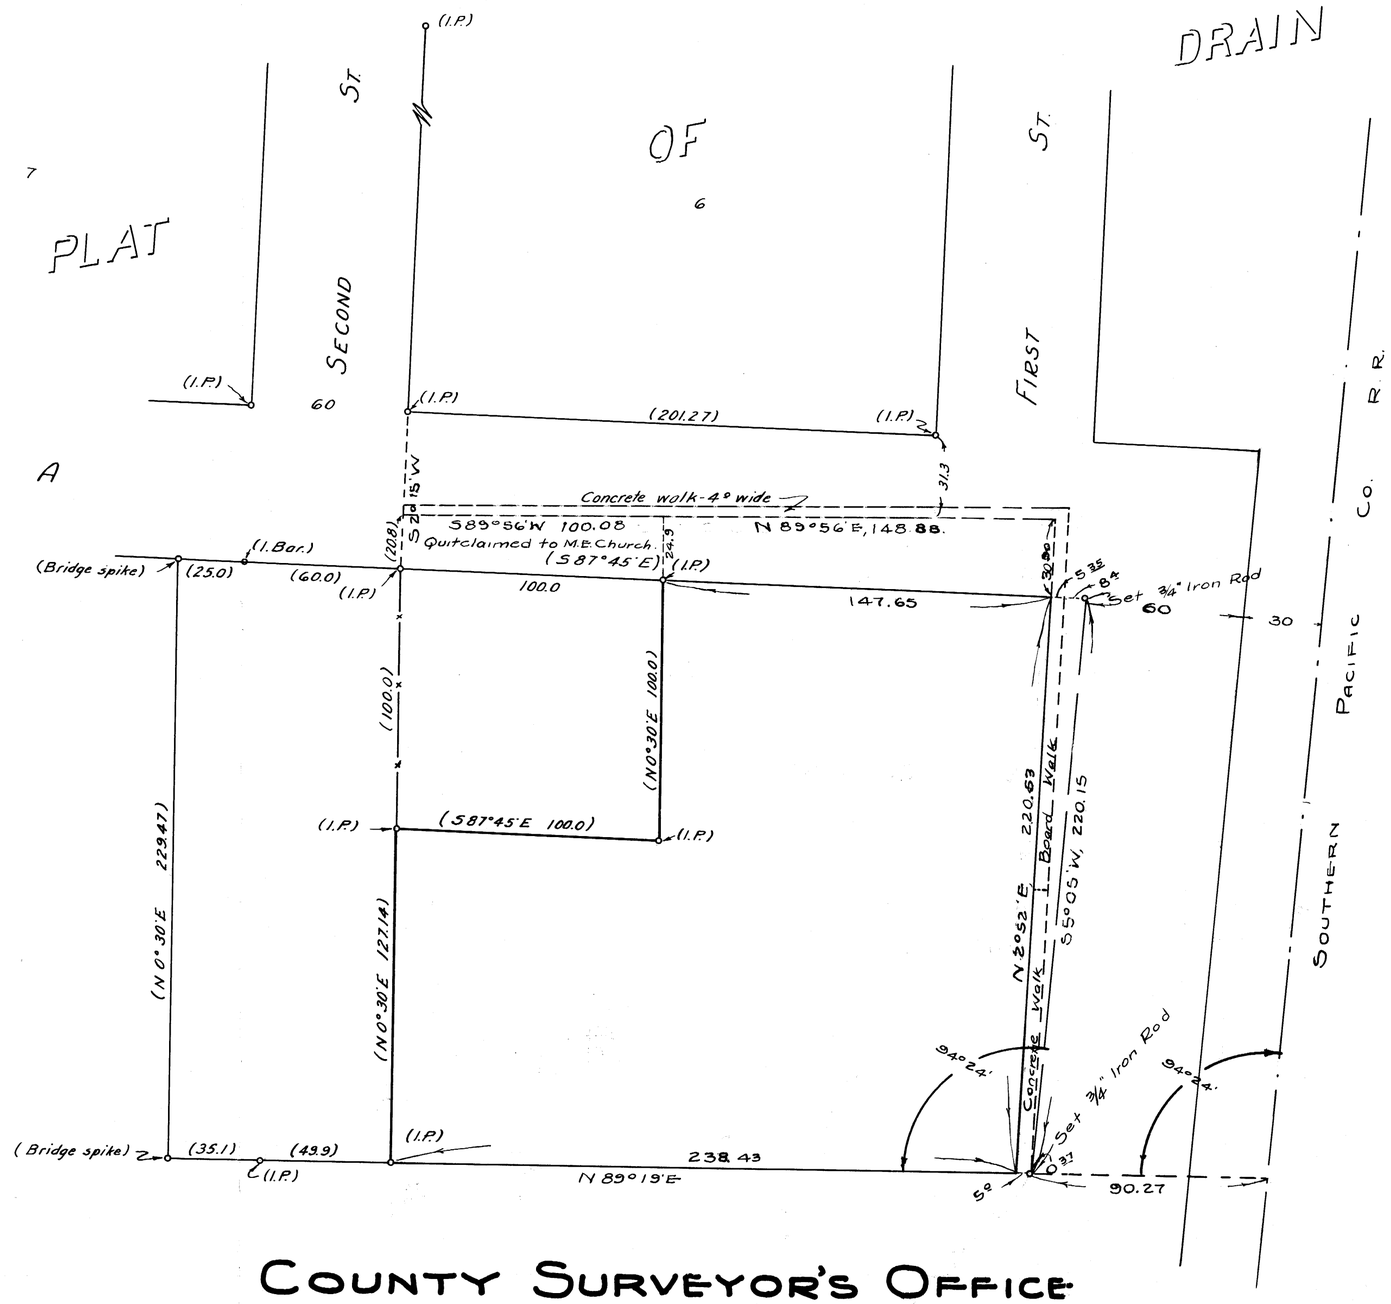

Scale 1" = 60'

Note:-
Bearings shown are True, based on Solar Observation made Jan. 27, 1947.
Data shown ( ) is from survey made by this office for Drain M.E. Church, on Aug. 23, 1948.

COUNTY SURVEYOR'S OFFICE
DOUGLAS COUNTY OREGON
SURVEY FOR MRS. M. HEDRICK
DRAIN OREGON

REGISTERED
OREGON
LAND SURVEYOR
N.E. Richardson
JULY 7 1944
N. E. RICHARDSON
35

BEN B. IRVING COUNTY SURVEYOR
SURVEYED, JUNE 14, 1950, BY
N.E. RICHARDSON DEPUTY

COUNTY SURVEYORS FILE DATA
DO NOT REMOVE FROM OFFICE

M14-57
C.S. FILE 44/69
MAP FILE M14-57