M14-58

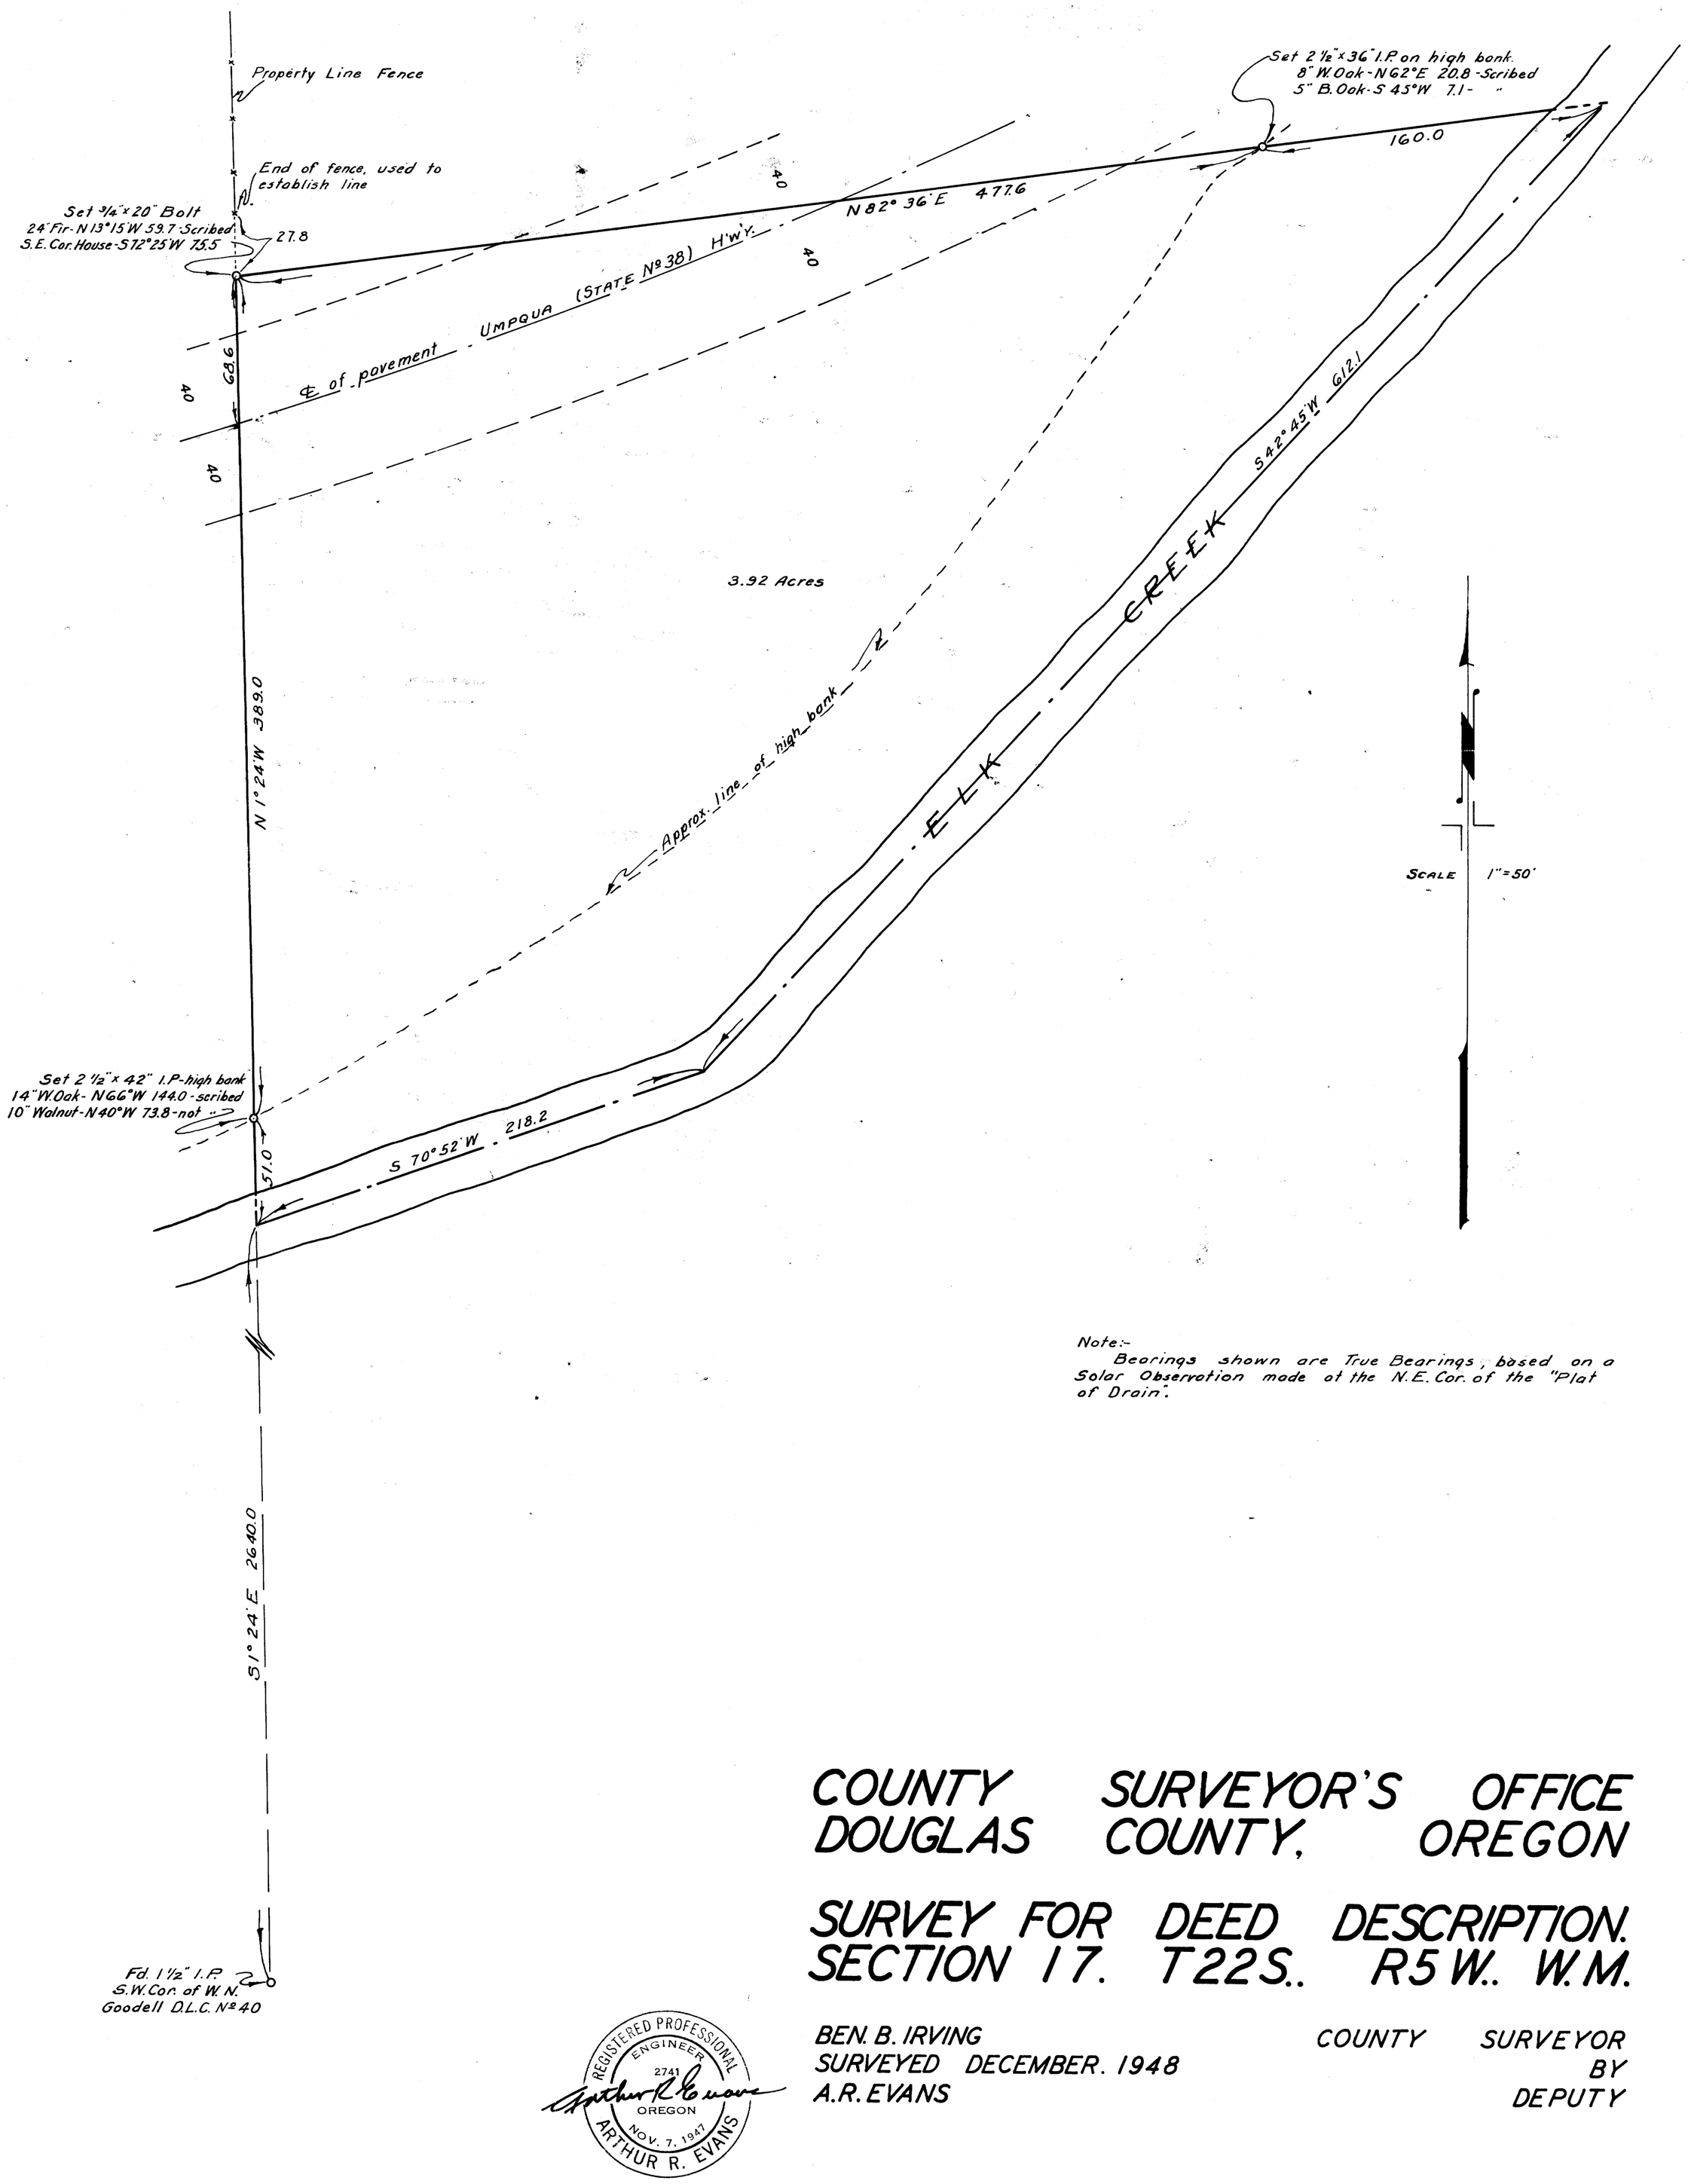


Note:-
Bearings shown are True Bearings, based on a Solar Observation made at the N.E. Cor. of the "Plat of Drain".

# COUNTY SURVEYOR'S OFFICE
# DOUGLAS COUNTY, OREGON

## SURVEY FOR DEED DESCRIPTION.
## SECTION 17. T22S.. R5W.. W.M.

BEN. B. IRVING — COUNTY SURVEYOR
SURVEYED DECEMBER. 1948 — BY
A.R. EVANS — DEPUTY

REGISTERED PROFESSIONAL ENGINEER 2741 OREGON NOV. 7, 1947 ARTHUR R. EVANS

COUNTY SURVEYORS FILE DATA
DO NOT REMOVE FROM OFFICE

C.S. File 43-1-2

Map File M14-58