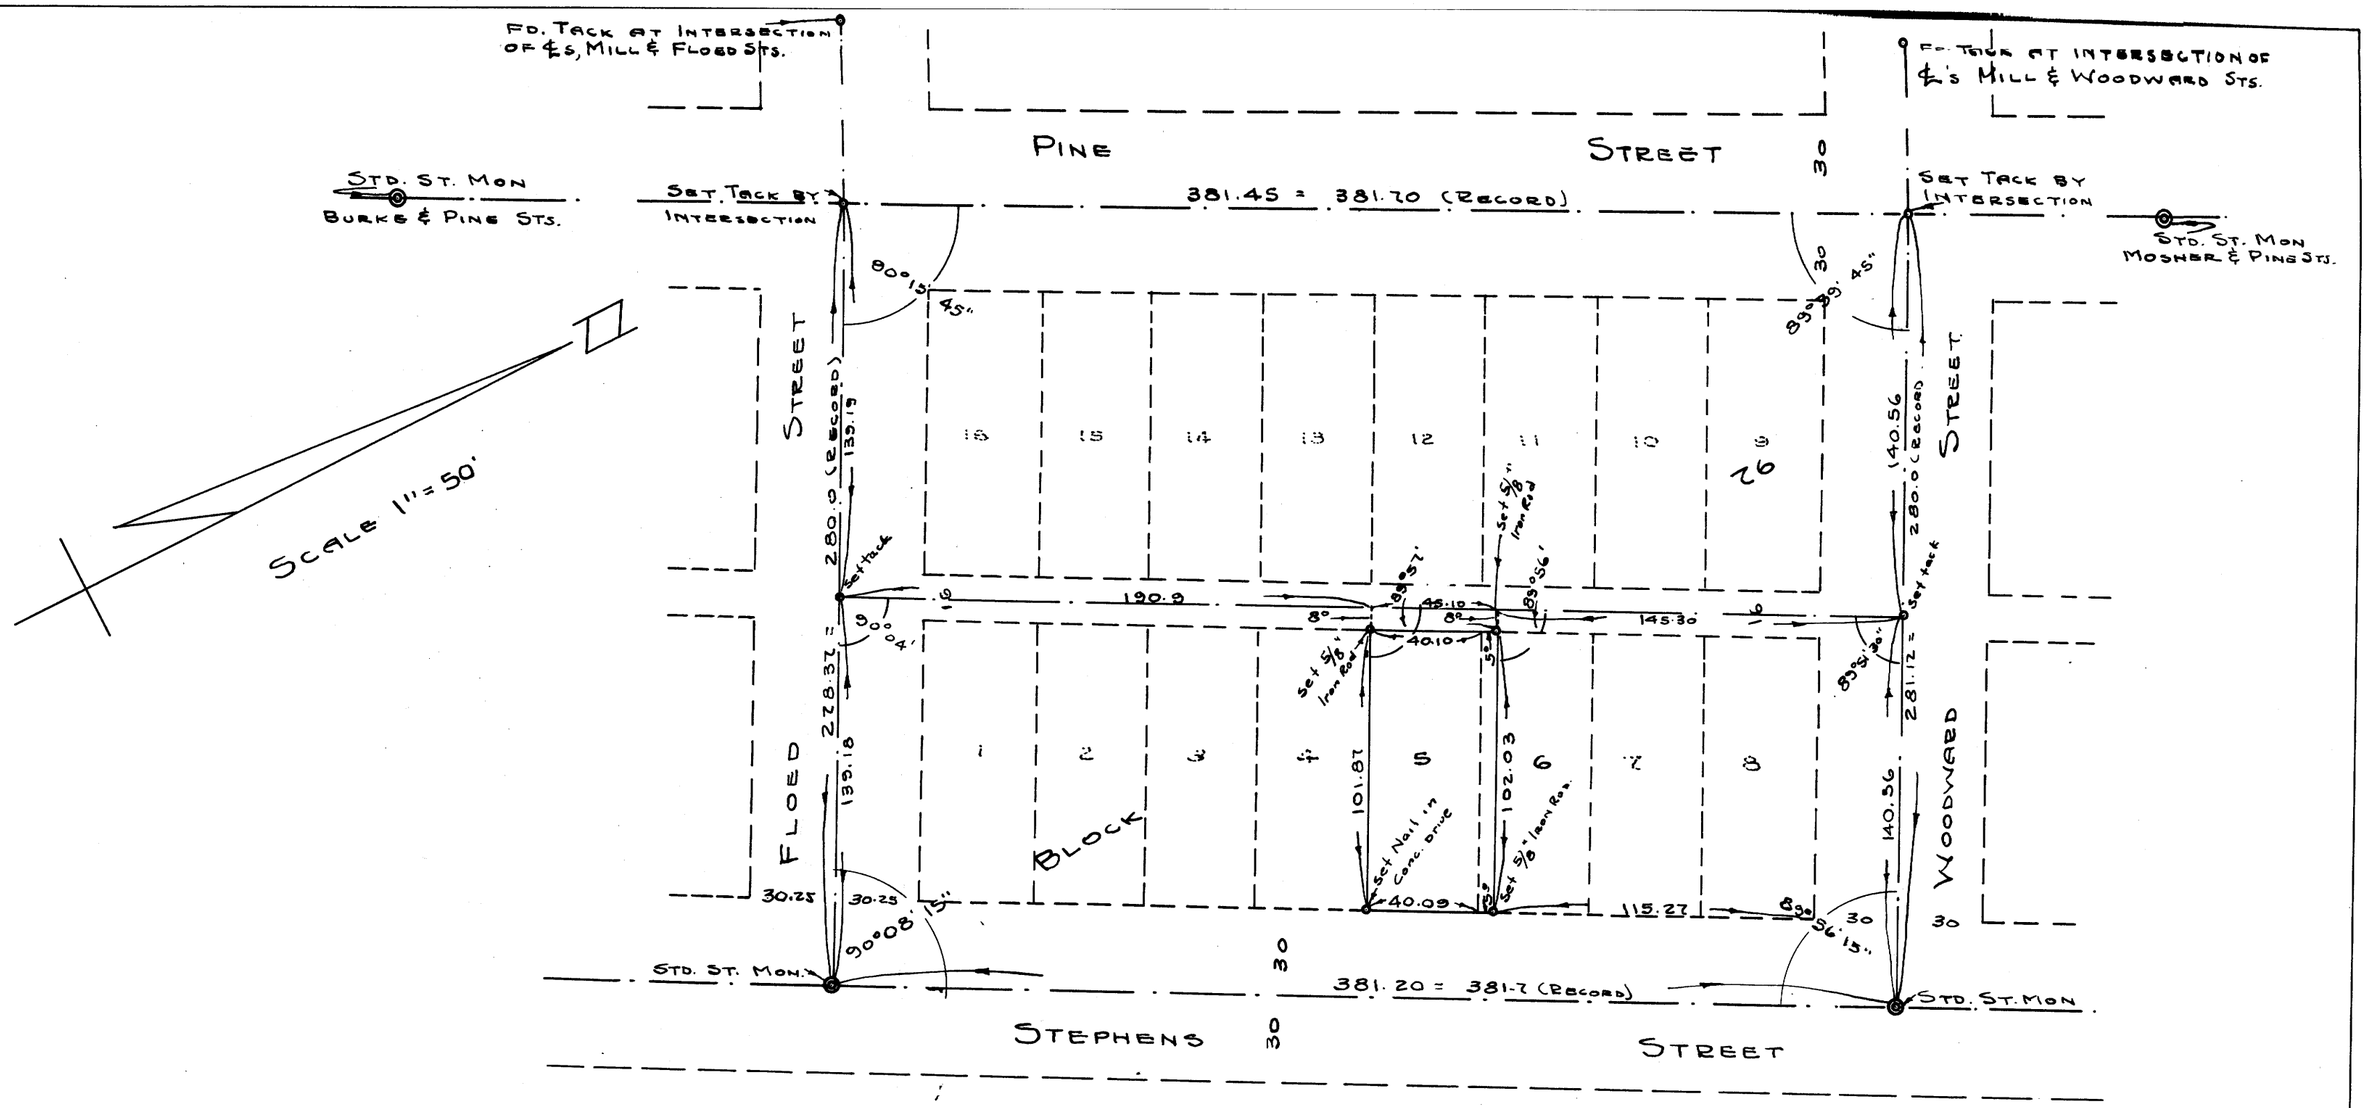

SURVEY TO SET LOT CORNERS
LOT 5 & THE SOUTHERLY 5 FT.
OF LOT 6, BLOCK 76
FOURTH SECT. OF SOUTHERN ADD'N
TO ROSEBURG OREGON

GRANT & EVANS, ENGINEERS
ROSEBURG OREGON
SURVEYED MAR. 11-12, 1953

REGISTERED PROFESSIONAL ENGINEER 2741 OREGON NOV. 7, 1947 ARTHUR R. EVANS

NOTE: RECORD DIMENSIONS OF LOTS ARE 40.15 FT BY 102.0 FT. ACTUAL MEASURED DISTANCES BETWEEN INTERSECTIONS OF ℄S ARE AS SHOWN LOT DIMENSIONS WERE PROPORTIONED ACCORDINGLY

COUNTY SURVEYORS FILE DATA
DO NOT REMOVE FROM OFFICE

#1-137

MAP FILE M-44-63