M 14-66

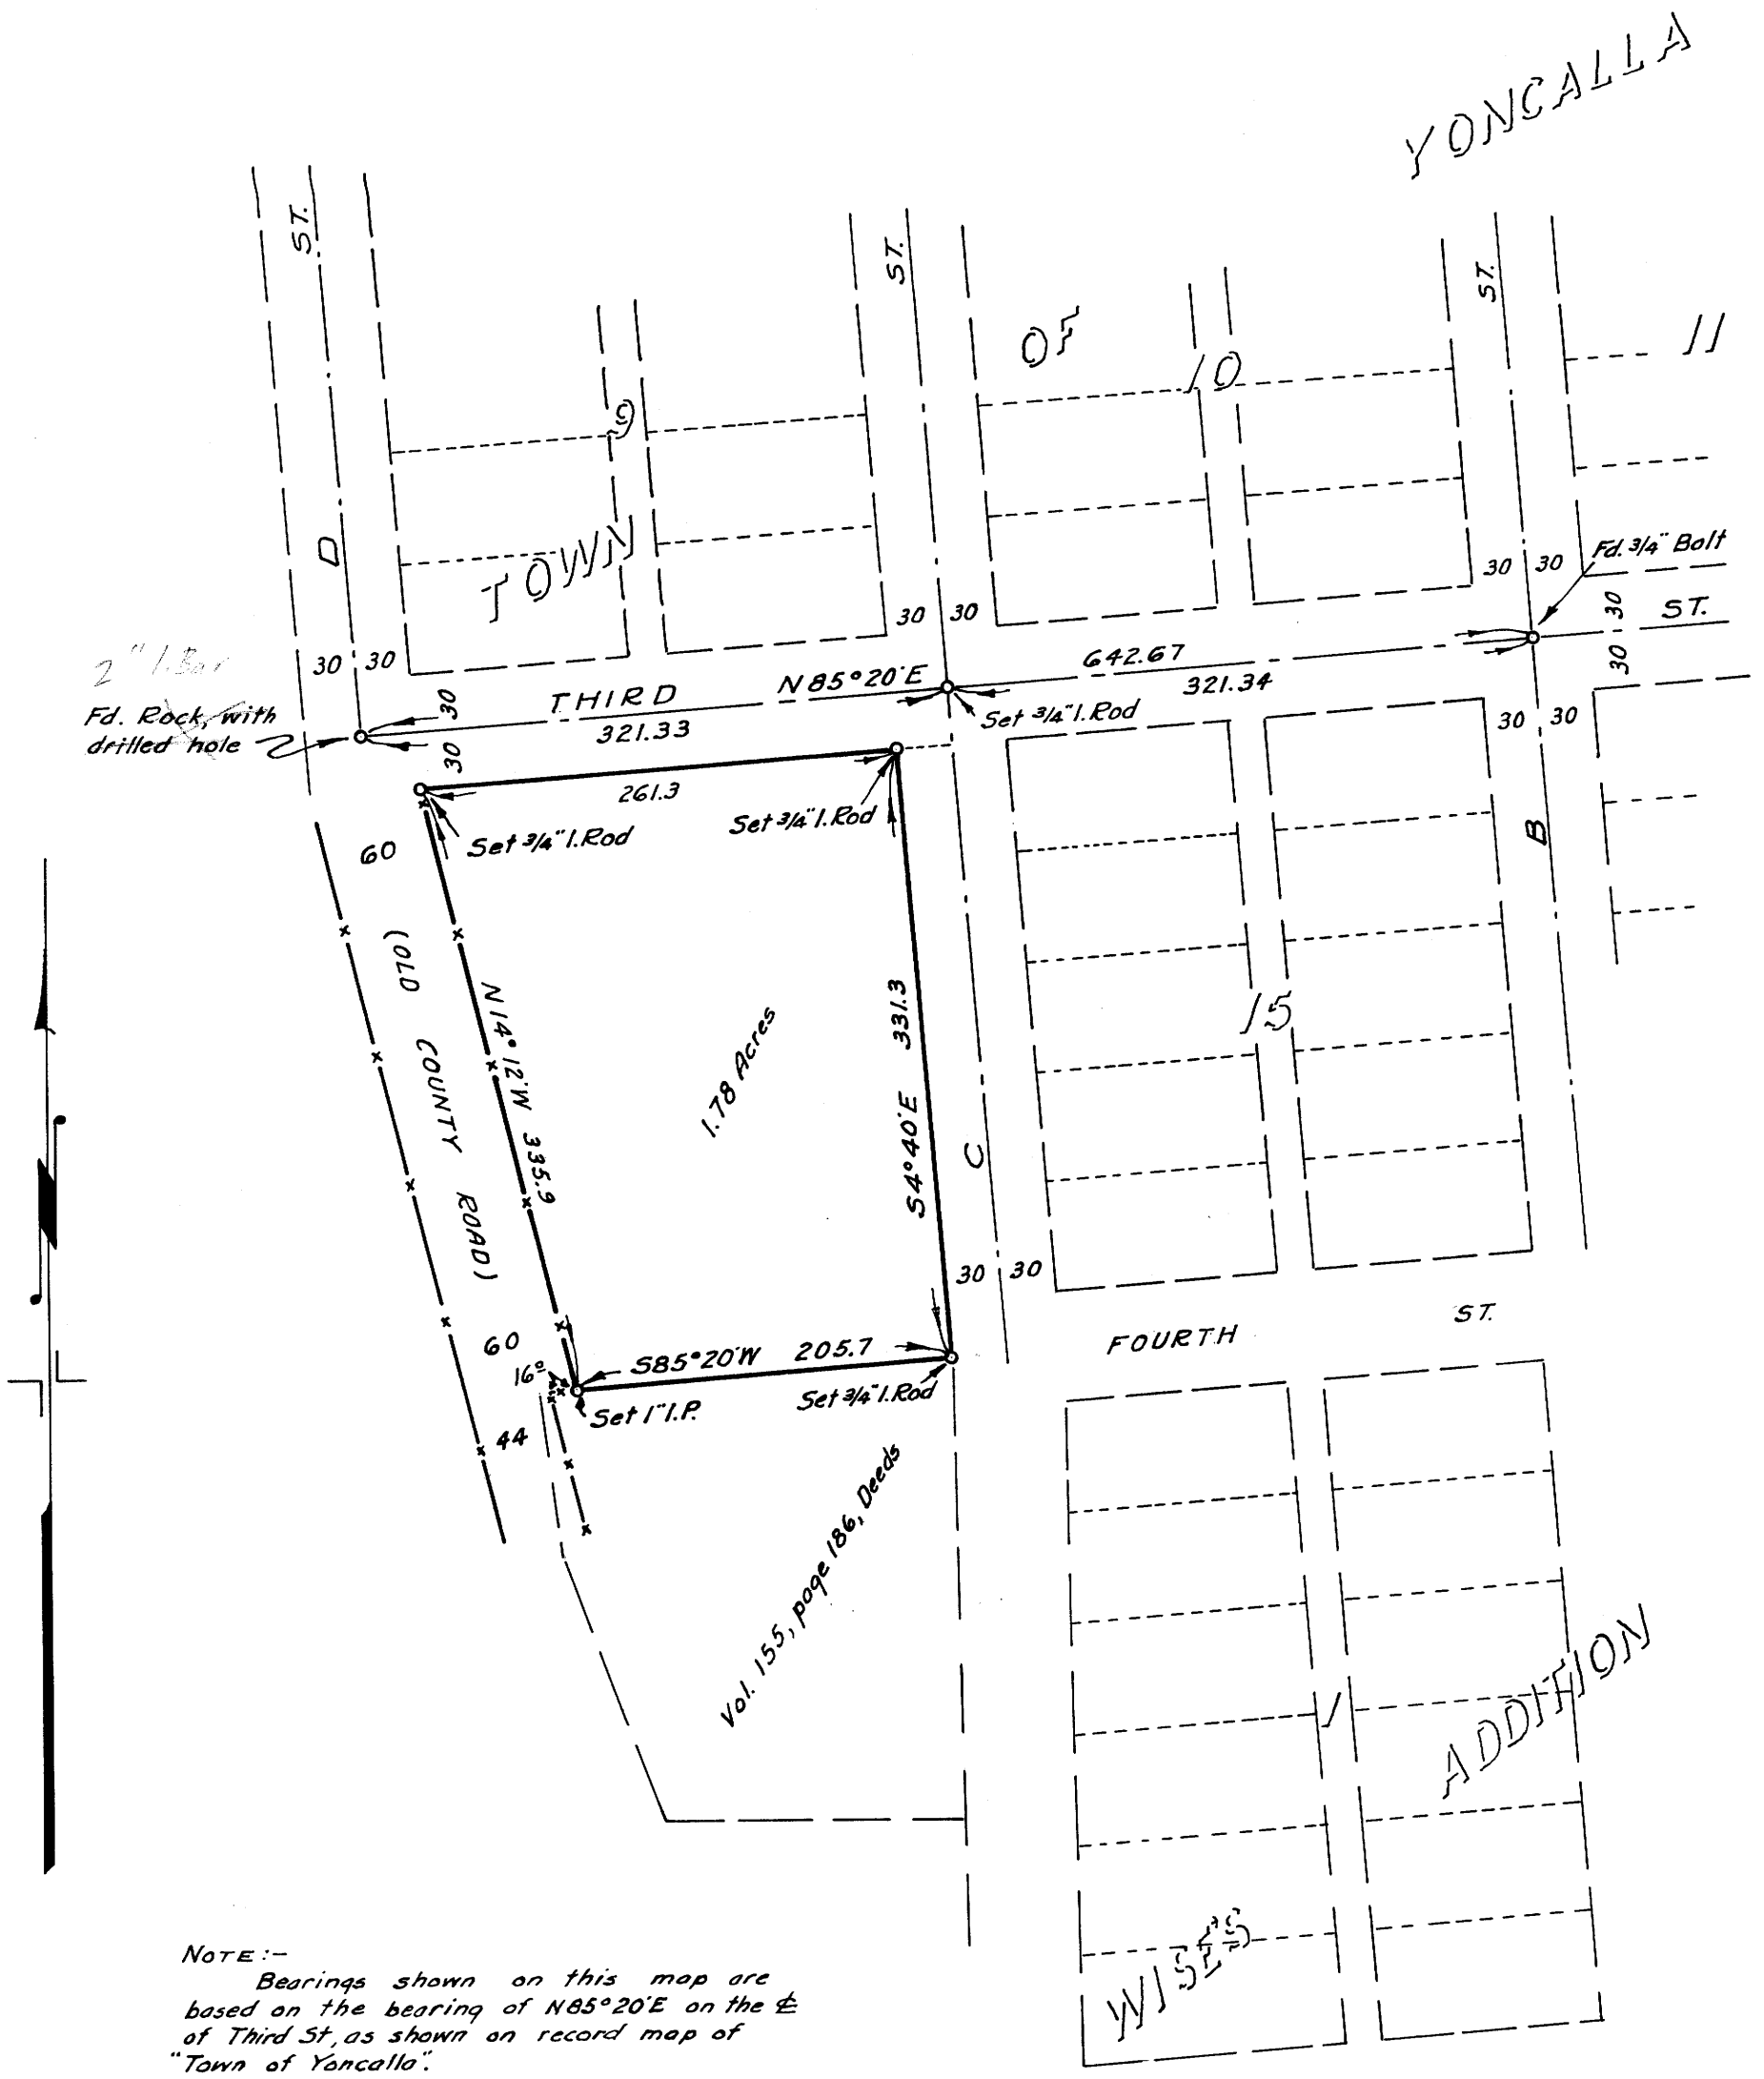

NOTE:-
Bearings shown on this map are based on the bearing of N85°20'E on the ℄ of Third St, as shown on record map of "Town of Yoncalla".

COUNTY SURVEYORS FILE DATA
DO NOT REMOVE FROM OFFICE

COUNTY SURVEYOR'S OFFICE DOUGLAS COUNTY, OREGON.

SURVEY FOR DEED DESCRIPTION, TOWN OF YONCALLA.

REGISTERED OREGON LAND SURVEYOR
N E Richardson
JULY 7. 1944
N. E. RICHARDSON
35

BEN. B. IRVING COUNTY SURVEYOR
SURVEYED JUNE 13,14, 1949 BY
N. E. RICHARDSON DEPUTY

SCALE 1" = 100'

M 14-64

FILE 103 DRAWER 43