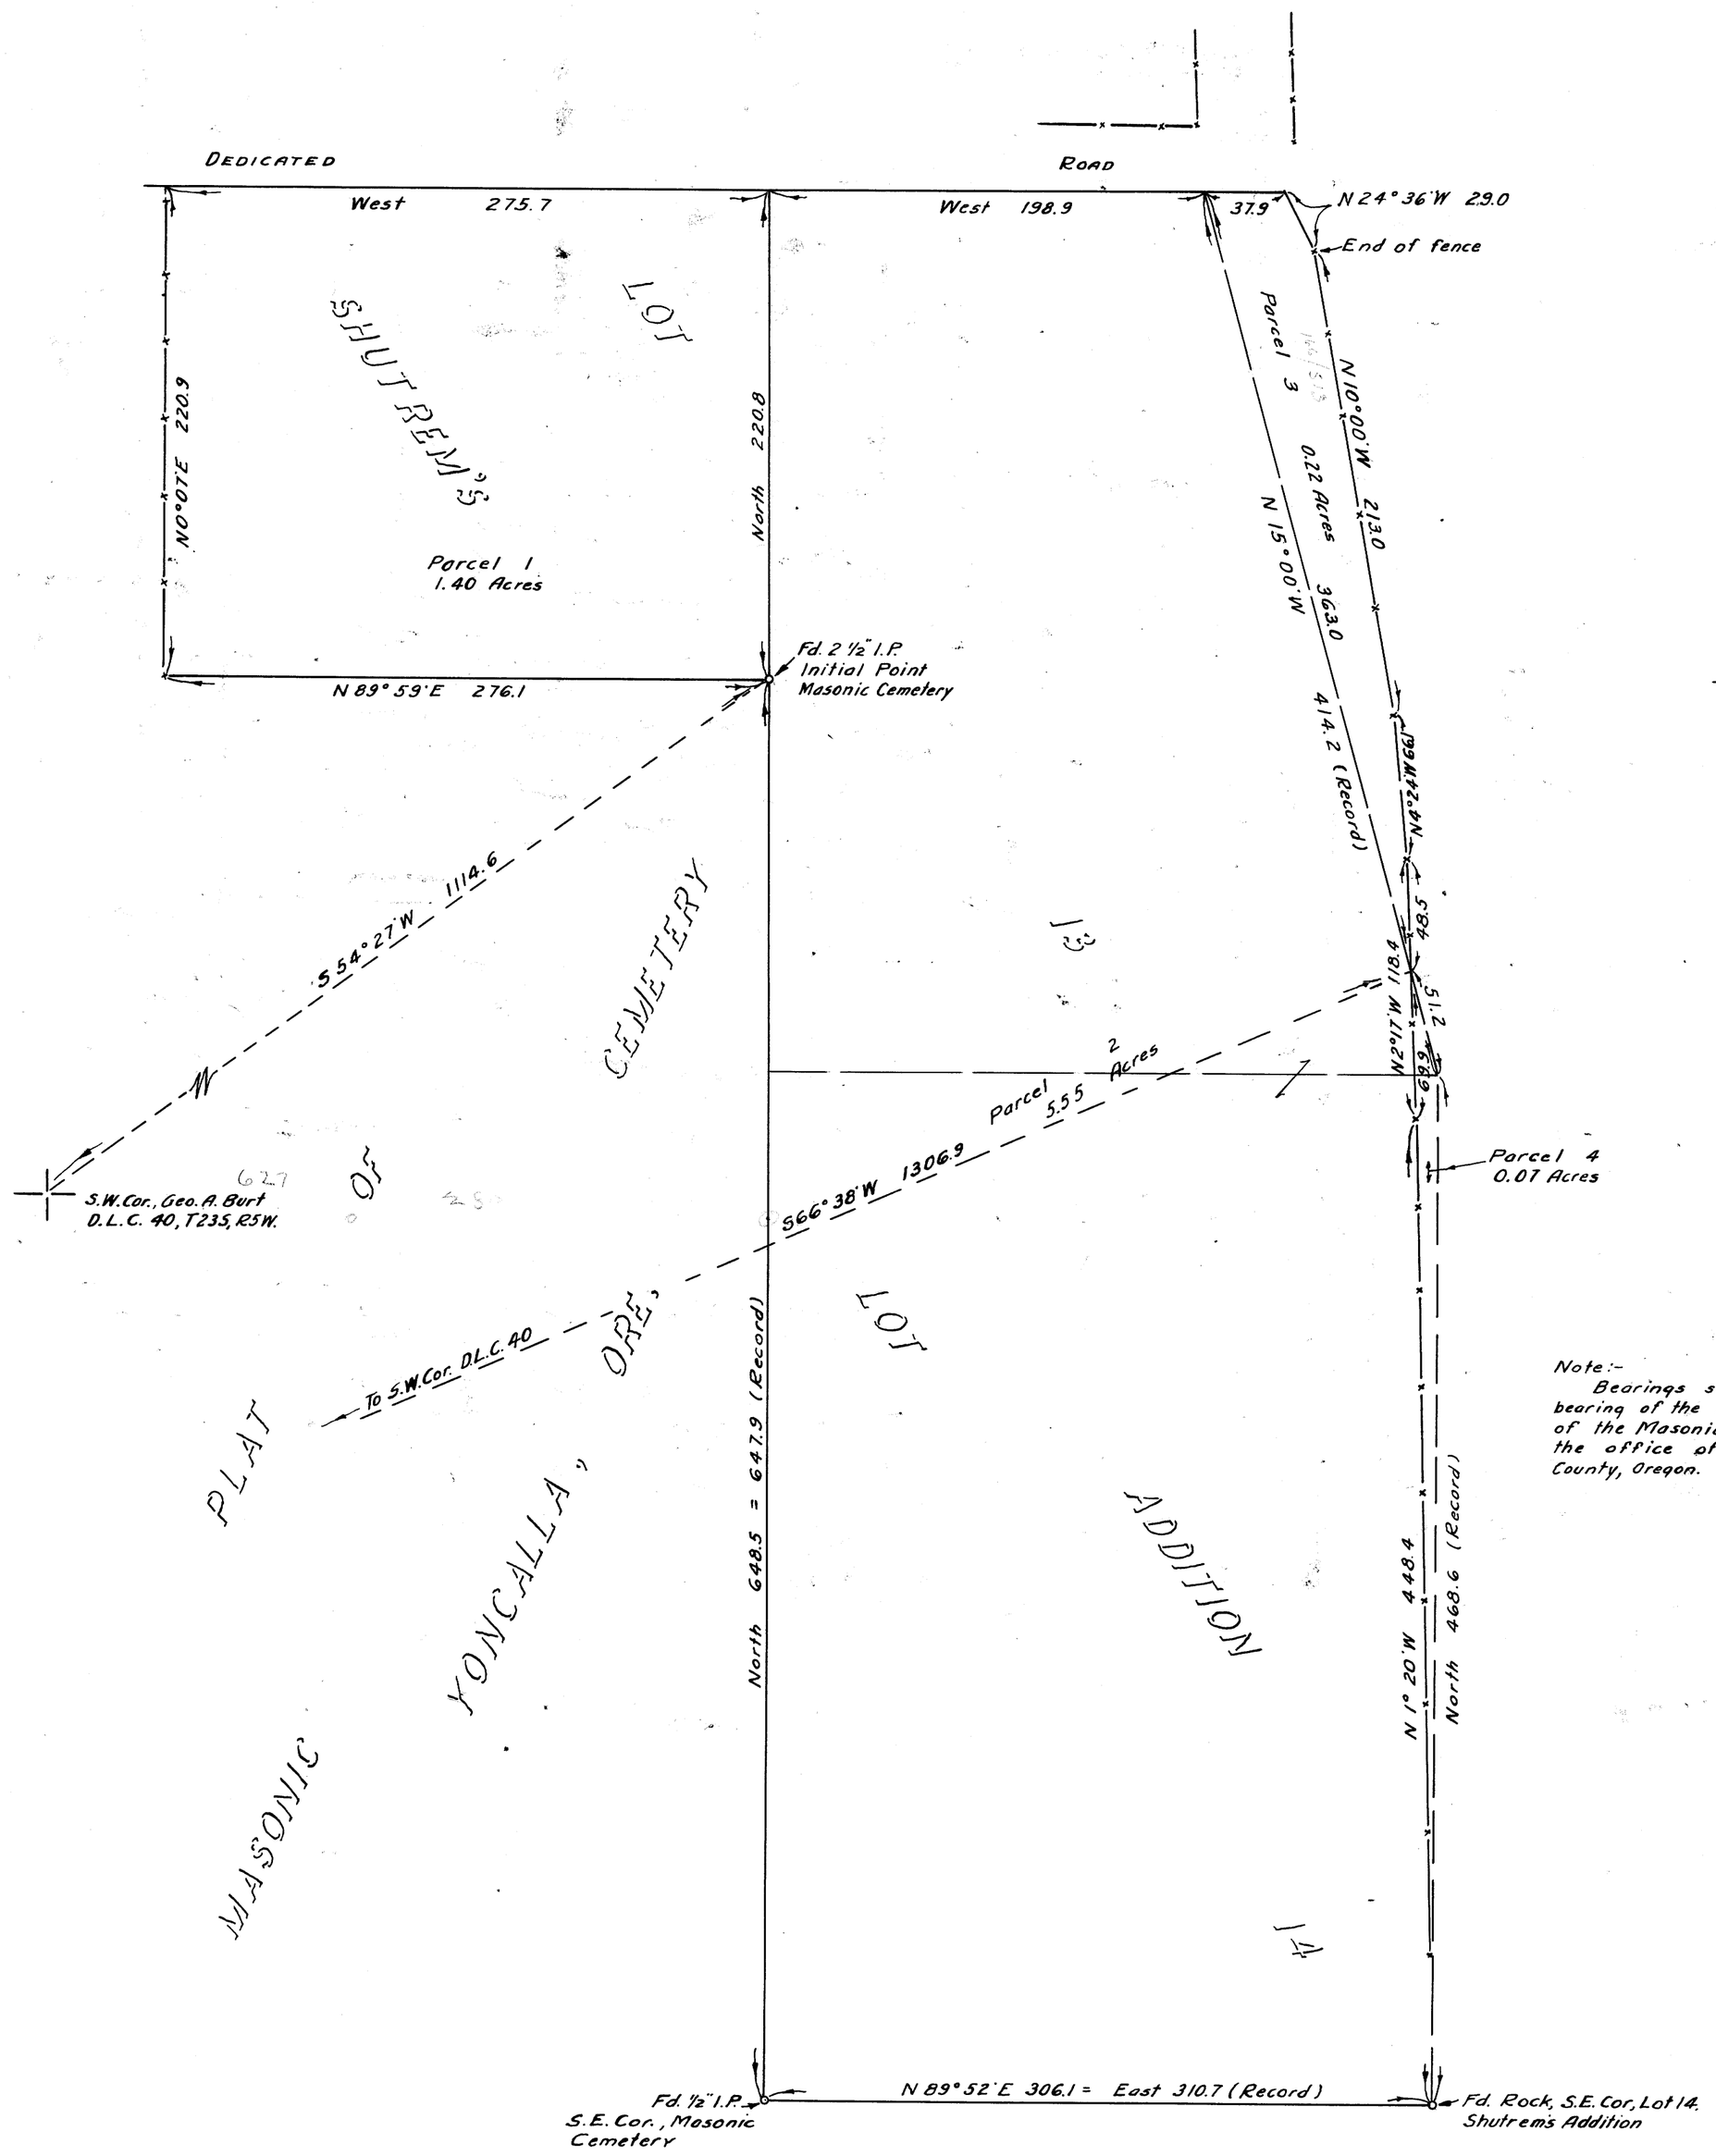

Note:-
Bearings shown are based on the bearing of the East line of the plat of the Masonic Cemetery, as filed in the office of the County Clerk, Douglas County, Oregon.

COUNTY SURVEYORS FILE DATA
DO NOT REMOVE FROM OFFICE

COUNTY SURVEYOR'S OFFICE
DOUGLAS COUNTY, OREGON.

SURVEY FOR DEED DESCRIPTIONS, SHUTREM'S ADDITION TO CITY OF YONCALLA.

REGISTERED PROFESSIONAL ENGINEER 2741 OREGON NOV. 7, 1947 ARTHUR R. EVANS

BEN. B. IRVING
SURVEYED MARCH 4, 1949
ARTHUR R. EVANS

COUNTY SURVEYOR
BY
DEPUTY

SCALE 1" = 60'

T. 23-5 Sec. 4 NE SE 1/4 SE SE 1/4

M 14-67

FILE 80 DRAWER 43