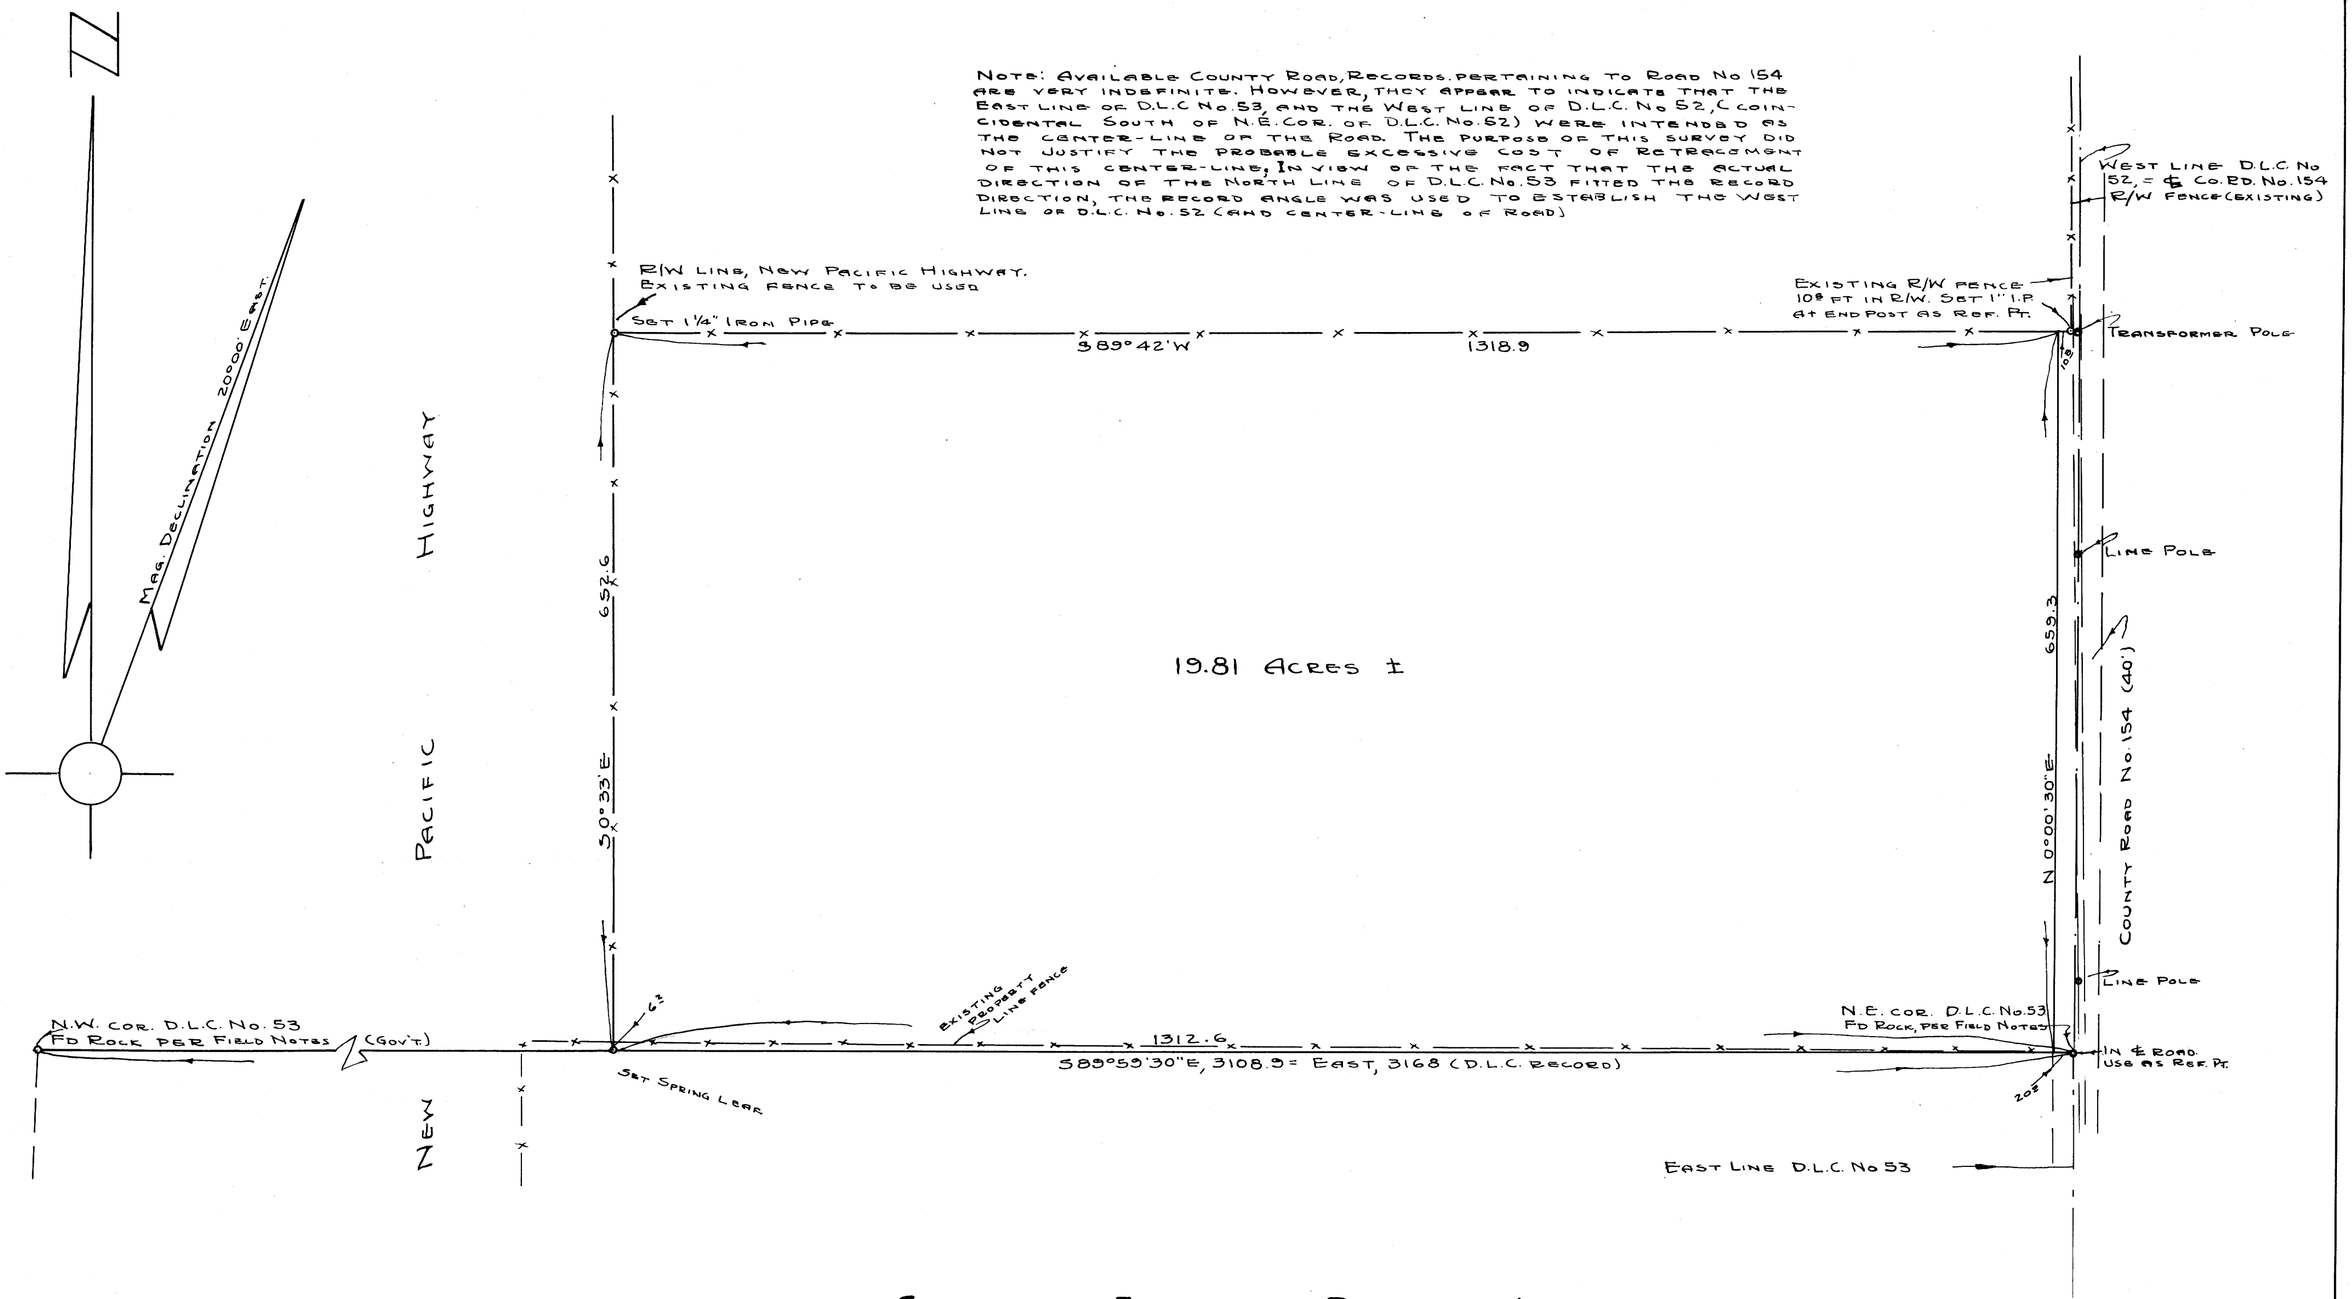

SURVEY TO ESTABLISH PROPERTY LINES
SUTHERLIN SCHOOL DISTRICT
LOT 2, SECTION 18, T25S., R5W., W. M.

REGISTERED PROFESSIONAL ENGINEER
U.S.A.
Arthur R. Evans
OREGON
NOV. 9, 1949
ARTHUR R. EVANS

GRANT AND EVANS ENGINEERS
ROSEBURG OREGON
SURVEYED JAN. 1953 — SCALE 1" = 100'

COUNTY SURVEYORS FILE DATA
DO NOT REMOVE FROM FILE

41-109

C.S. File 41-109
Map File M 141-80