FILED
RECEIVED
JUN 9 1959
COUNTY SURVEYOR
DOUGLAS COUNTY, ORE.

SURVEY TO SET PROPERTY CORNERS BLOCK 77, FOURTH SECTION OF THE SOUTHERN ADDITION TO ROSEBURG, ORE.

SURVEYED FOR: JOHN NAPIER — SCALE: 1" = 50'

SURVEYED BY: G. R. LECKLIDER - ENG'R. — JUNE, 1959

COUNTY SURVEYORS FILE DATA
DO NOT REMOVE FROM OFFICE

● DENOTES 1/2" IRON RODS SET

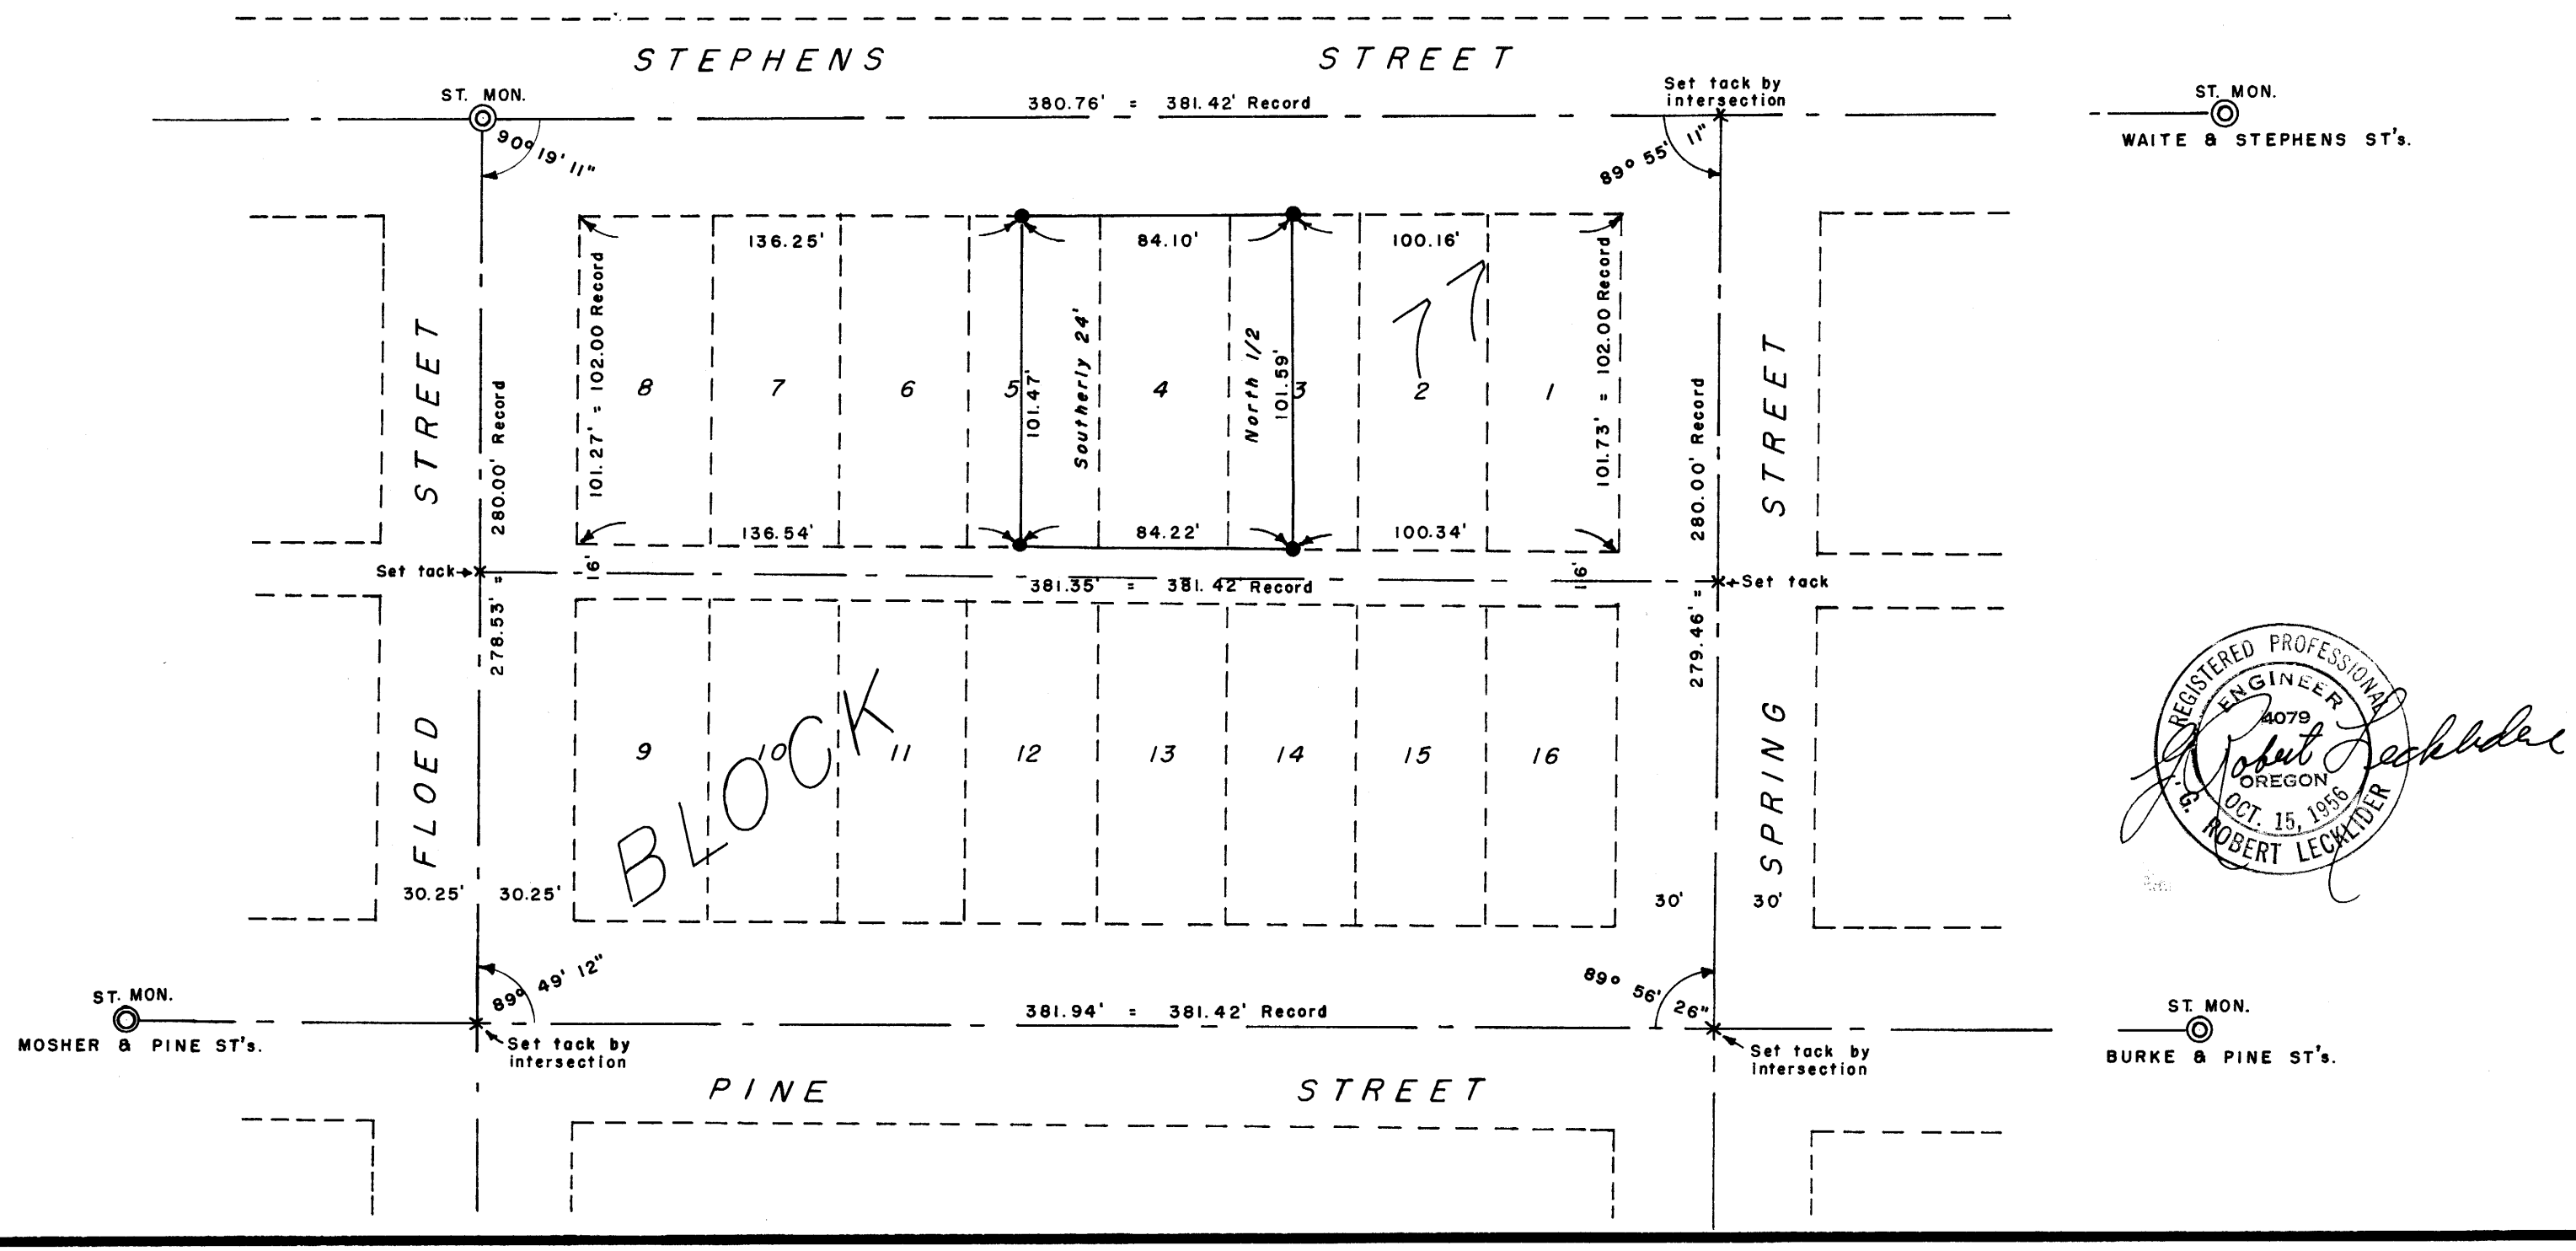

REGISTERED PROFESSIONAL ENGINEER 4079 OREGON OCT. 15, 1956 G. ROBERT LECKLIDER

MAP FILE M 15-13
M 15-13