COUNTY SURVEYORS FILE
DO NOT REMOVE FROM OFFICE

COUNTY SURVEYOR'S OFFICE
DOUGLAS COUNTY, OREGON

Survey of South End of Section 31
T. 30 S., R. 5 W. W.M.

Scale 1" = 400 ft. March 1946

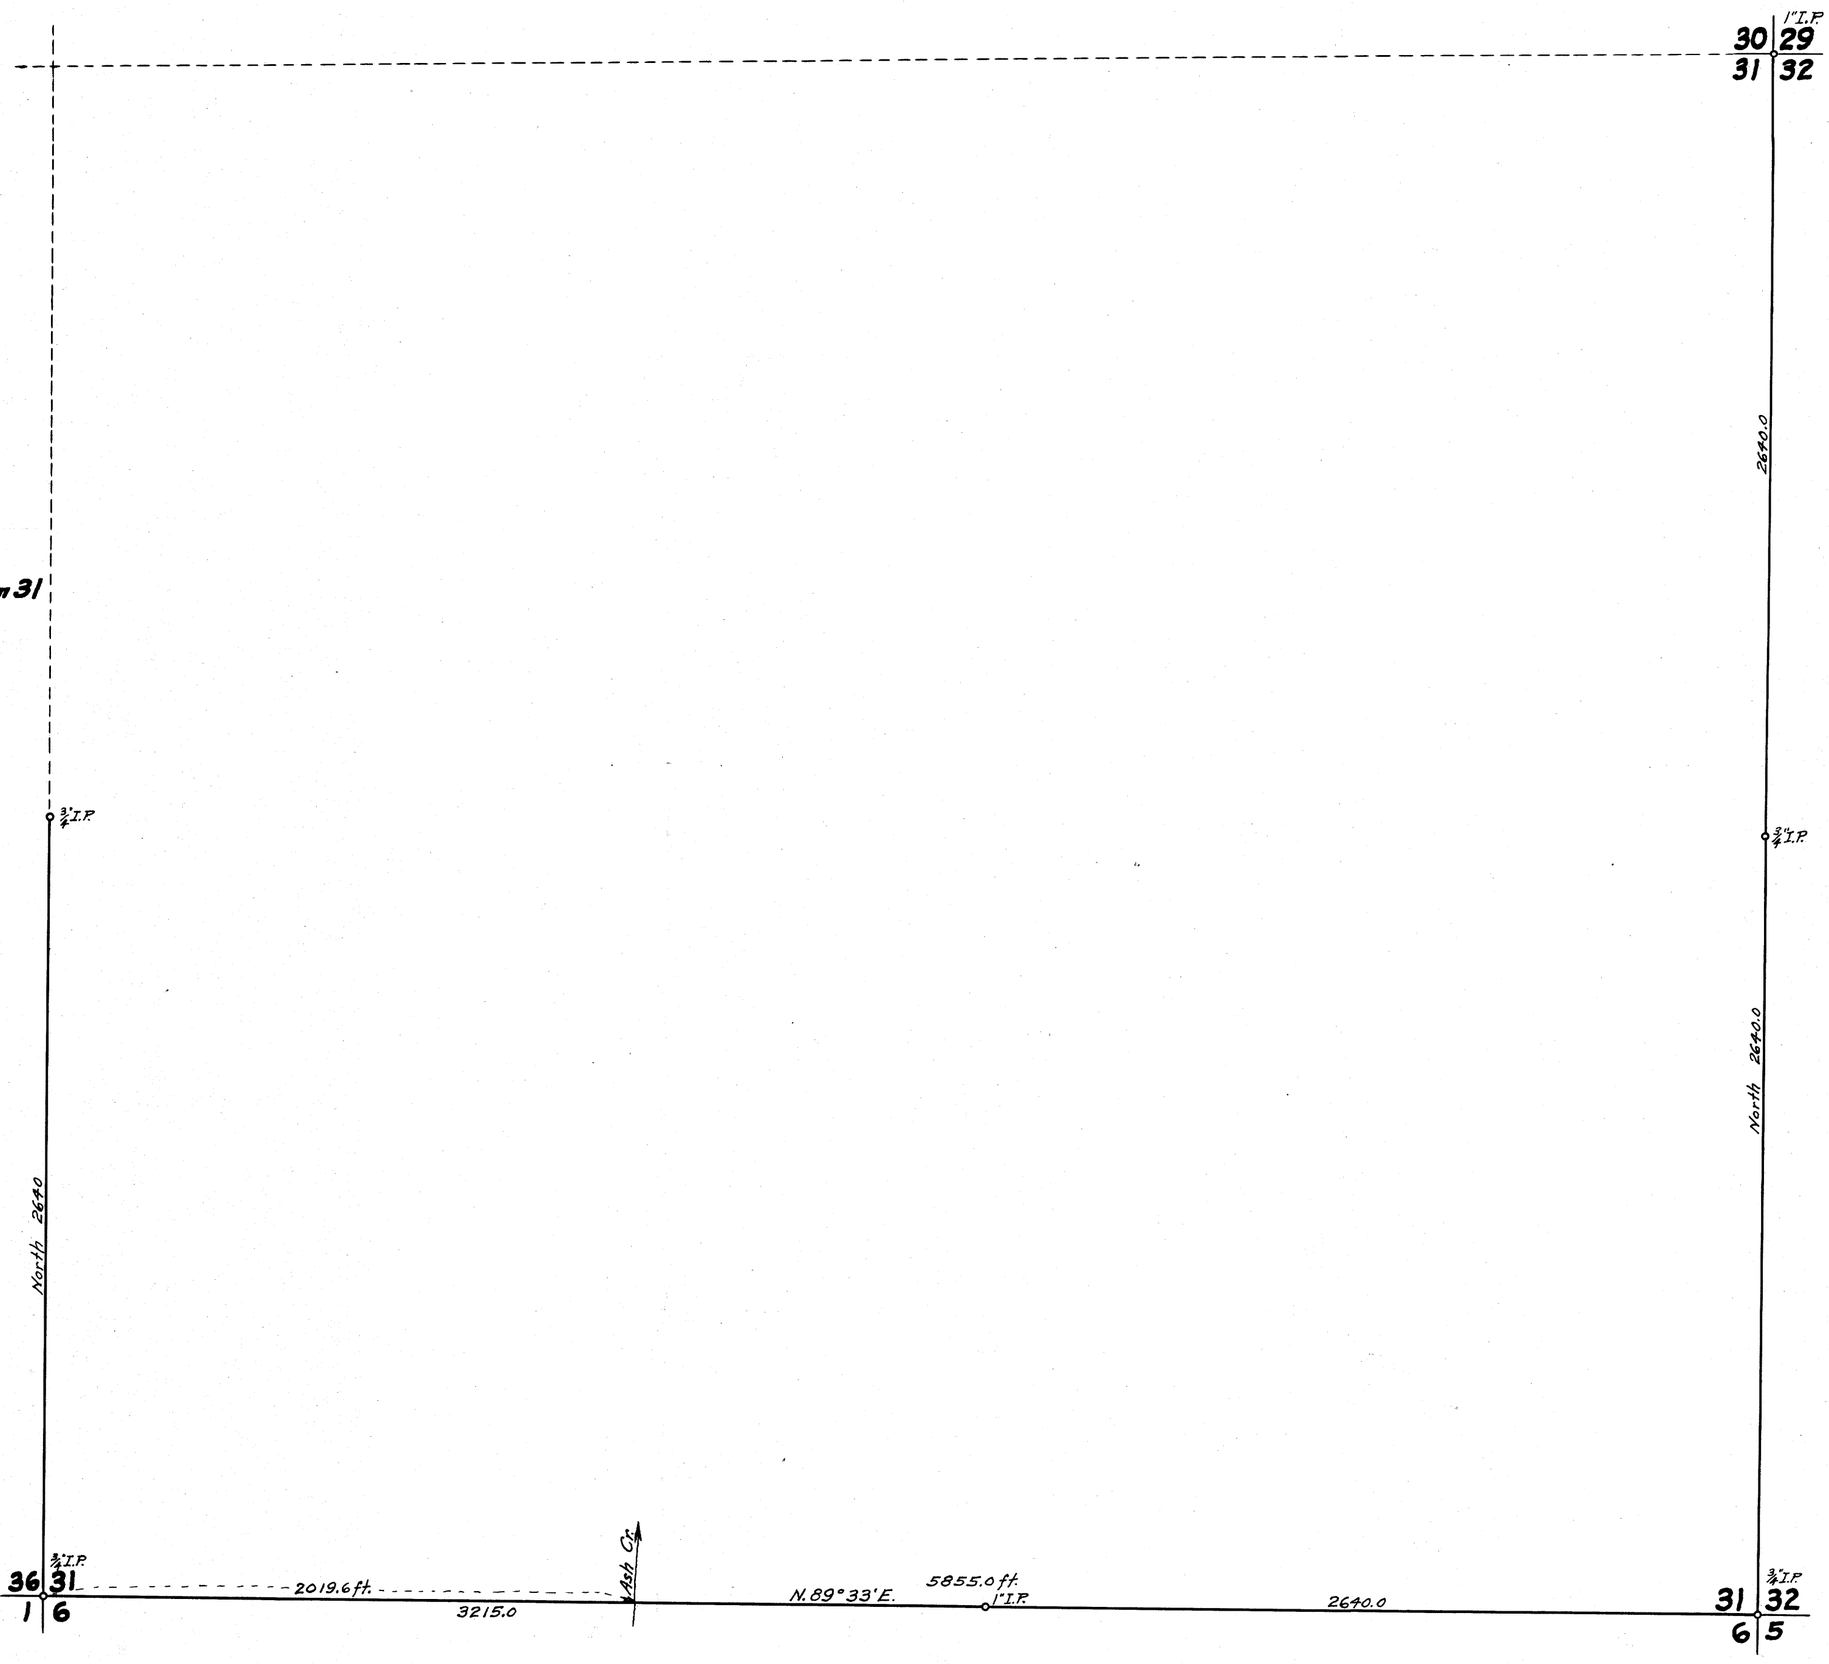

REGISTERED
OREGON
LAND SURVEYOR

Geo. J. Wenderoth

MAP FILE M-15-16
C.S. File 39-1-118
Map File M-15-16