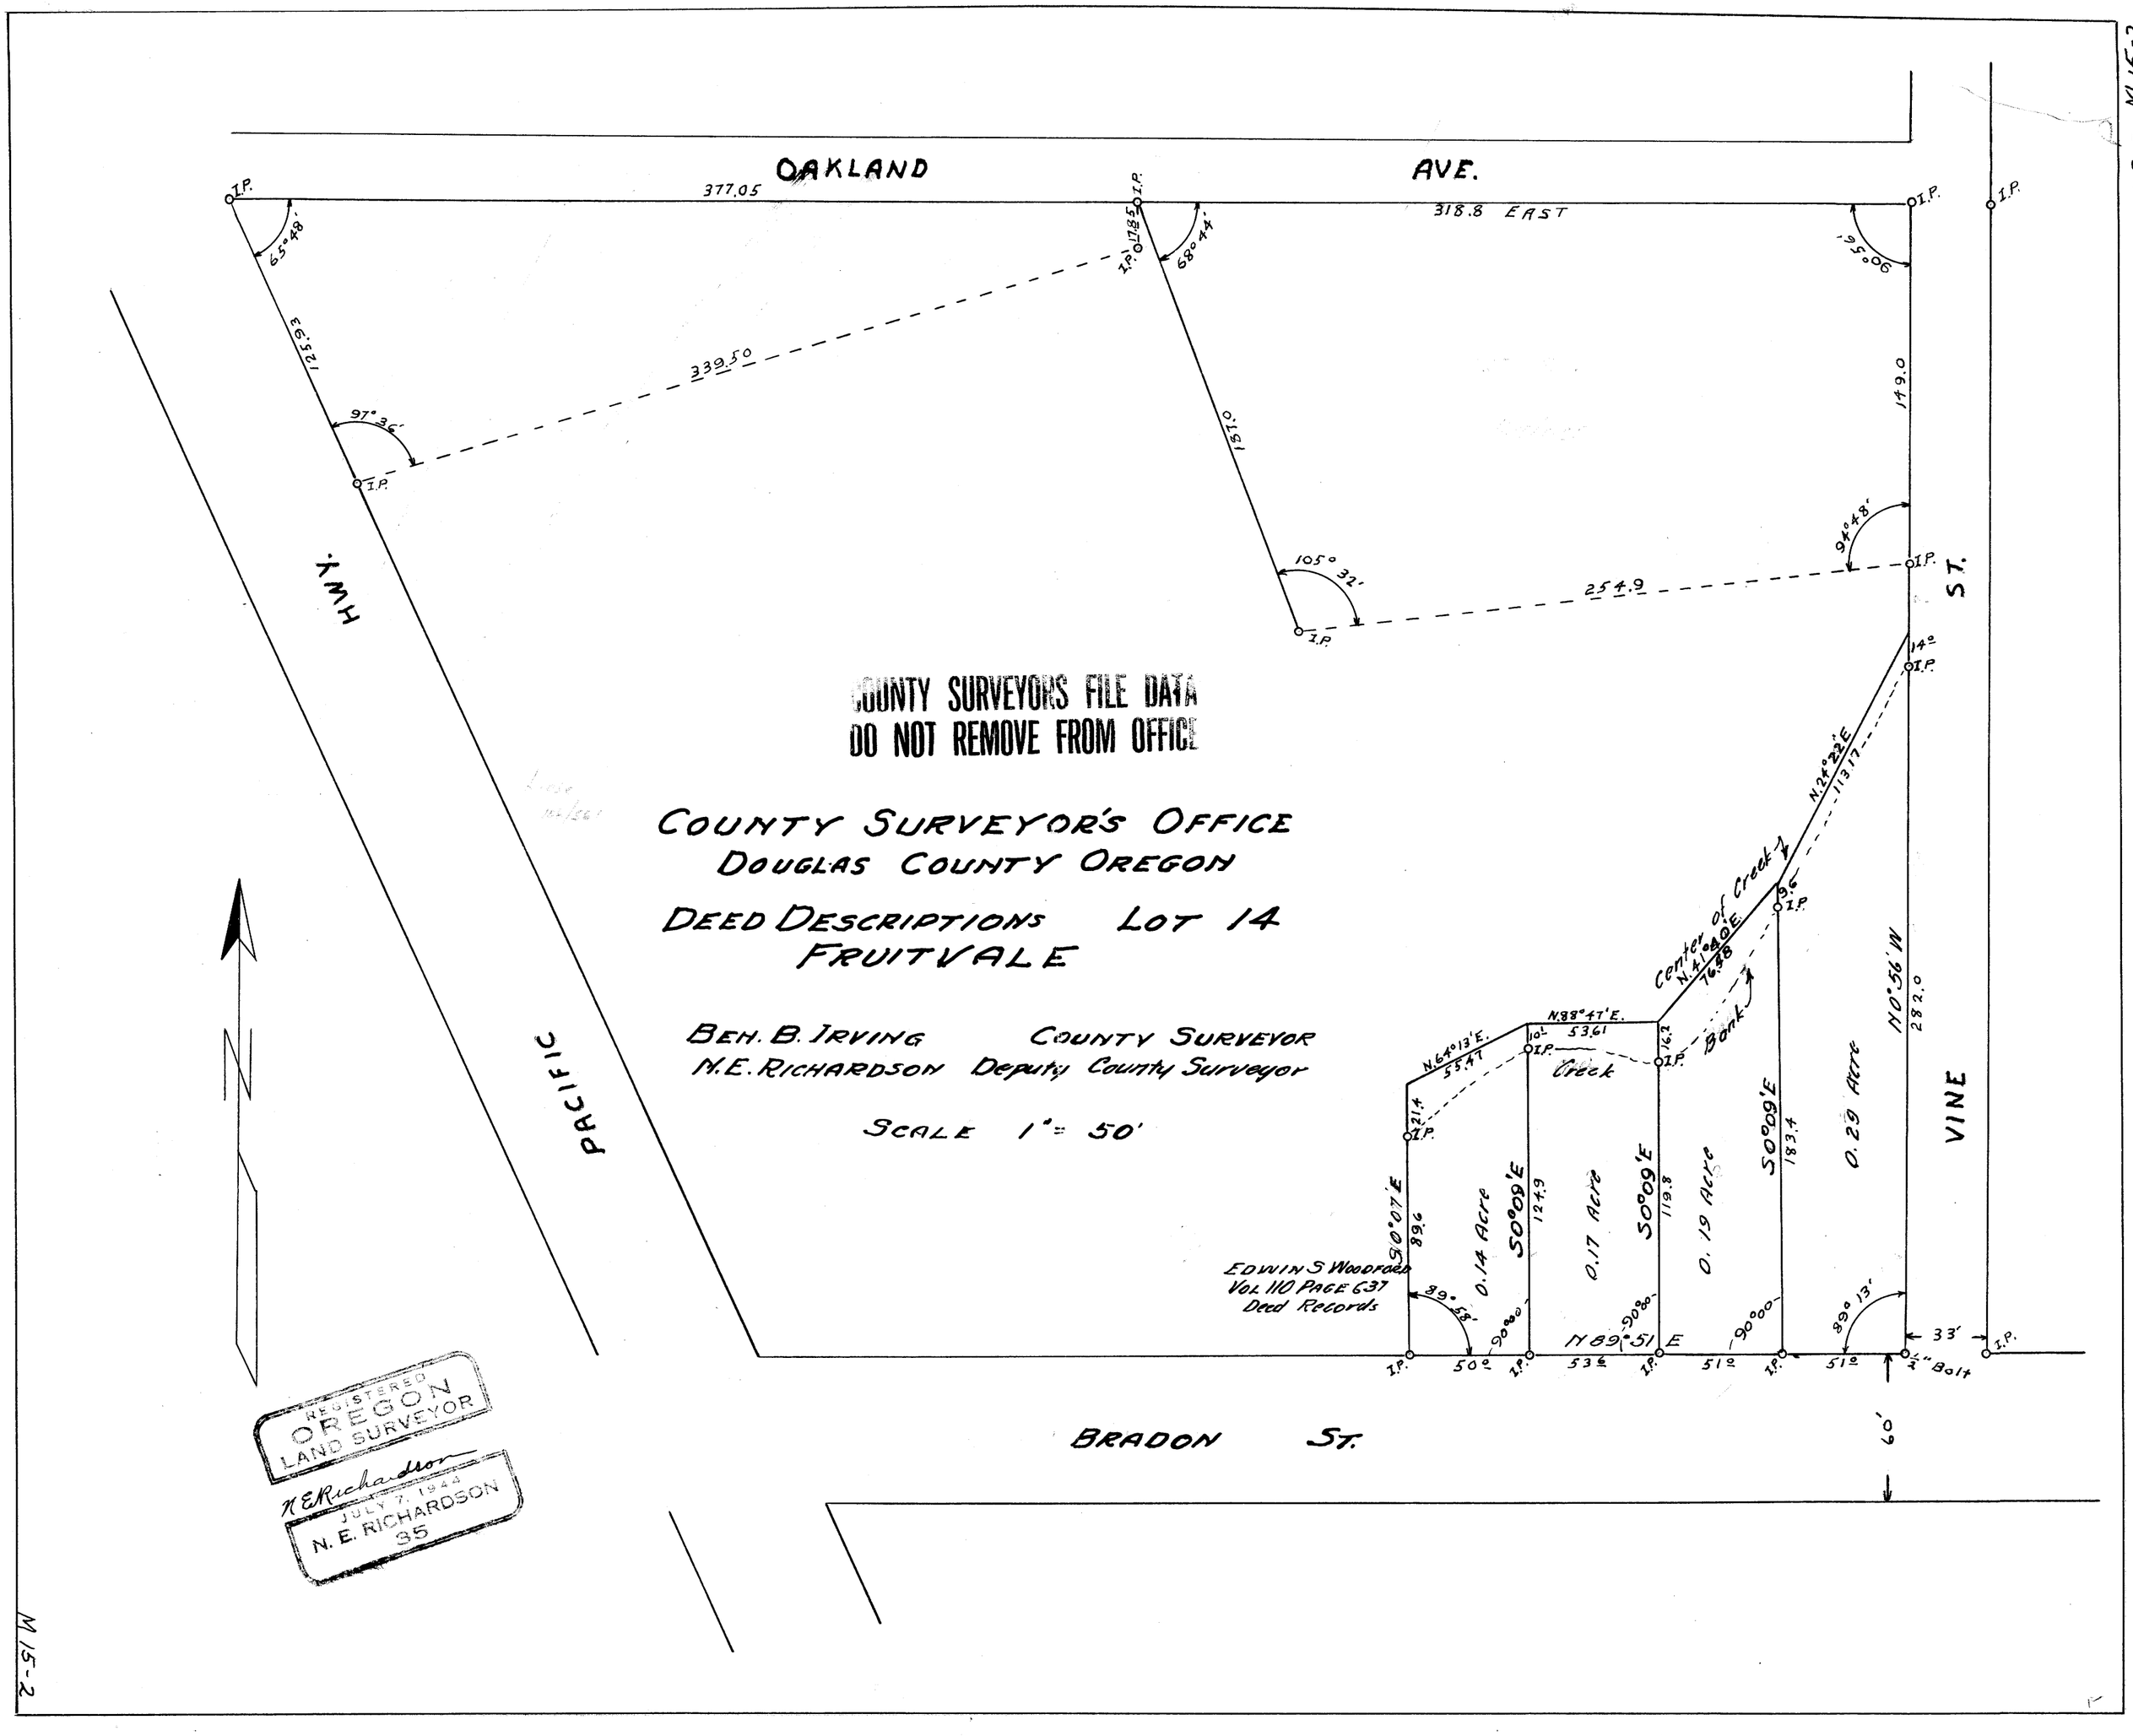

MAP FILE M 15-2

M 15-2

FILE 66 DRAWER 32