COUNTY SURVEYOR'S FILE COPY
DO NOT REMOVE FROM OFFICE

SURVEY TO ESTABLISH PROPERTY CORNERS OF A PORTION OF LOT 44, BALLF TRACTS (UN-RECORDED), IN SECTION 24, T. 27 S., R. 6 W., W. M.

SURVEYED FOR: A. S. LONG — JUNE, 1959

SURVEYED BY: G. R. LECKLIDER - ENGR. — SCALE: 1" = 40'

◎ DENOTES MONUMENT FOUND
○ DENOTES CORNER FOUND
● DENOTES 1/2" ROD SET

REGISTERED PROFESSIONAL ENGINEER
OREGON
JULY 15, 1959
ROBERT LECKLIDER

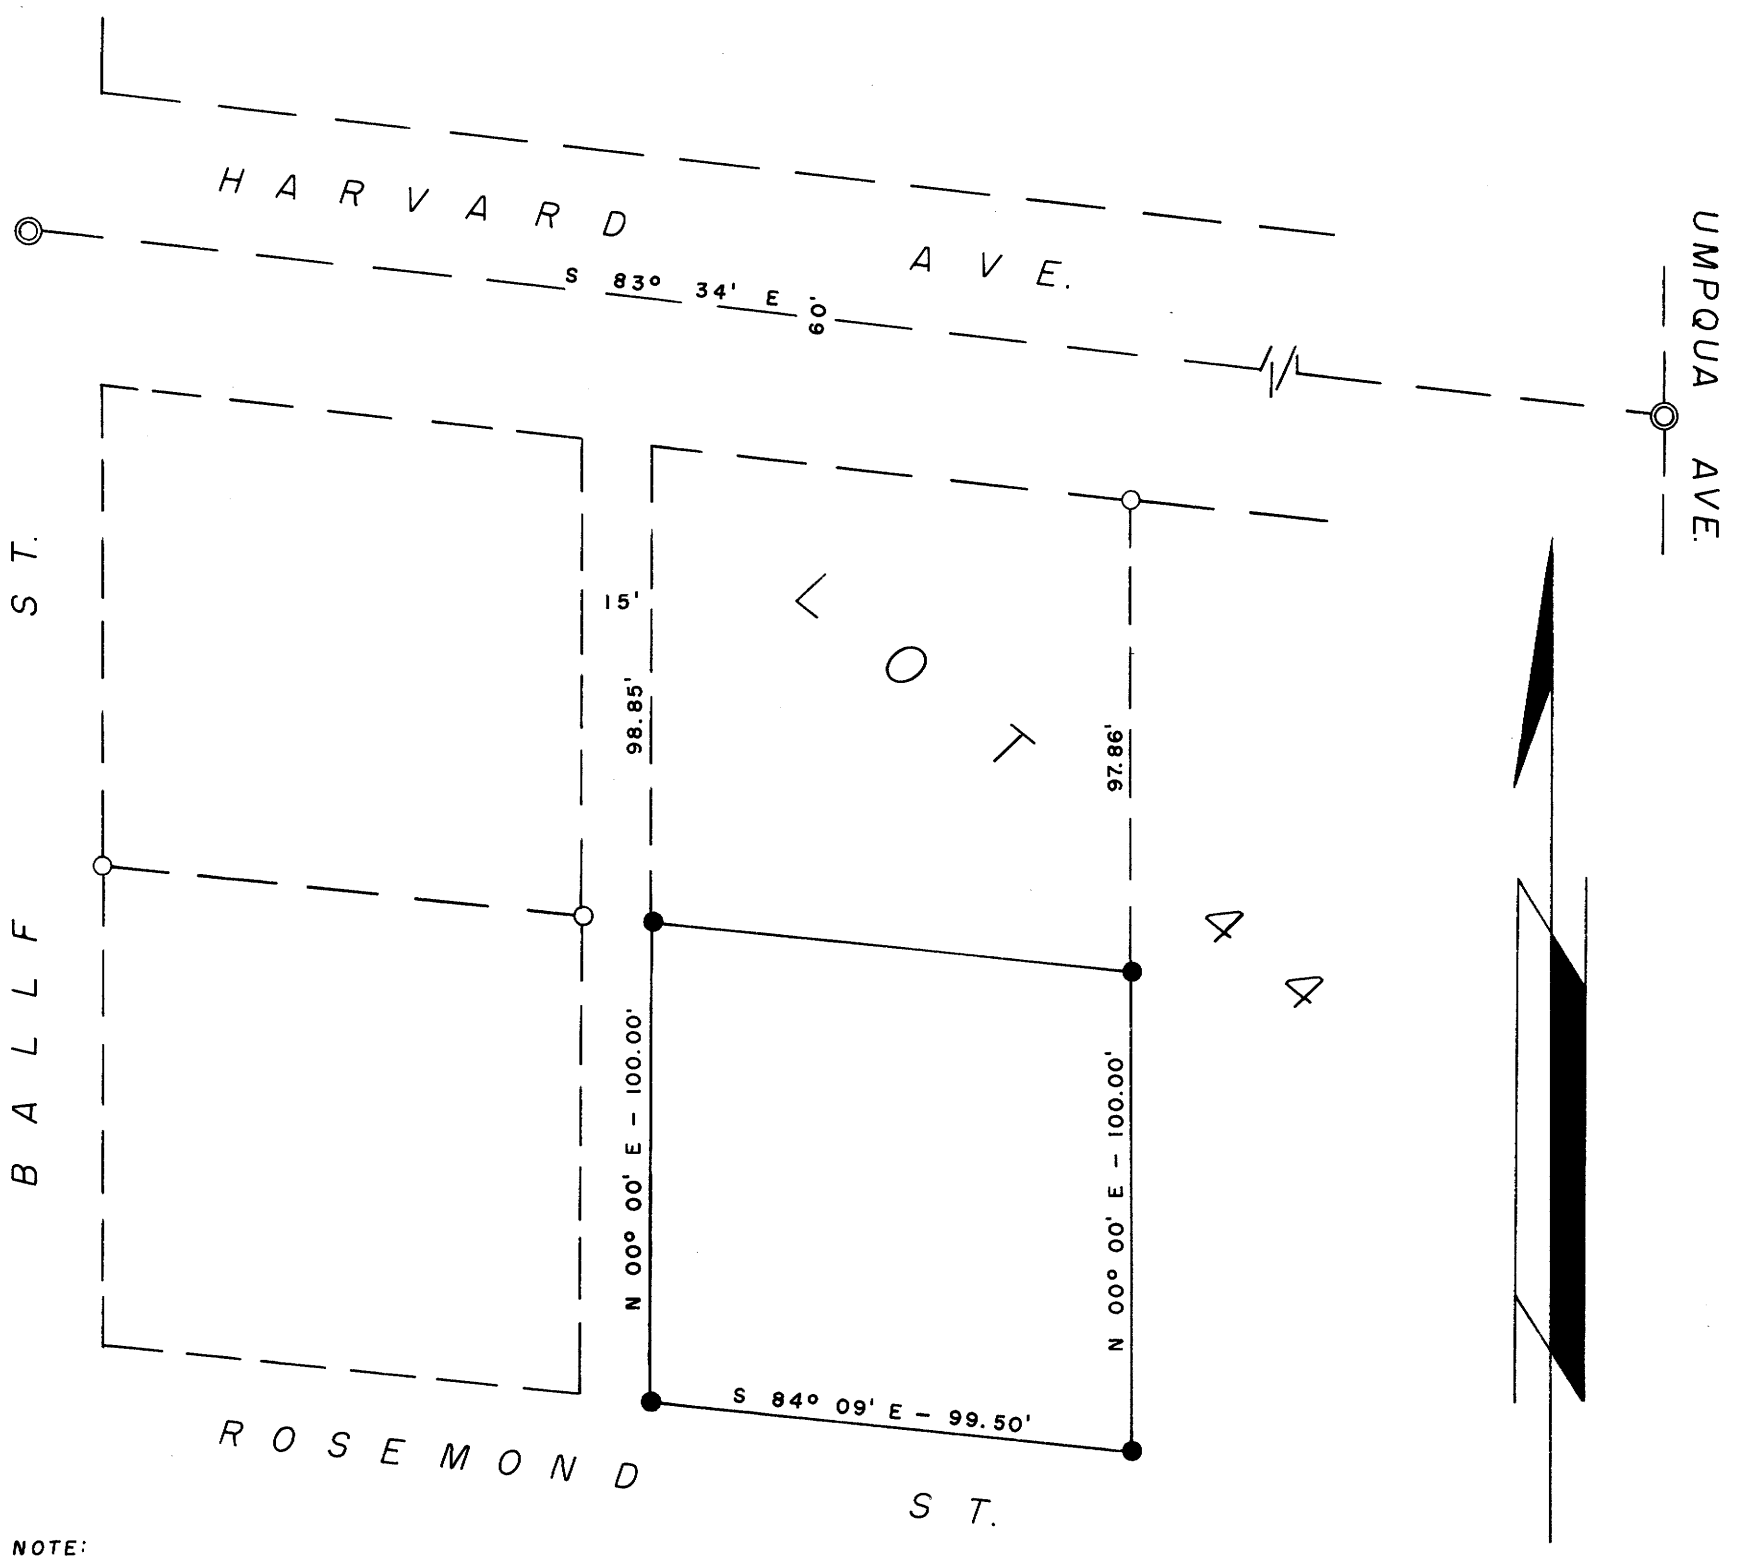

NOTE:
SURVEY BASED ON PRIOR SURVEY AS RECORDED IN C.S. FILE No. 45/116 IN THE RECORDS OF THE COUNTY SURVEYOR.

FILED L.L.
RECEIVED
JUL 23 1959
COUNTY SURVEYOR
DOUGLAS COUNTY ORE.

MAP FILE M 15-28