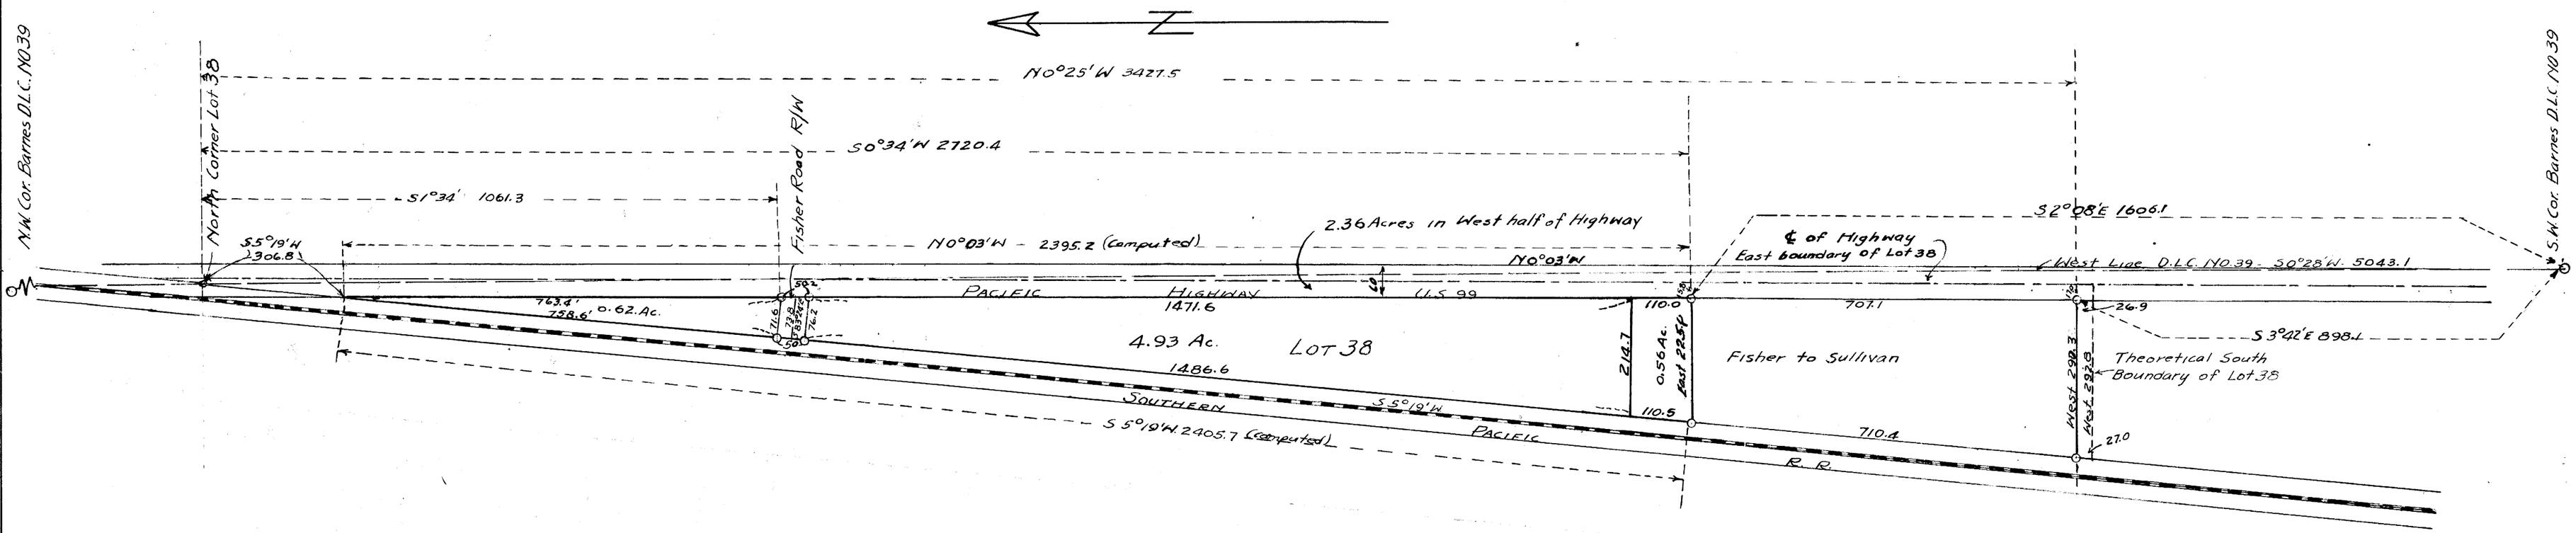

COUNTY SURVEYOR'S OFFICE
DOUGLAS COUNTY OREGON

LOT 38 EDENBONER ORCHARD TRACTS
SECTIONS 1-12, T27S., R6W., W.M.

BEN B. IRVING COUNTY SURVEYOR
SURVEYED NOVEMBER 25, 1946 BY
M.E. RICHARDSON DEPUTY
SCALE 1" = 200'

REGISTERED OREGON LAND SURVEYOR
M.E. Richardson
M.E. RICHARDSON
1946

COUNTY SURVEYORS FILE DATA
DO NOT REMOVE FROM OFFICE

Vol. 5 Pg. 3 (Index)
C.S. File 39/29
Map File N 16 + 2
C.S. 39/29 + Vol. 5 Pg. 3
MAP FILE N 16 - 2