M 16-20

MAP
OF
BLOCK-3 MOUNTAIN VIEW
SEC. 14 & 23 TP. 27S RG. 6W W.M.
SHOWING VEDER PROPERTY
OCT. 1952.

DO NOT REMOVE FROM OFF

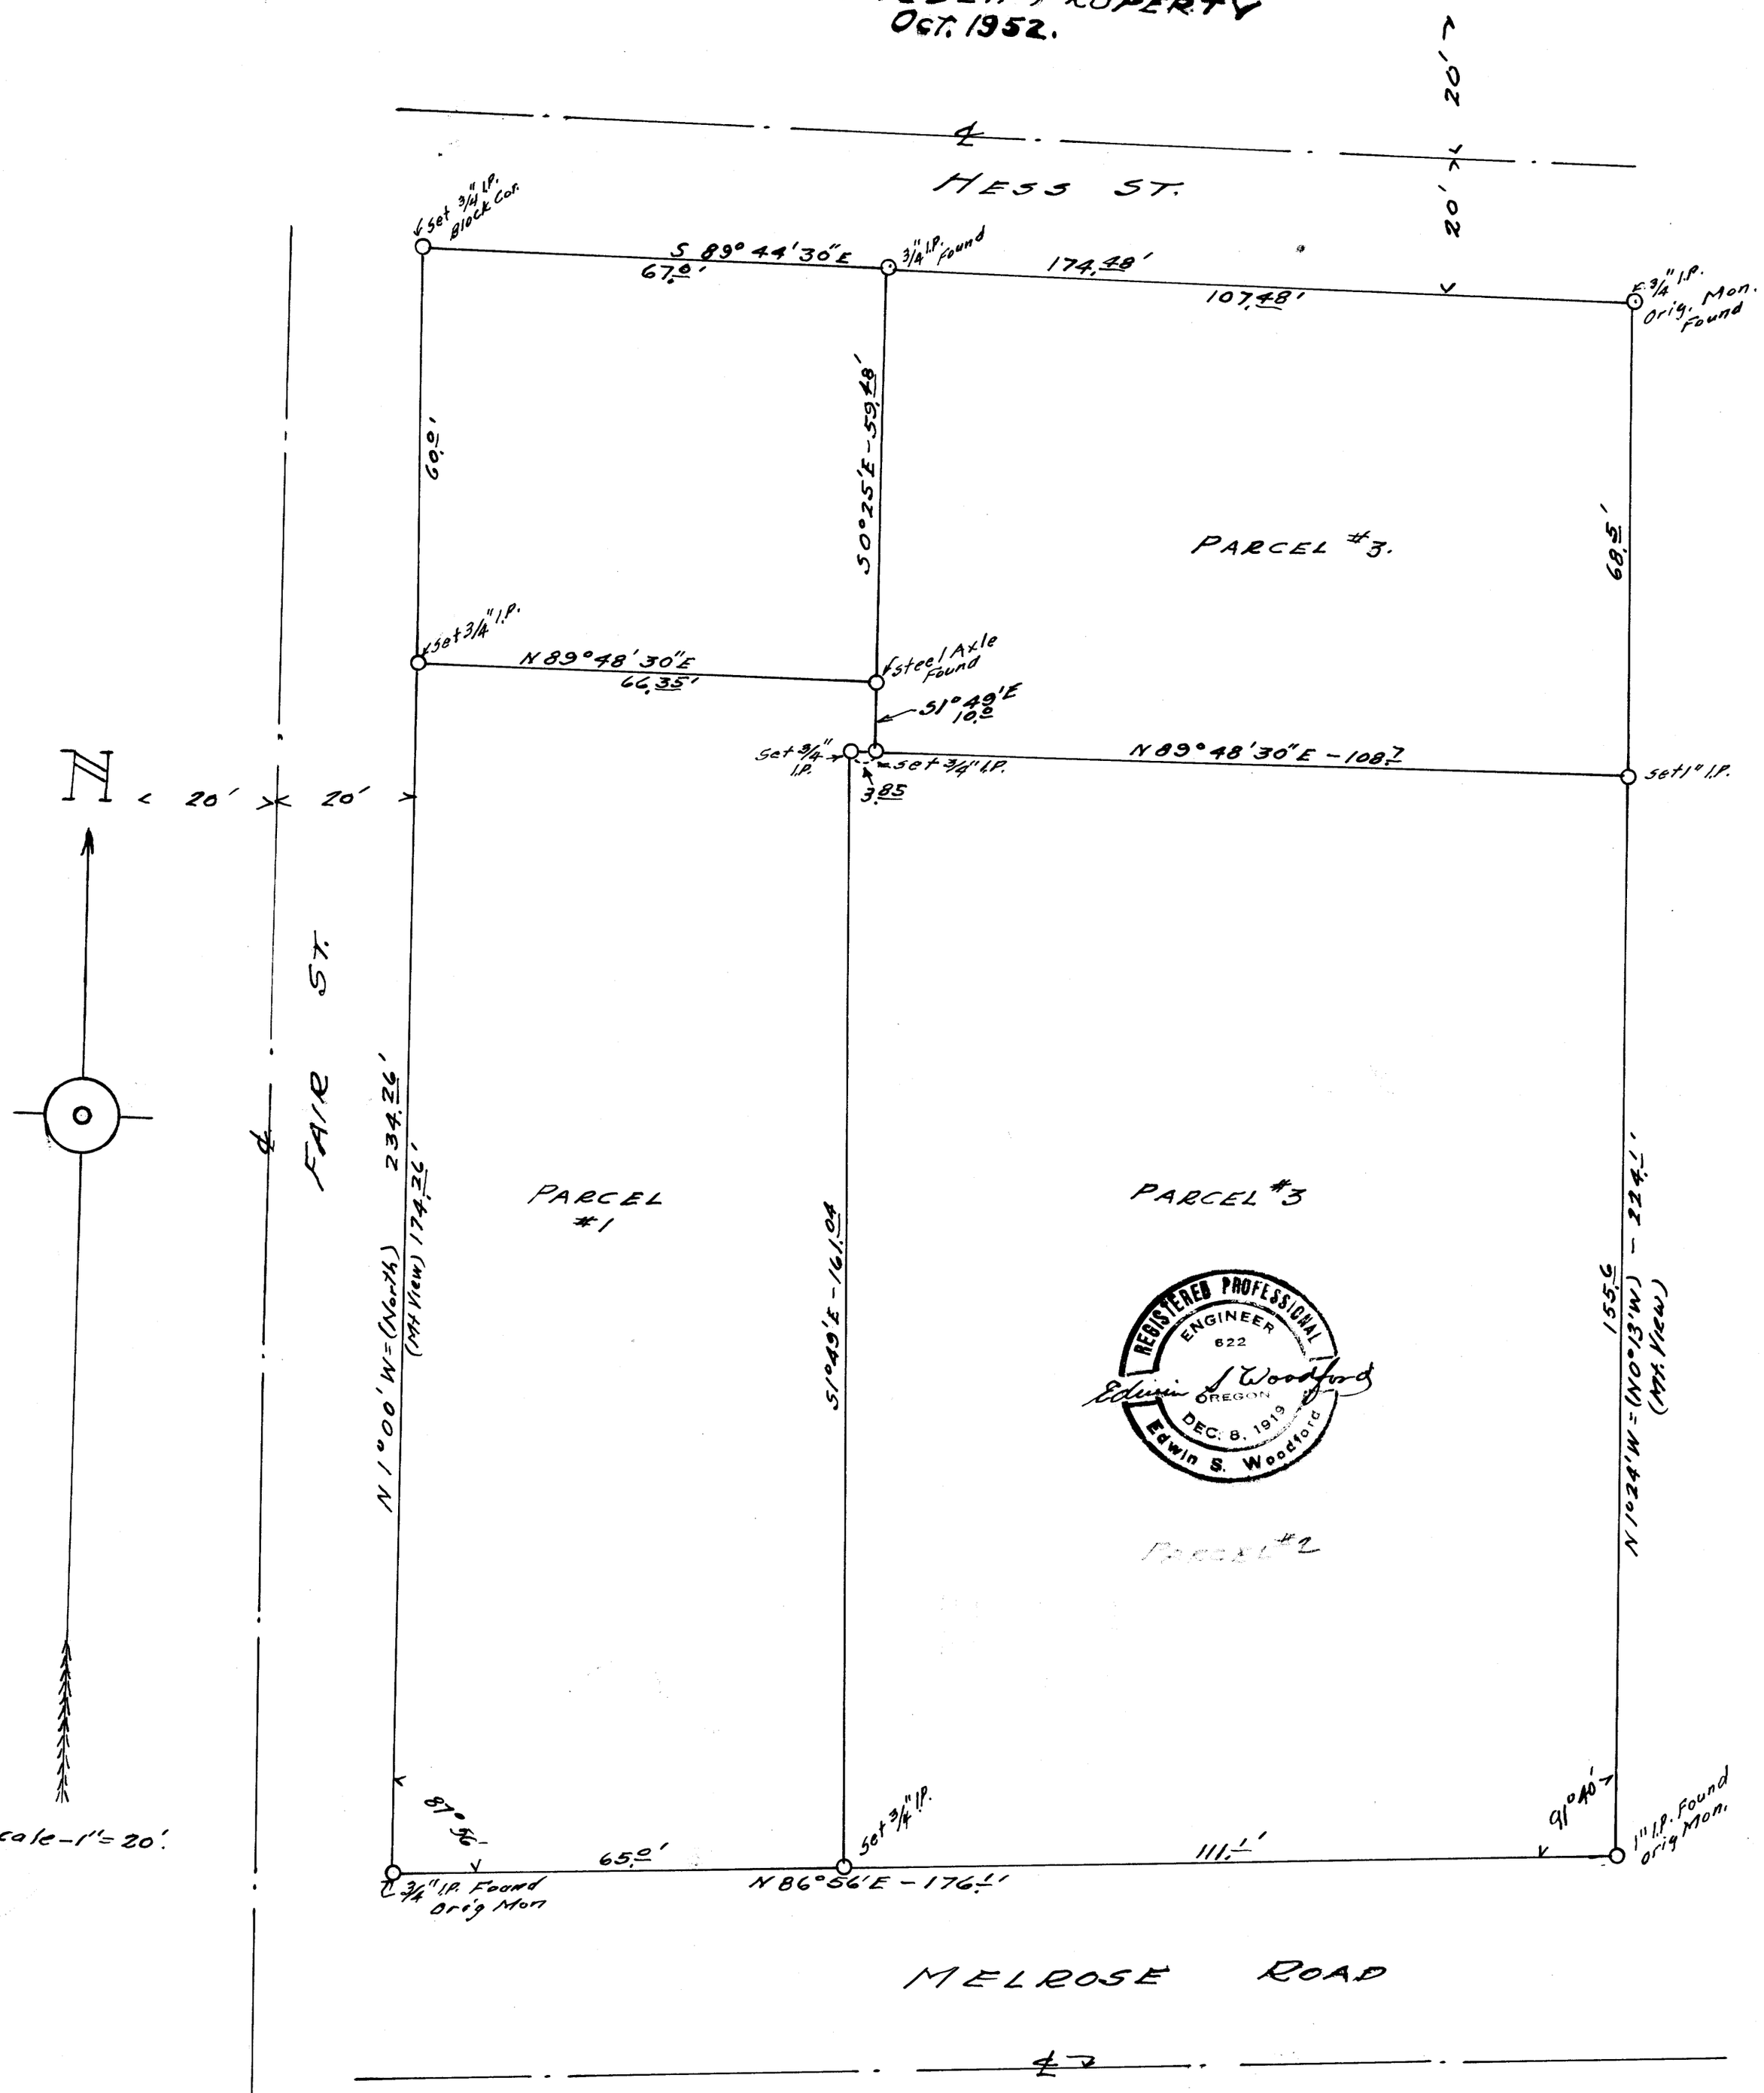

REGISTERED PROFESSIONAL ENGINEER 622 OREGON DEC. 8, 1919 Edwin S. Woodford

Edwin S. Woodford

PARCEL #2

FILED
RECEIVED
JAN 10 1956
COUNTY SURVEYOR
DOUGLAS COUNTY, ORE.

C. S. File No. 42/67

MAP FILE M 16-20