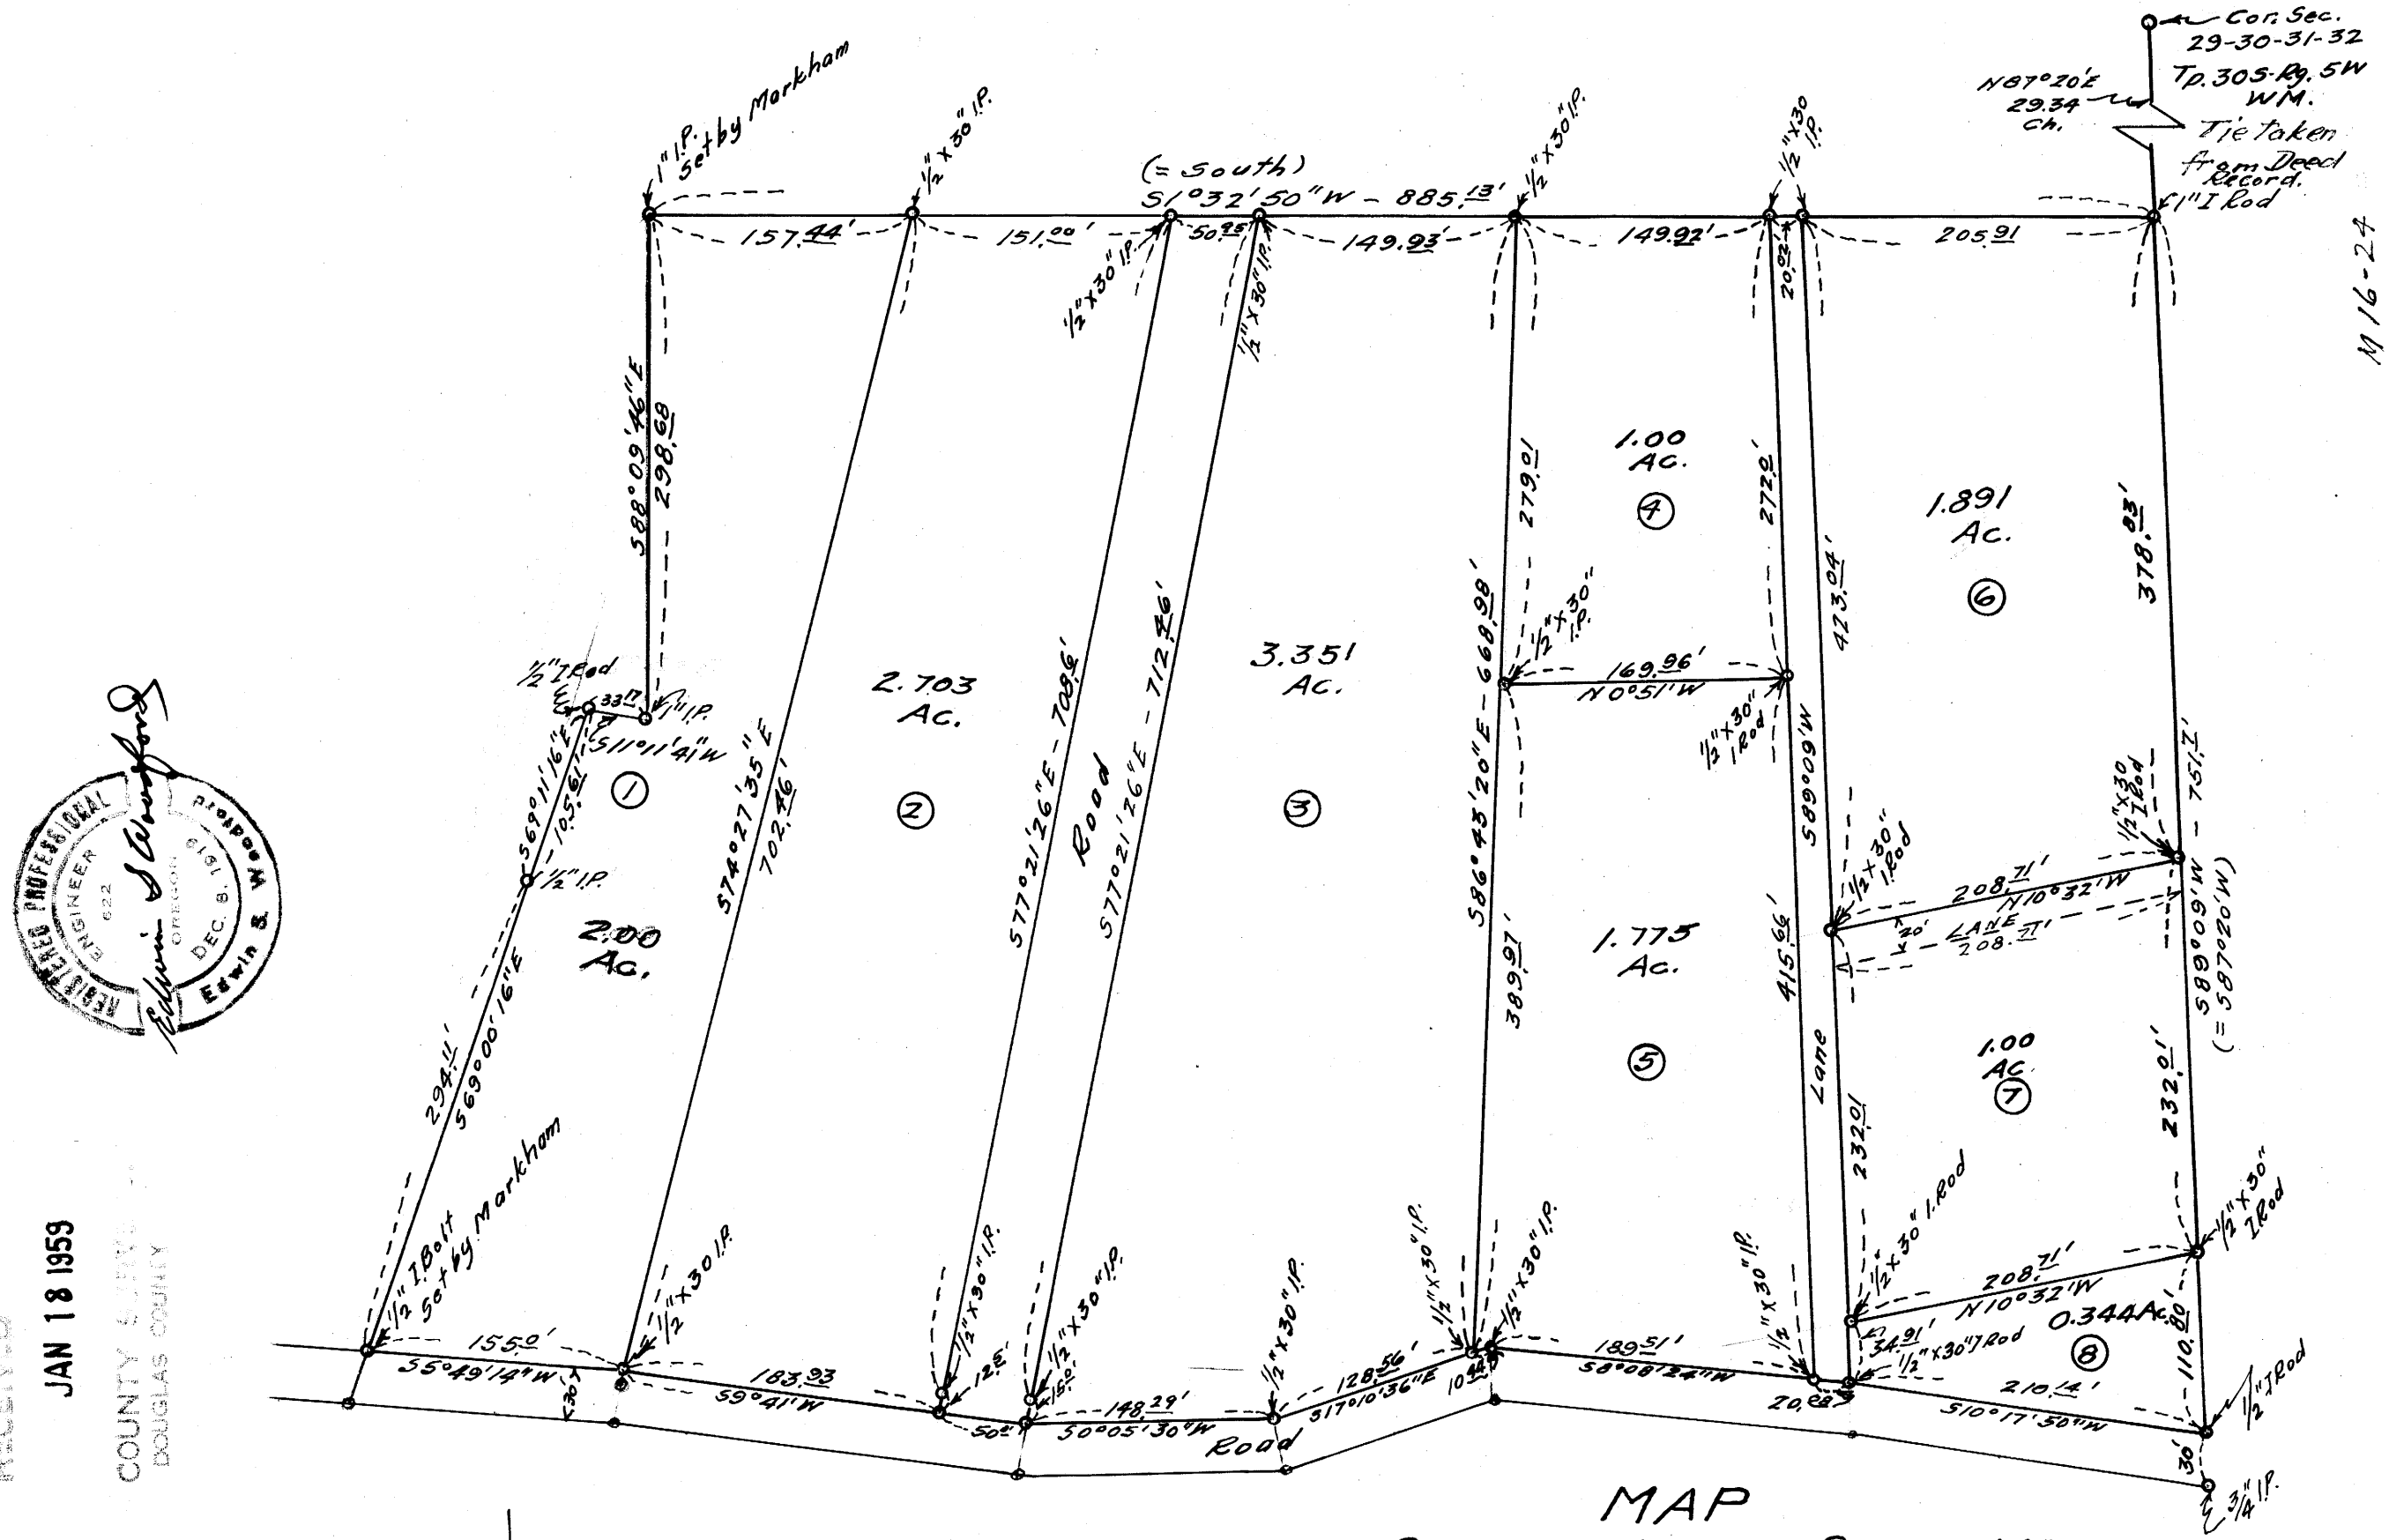

MAP
SHOWING LANDS SURVEYED FOR C. E DICKIE and ALBERT KITCHING IN SECTION 30 TP. 30S - RG. 5 W WM.

SCALE - 1" = 100' DEC. 1954.

C. S. File No. 42/99

M 16-24

(2)

REGISTERED PROFESSIONAL ENGINEER 622 OREGON Edwin S. Woodford DEC. 8, 1959

JAN 18 1959

FILED RECEIVED COUNTY SURVEYOR DOUGLAS COUNTY

C.S. File 42/99

Map File M16-24

COUNTY SURVEYORS FILE
DO NOT REMOVE FROM