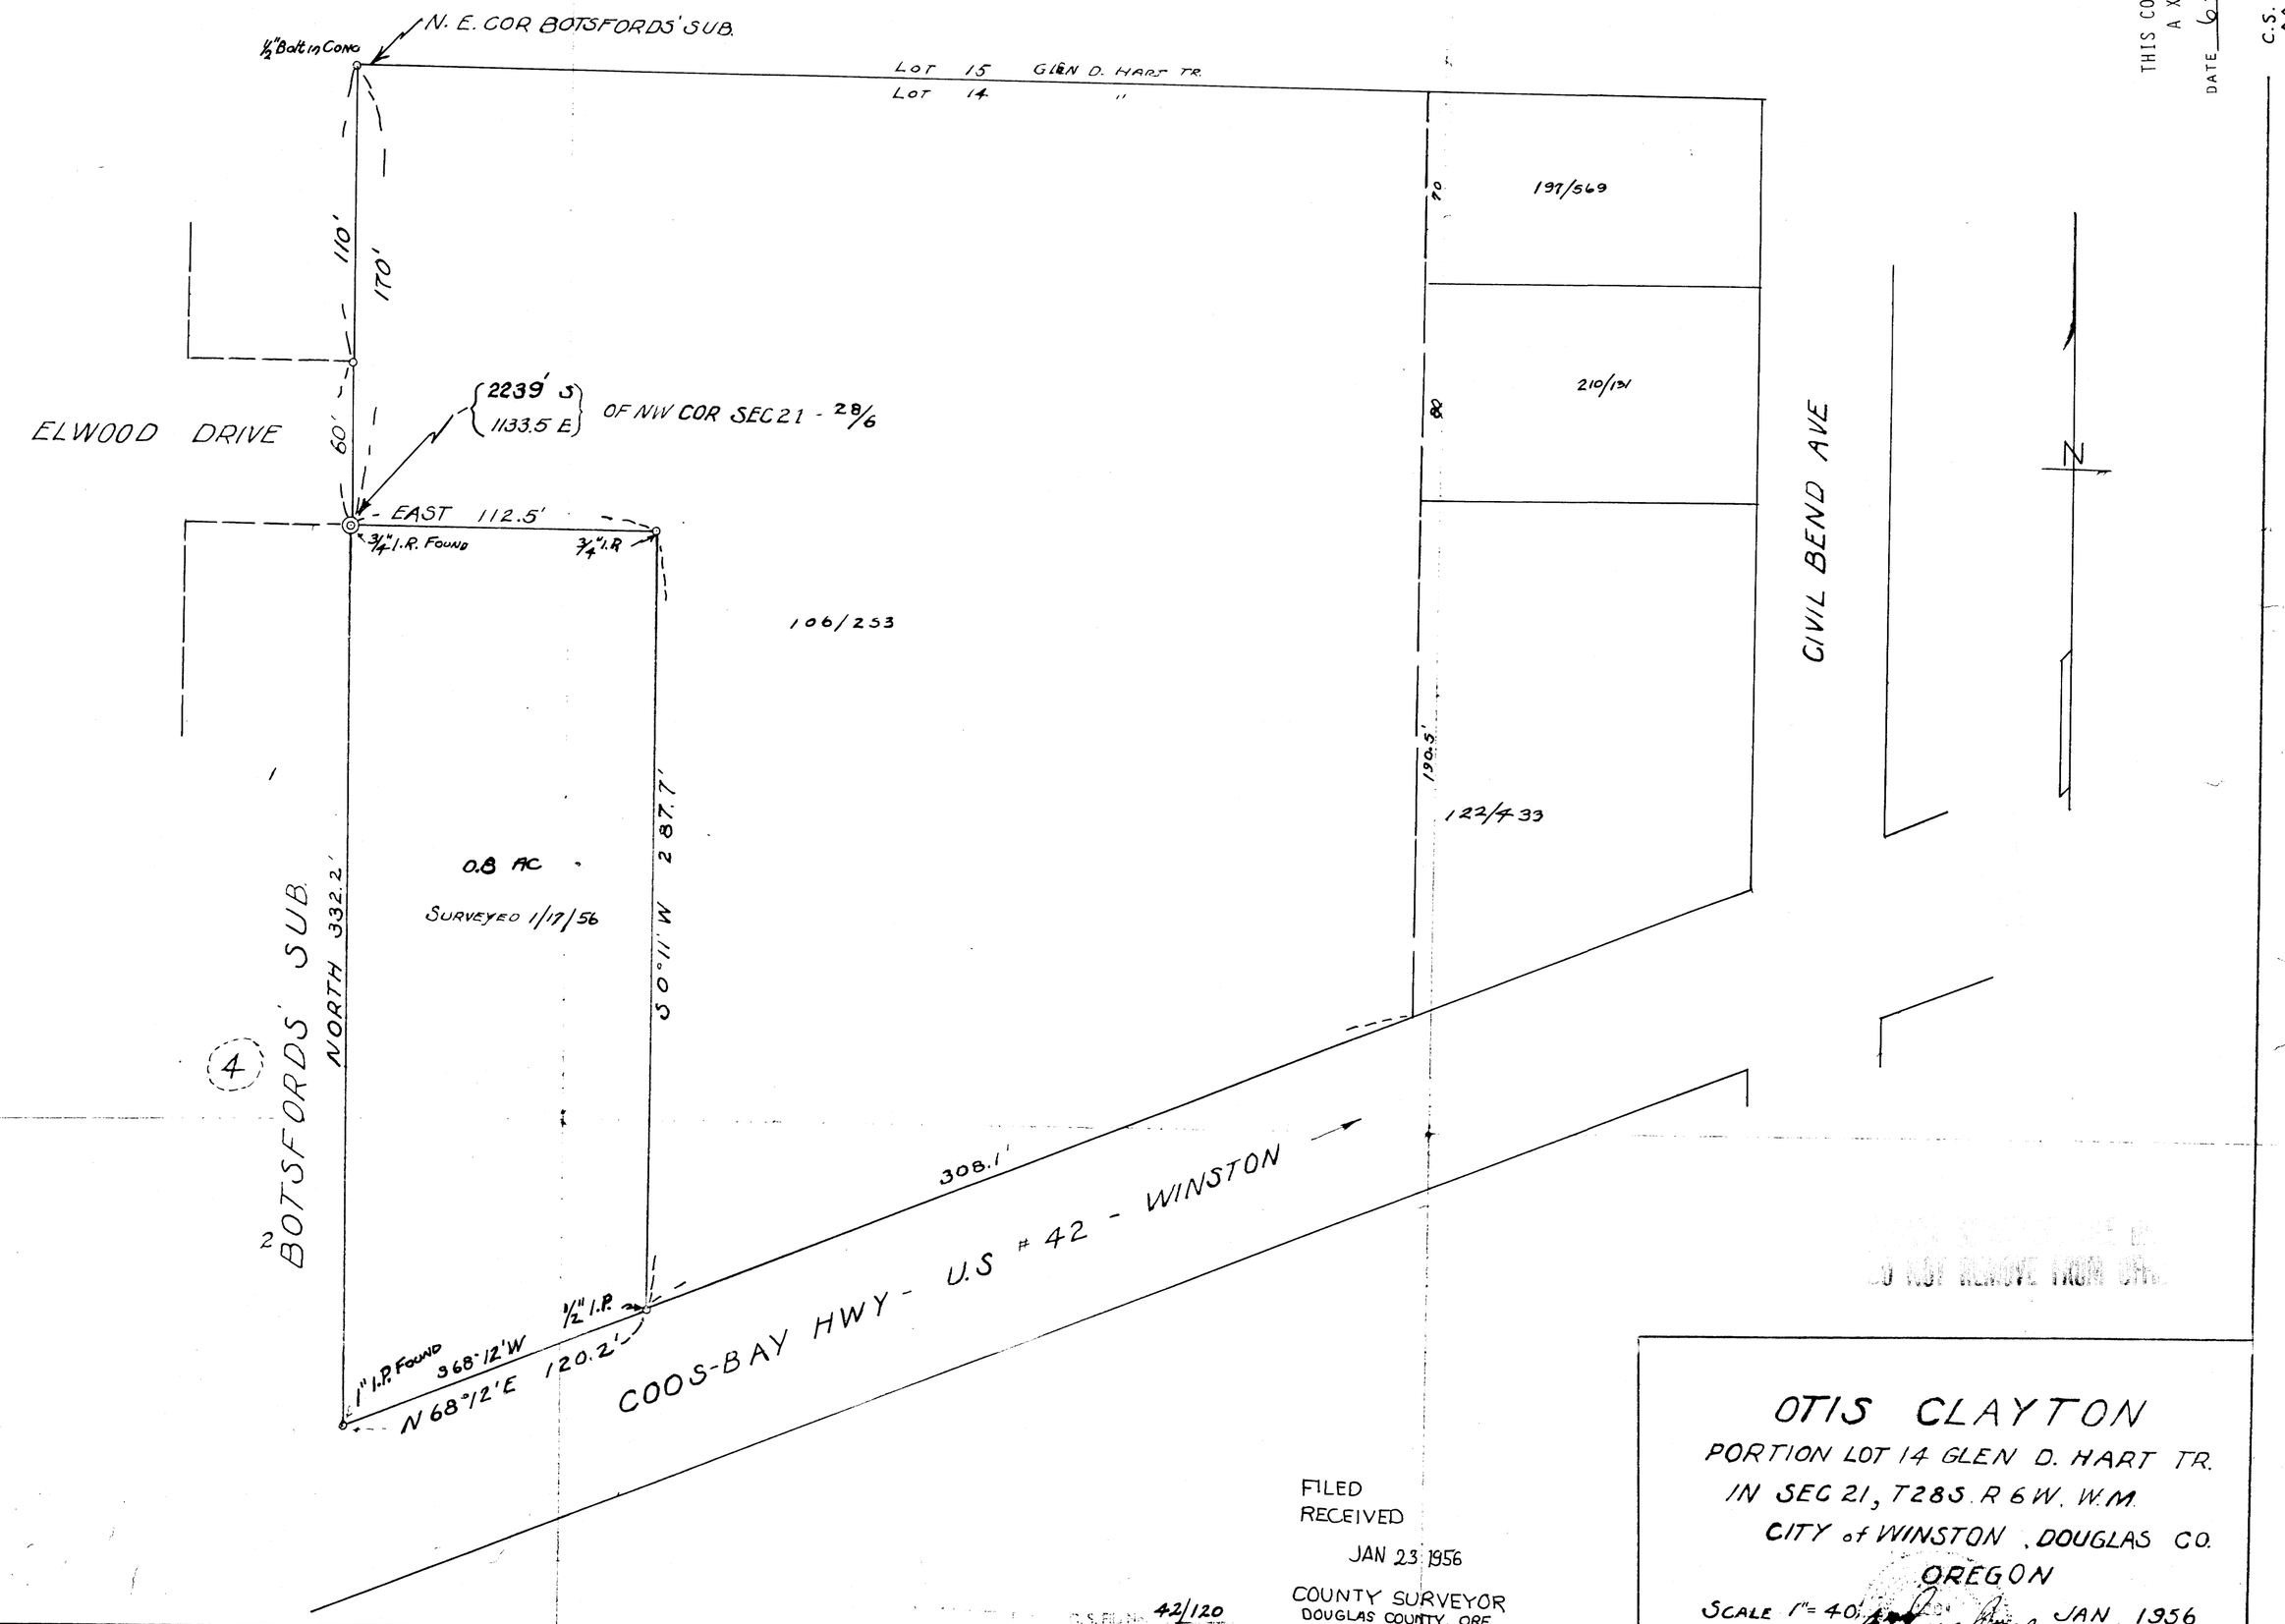

THIS COPY MADE FROM
A XEROX 2510
DATE 6-6-89

C.S. 42/120
M 16-26

DO NOT REMOVE FROM FILE

FILED
RECEIVED
JAN 23 1956
COUNTY SURVEYOR
DOUGLAS COUNTY, ORE.

C.S. FILING 42/120

OTIS CLAYTON

PORTION LOT 14 GLEN D. HART TR.
IN SEC 21, T28S. R 6W. W.M.
CITY of WINSTON, DOUGLAS CO.
OREGON

SCALE 1" = 40' JAN, 1956

H.N.

C.S. 42/120
M 16-26