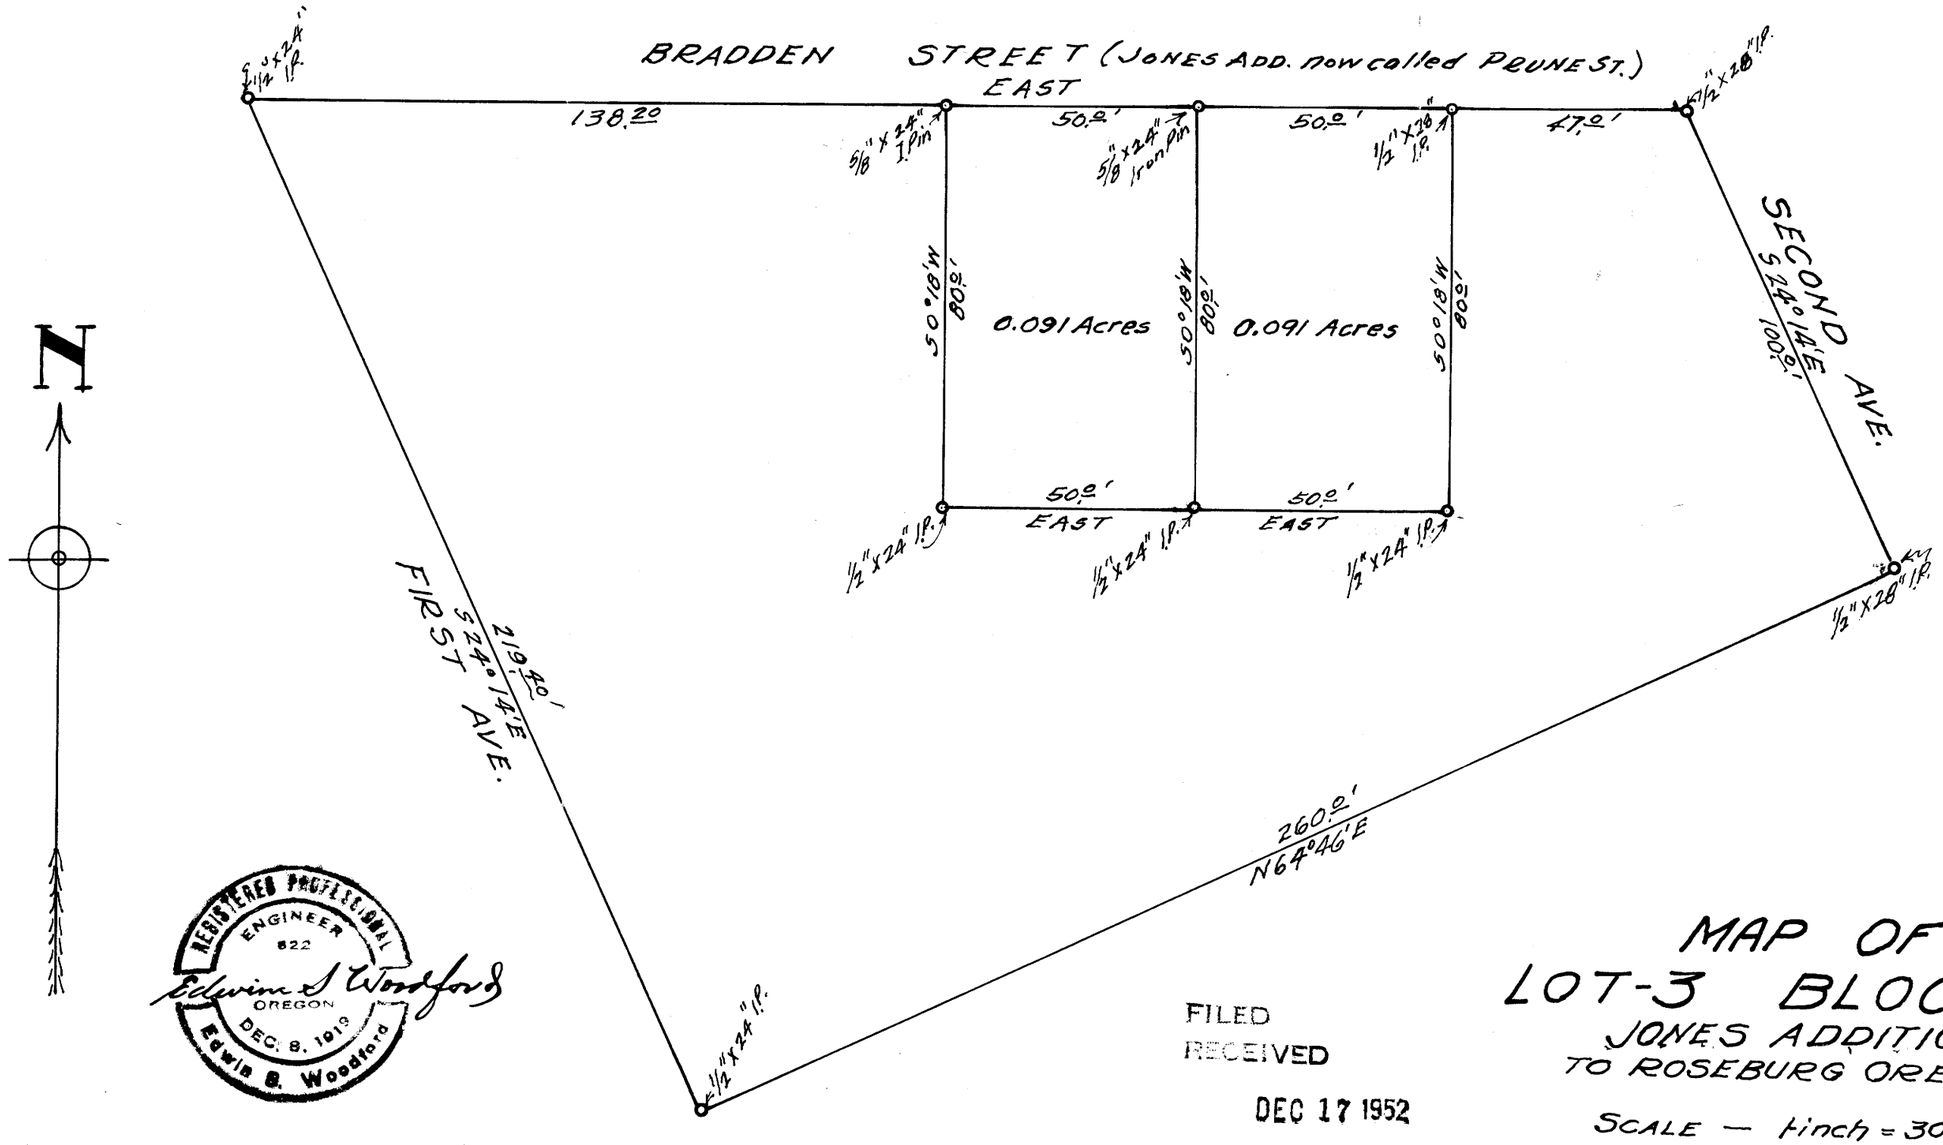

REGISTERED PROFESSIONAL ENGINEER 822 OREGON DEC. 8, 1919 Edwin B. Woodford

Edwin B. Woodford

FILED
RECEIVED
DEC 17 1952
COUNTY SURVEYOR
DOUGLAS COUNTY, ORE.

MAP OF LOT-3 BLOCK 13 JONES ADDITION TO ROSEBURG OREGON

SCALE — 1 inch = 30 ft

COUNTY SURVEYOR FILE
DO NOT REMOVE FROM OFFICE

41 / 99

M 16-31

(28a)

Map File M 16-31
41/99